PARCEL	INSTRUMENT	DATE	GRANTOR	GRANTEE	RECORDED CHARLETTON BOOK	PAGE	DATE	REMARKS
B.C.D.E	Q.C.D.	10-13-39	GEORGE & MARIE GEOFFROY	ST OF VT.	23	447	12-15-39	3 CULVERTS.

90E(1) 1940 6 56

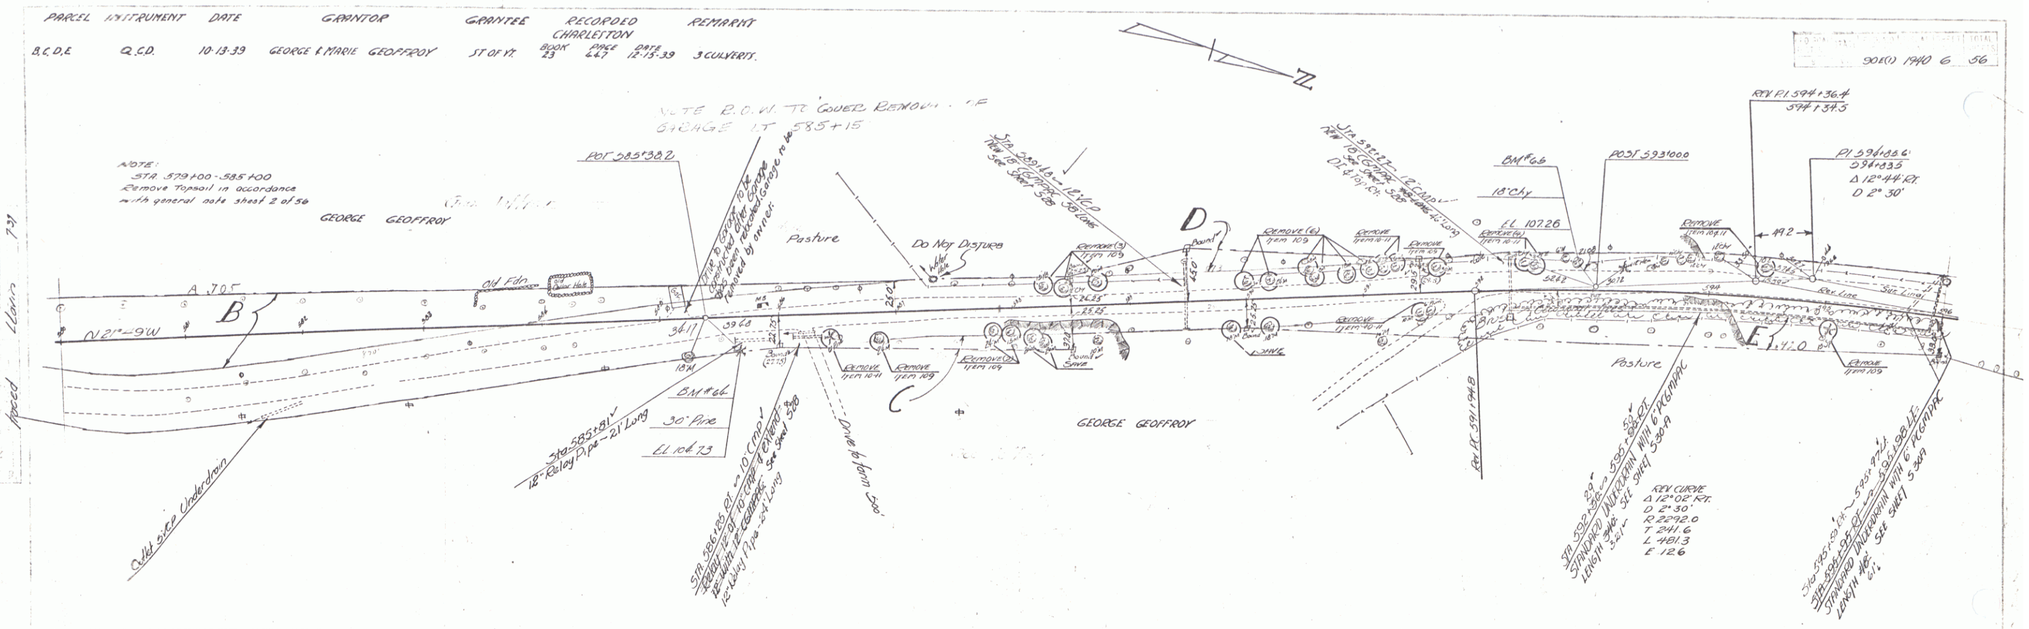

4