FED. ROAD DIST. NO.	STATE	FED. AID PROJ. NO.	FISCAL YEAR	SHEET NO.	TOTAL SHEETS
9	Vt	49	1923	8	28

GUARD RAIL REQUIRED

ON LEFT

Sta.	74+39	to sta	74+63	length	24 ft.
"	78+62	" "	79+66	"	104
"	84+88	" "	85+00	"	12

ON RIGHT

Sta	74+39	to	Sta 74+63	length	24 ft.
"	78+25	"	" 81+45	"	320
"	84+00	"	" 85+00	"	12

Total this Sheet 496

NEW CULVERTS REQUIRED

Sta 74+51 — 16" Corr. I. Pipe 30'
~~2.4~~ Concrete
1-2-4 " 1.3 ~~5.2~~ cu. yds.
~~1.25~~ " ~~7.0~~ " "
Earth Excav 1 " "

Sta 79+54 — ~~2.5~~ 2.3 Concrete
1-2-4 " ~~1.25~~ 1.8 cu. yds
1-2½-5 " 8.2 ~~7.0~~ " "
Earth Excav 63 " "

Sta 85+00 — 14" Corr Iron Pipe 32 ft
~~1.25~~ 1.0 Conc. Headwalls 1 cu. yd.
1-2-4 Earth Excav. 9 " "

SUB BASE REQUIRED

Sta 71+00	to	sta	~~77+50~~ 78+50	length	~~650~~ 750 ft.
" 81+50	"	"	85+00	"	350

Total this sheet ~~1000~~

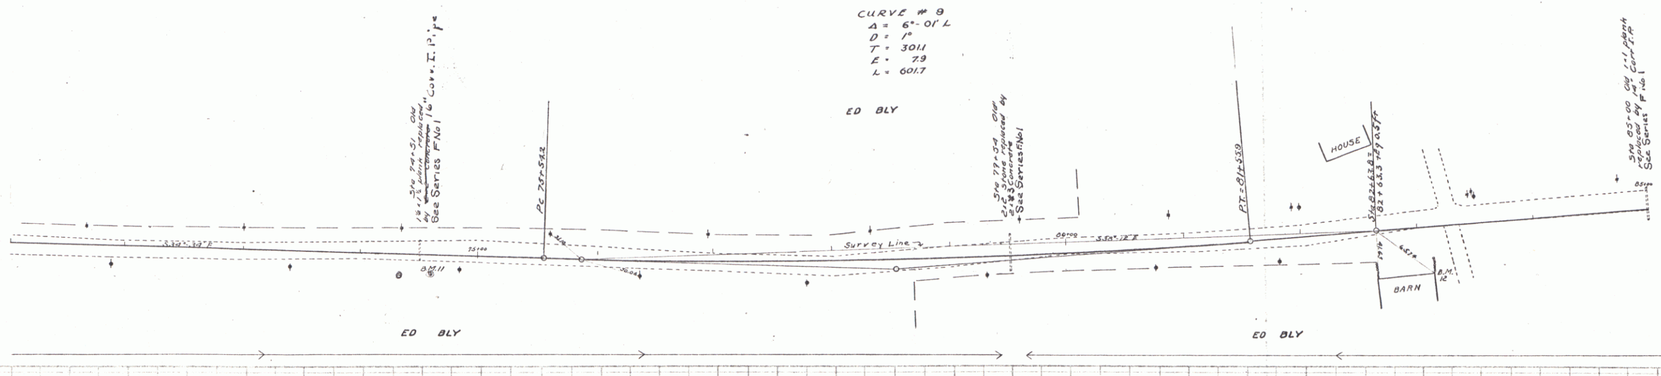

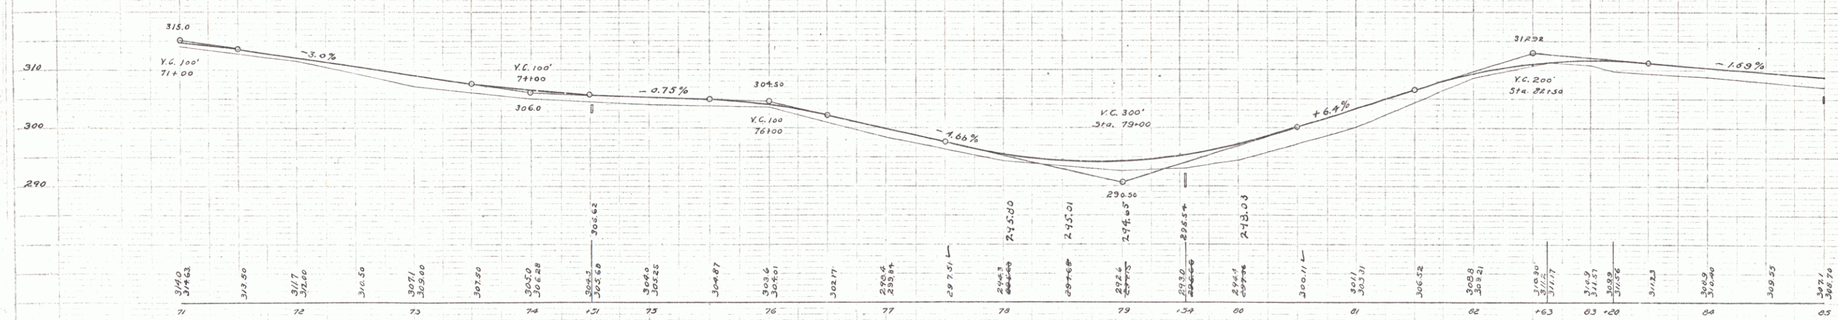

B.M. #11 Spike in 24" Maple Right of Sta 74+60 Elev. 303.43
B.M. #12 Tap of Stone N.E. corner of Barn Right of Sta. 83+13 Elev. 314.79

Series F No. 49 Filed
Sheet 8 of 28

7