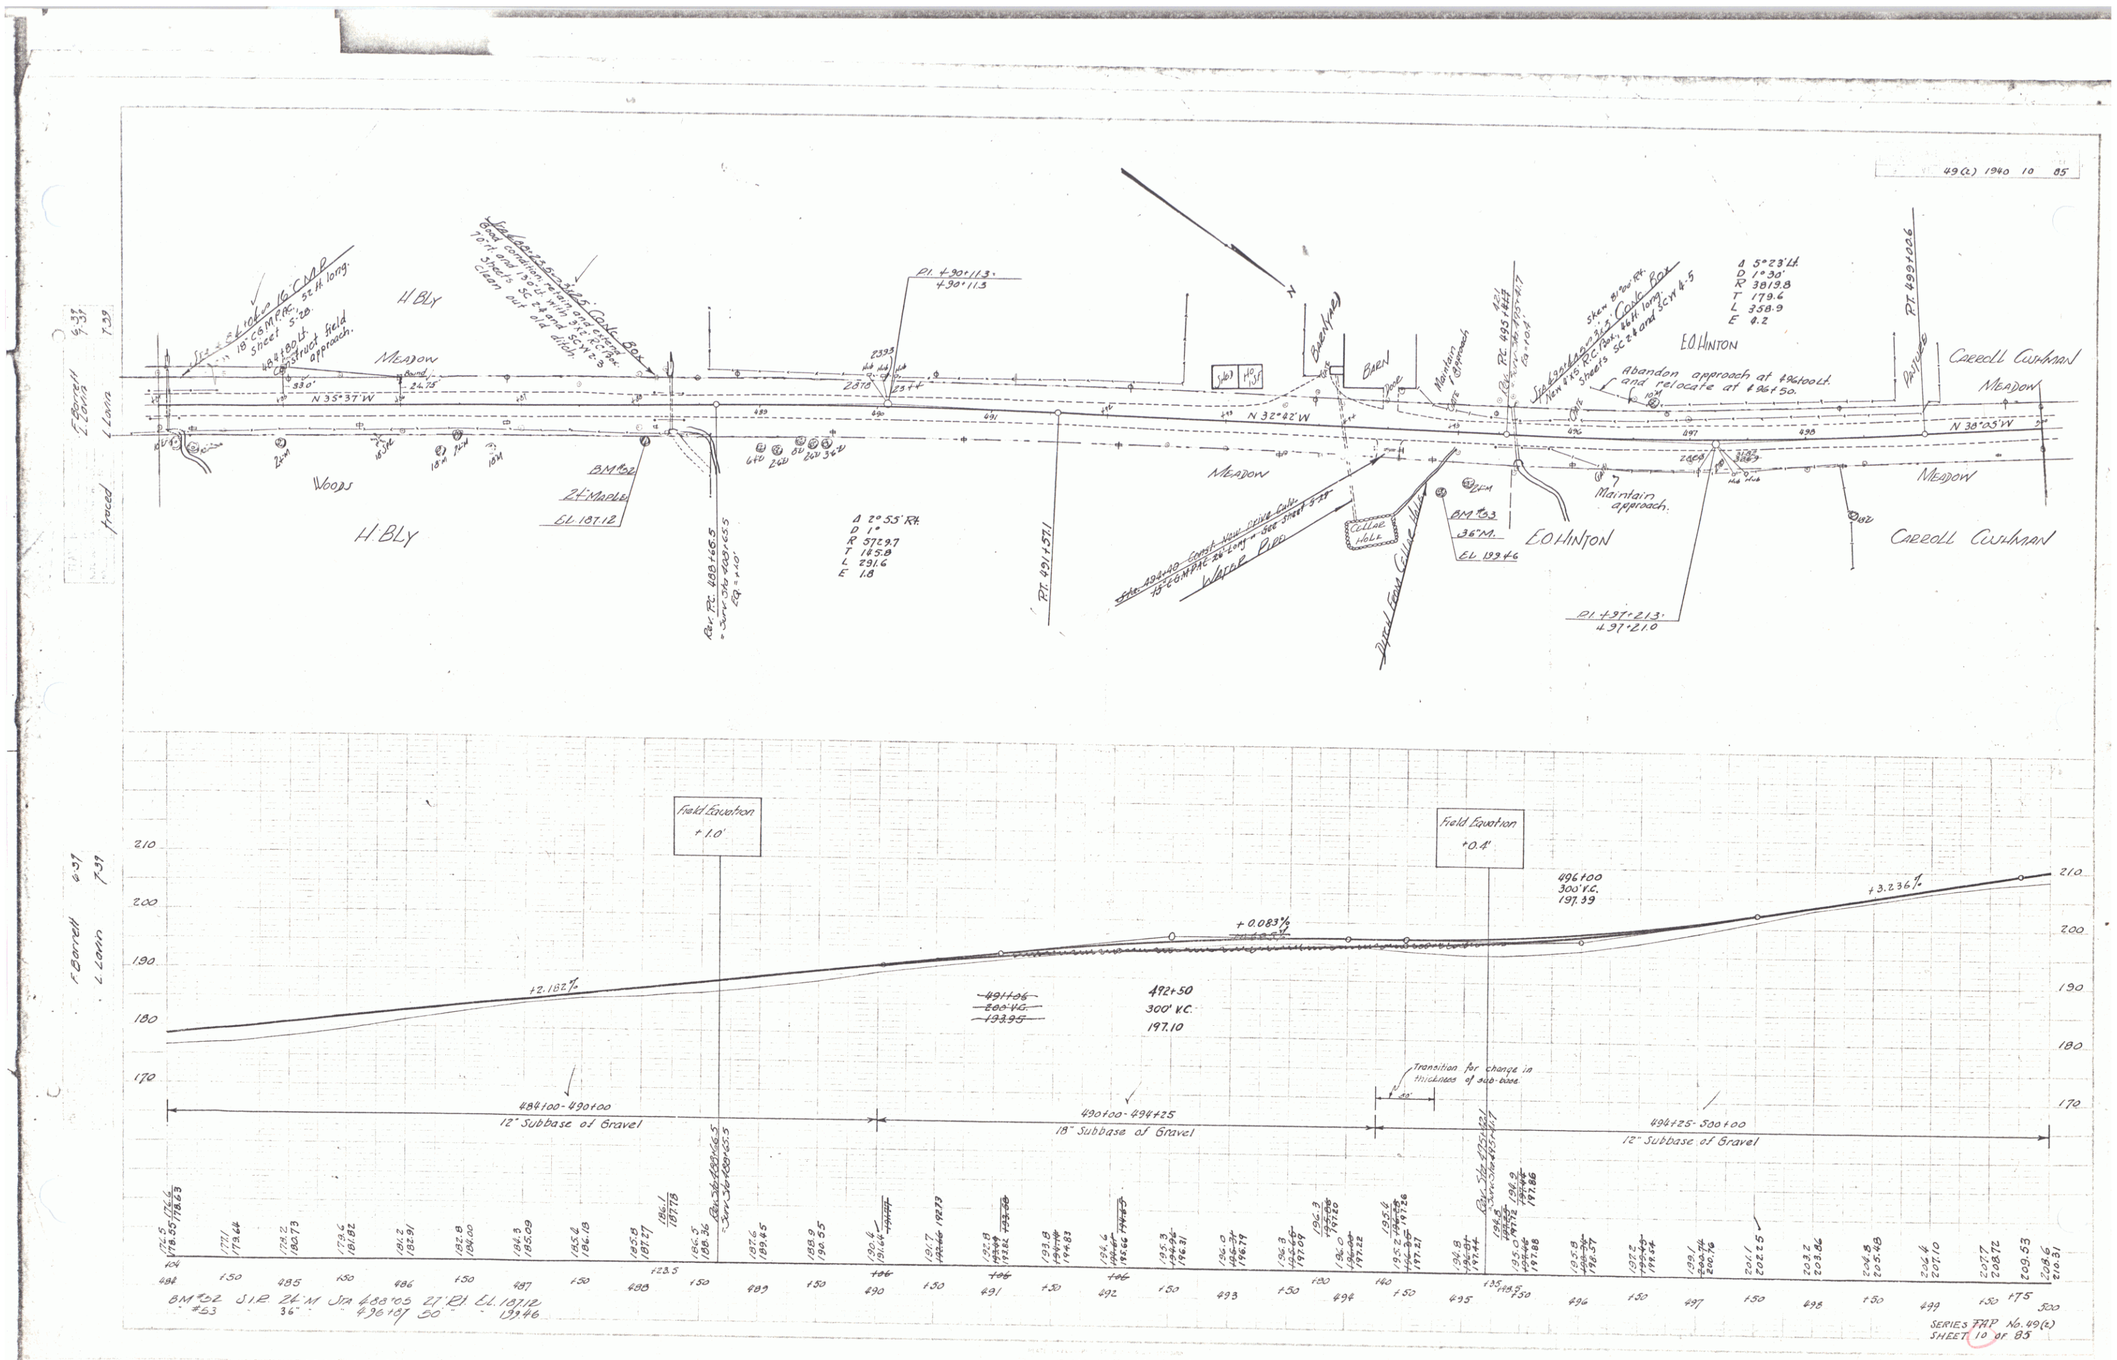
49(2) 1940 10 85
H BLY
MEADOW
WOODS
N 35°37' W
N 32°32' W
N 38°03' W
BARN
EO HINTON
CARROLL CUSHMAN
Δ 5°23' Lt.
D 1°30'
R 3819.8
T 179.6
L 358.9
E 8.2
Δ 2°55' Rt.
D 1°
R 5729.57
T 145.8
L 291.6
E 1.8
Maintain approach.
Field Equation +1.0'
Field Equation +0.4'
+2.182%
+0.083%
+3.236%
492+50
300' V.C.
197.10
496+00
300' V.C.
197.39
Transition for change in thickness of sub-base.
484+00-490+00
12" Subbase of Gravel
490+00-494+25
18" Subbase of Gravel
494+25-500+00
12" Subbase of Gravel
SERIES FAP No. 49(2)
SHEET 10 OF 85

8