89E(1)1940 4 21

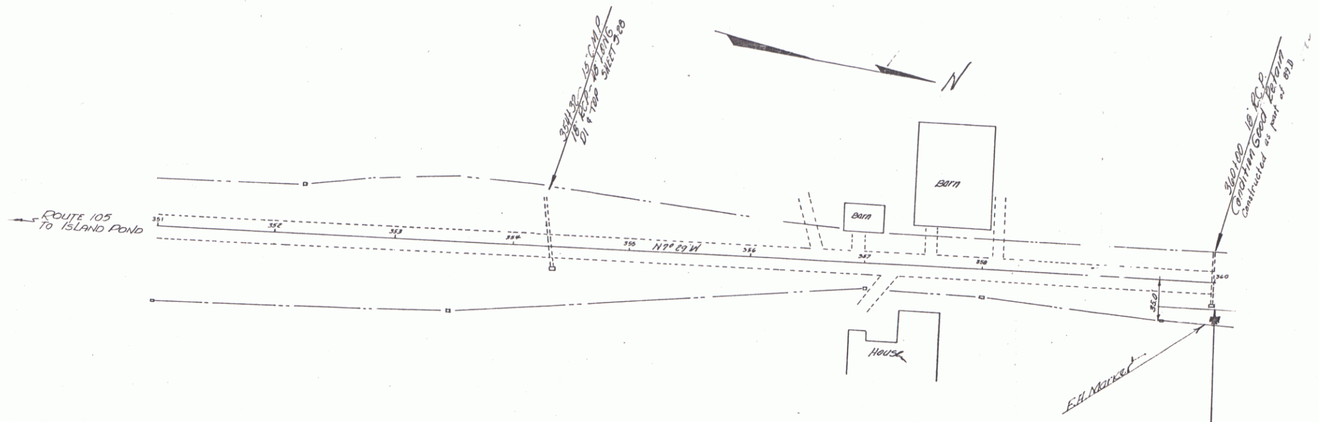

SERIES FAP - No. 89-E (1)
SHEET 4 OF 21

2