FED. ROAD DIST. NO.	STATE	FED. AID PROJ. NO.	SECT.	SUPP. NO.	SHEET NO.
2	VT	890	1939	3	58

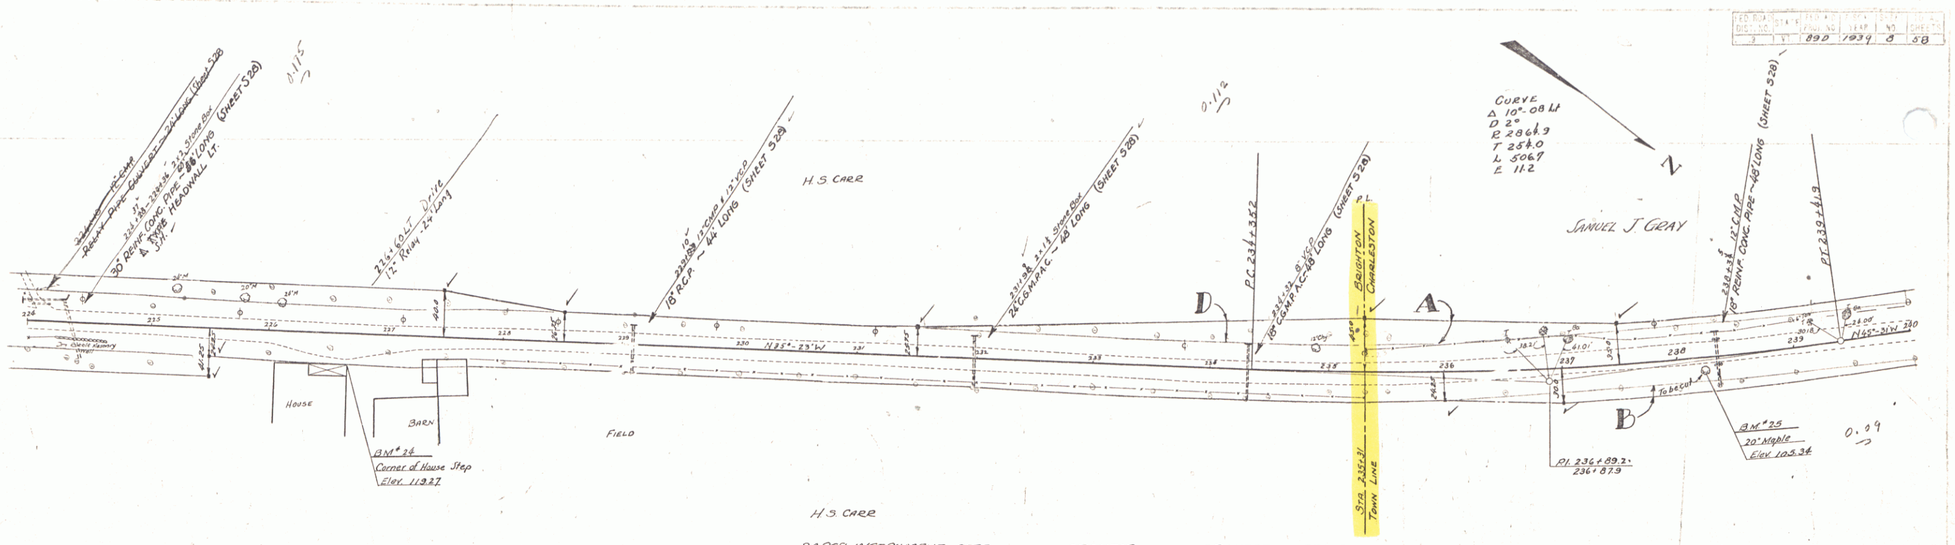

H.S. CARR

PARCEL	INSTRUMENT	DATE	GRANTOR	GRANTEE	RECORDED BRIGHTON BOOK	PAGE	DATE	REMARKS
D	Q.C.D.	4/26/38	H.S. CARR & MRS. IVA FINLEY	ST. OF VT.	20	52.58	4/28/38	SAMUEL J. GRAY
A-B	Q.C.D.	6/4/38	SAMUEL J. GRAY	ST. OF VT.	CHARLESTON BOOK 23	PAGE 430	DATE 6/7/38	

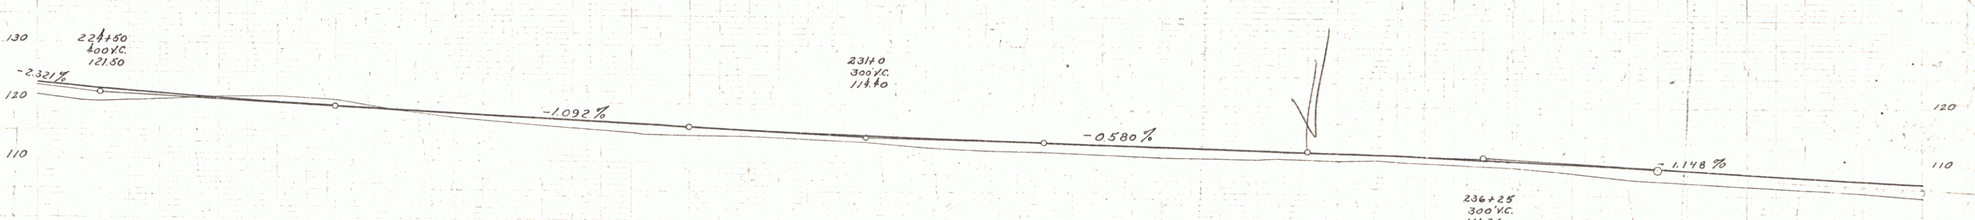

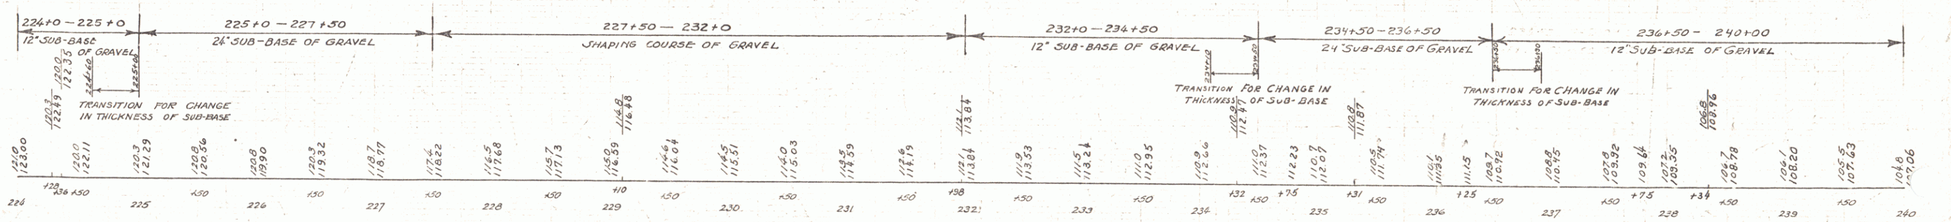

BM #24 SPOT ON CONC. STEP 26' FT RT OF STA 226+66 ELEV. 119.27
BM #25 SPIKE IN ROOT OF 20" MAPLE 8 FT RT OF STA. 238+22 ELEV. 105.34

Series FAP 89D Sheet 5 of 58 Sheets

5