


PLAN
DATE: _____
BY: _____
CHECKED BY: _____
SCALE: _____

PROFILES
DATE: _____
BY: _____
CHECKED BY: _____
SCALE: _____

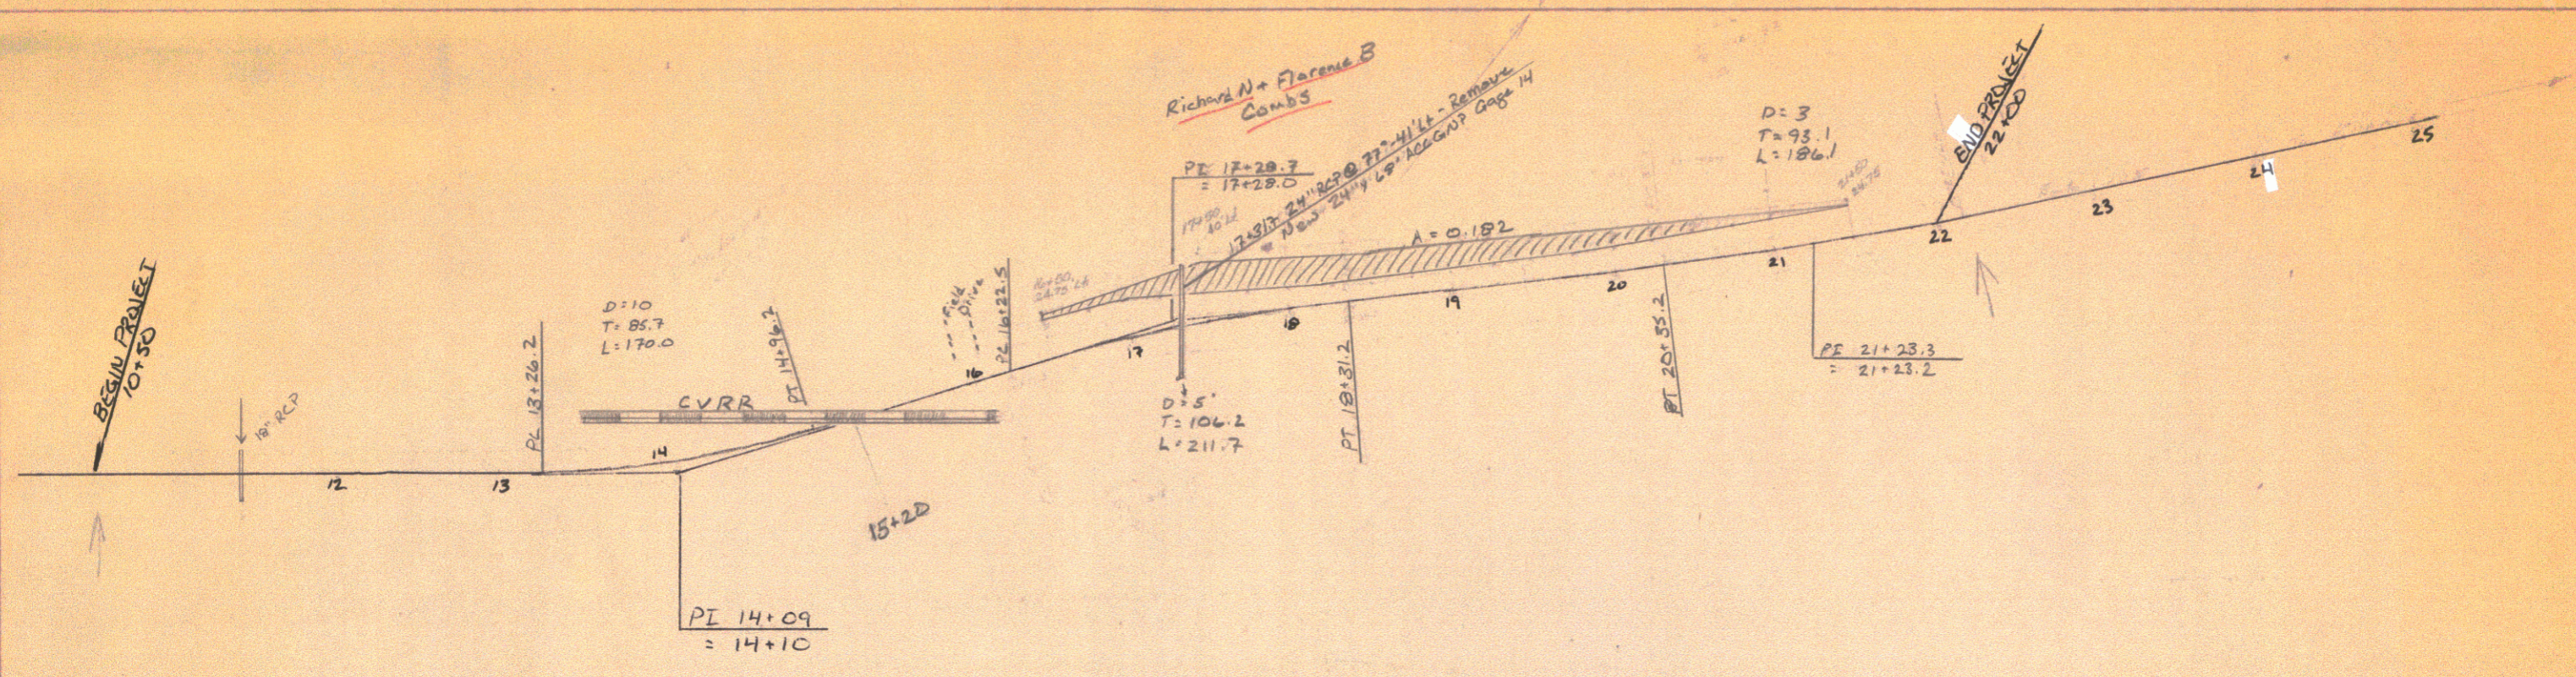

Berkshire
BP 034-1-7113
SHEET (2)