Excavation & Removal of Road Surfaces and/or Pavements, Item 119
50+75 Lt. - 55+85 Lt.
56+50 Lt. - 58+15 Lt.

Guide Posts - Item 547.B
56+00 Lt. (2)
56+10 Lt. (2)

Construct Drives
Sta. 56+69 Lt. +18
Sta. 61+50 Lt.
Sta. 61+50 Rt.
Sta. 33+50 Lt.
64+00 Lt.

Construct Approach
Sta. 63+50 Rt.

Stone Fill for Slope Protection, (Light Type) - Item 512
Rt.
65+40 - 65+90

Three Cable Guard Rail W/steel posts, Item 512
Sta. 51+26 - 51+76 Lt. 51+43.9 - 51+72.4 Rt.
Sta. 51+26 - 51+76 Rt. Lt.
Sta. 65+93 - 66+00 Rt.
+20.4

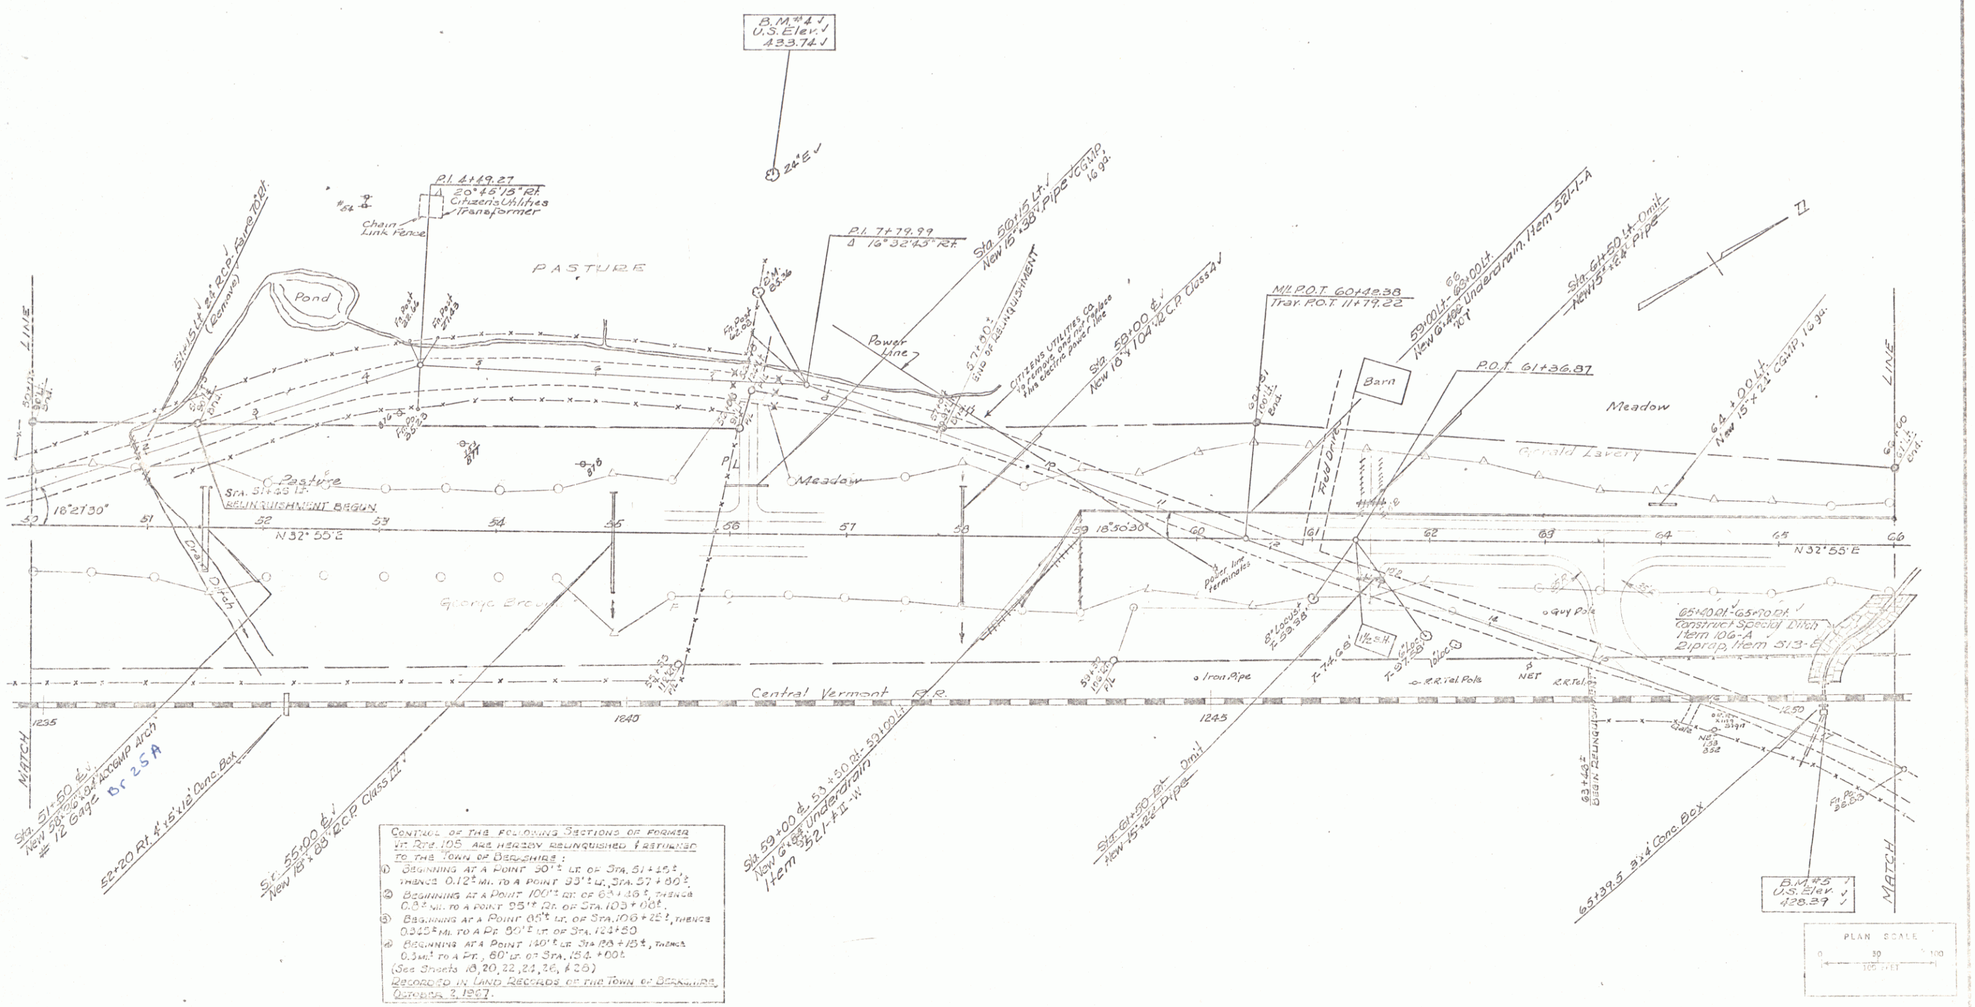

CONTROL OF THE FOLLOWING SECTIONS OF FORMER VT. RTE. 105 ARE HEREBY RELINQUISHED & RETURNED TO THE TOWN OF BERKSHIRE:

1. BEGINNING AT A POINT 30'± LT. OF STA. 51+25±, THENCE 0.12± MI. TO A POINT 33'± LT., STA. 57+80±.
2. BEGINNING AT A POINT 100'± RT. OF 63+46±, THENCE 0.8± MI. TO A POINT 95'± RT. OF STA. 103+00±.
3. BEGINNING AT A POINT 60'± LT. OF STA. 108+25±, THENCE 0.325± MI. TO A PT. 90'± LT. OF STA. 124+50
4. BEGINNING AT A POINT 140'± LT. STA. 138+15±, THENCE 0.3± MI. TO A PT., 60'± LT. OF STA. 154+00±

(See Sheets 18, 20, 22, 24, 26, & 28)

RECORDED IN LAND RECORDS OF THE TOWN OF BERKSHIRE OCTOBER 2, 1967.

BERKSHIRE
F-FG-031-1(1)

Sheet 16 of 132 Sheets

4