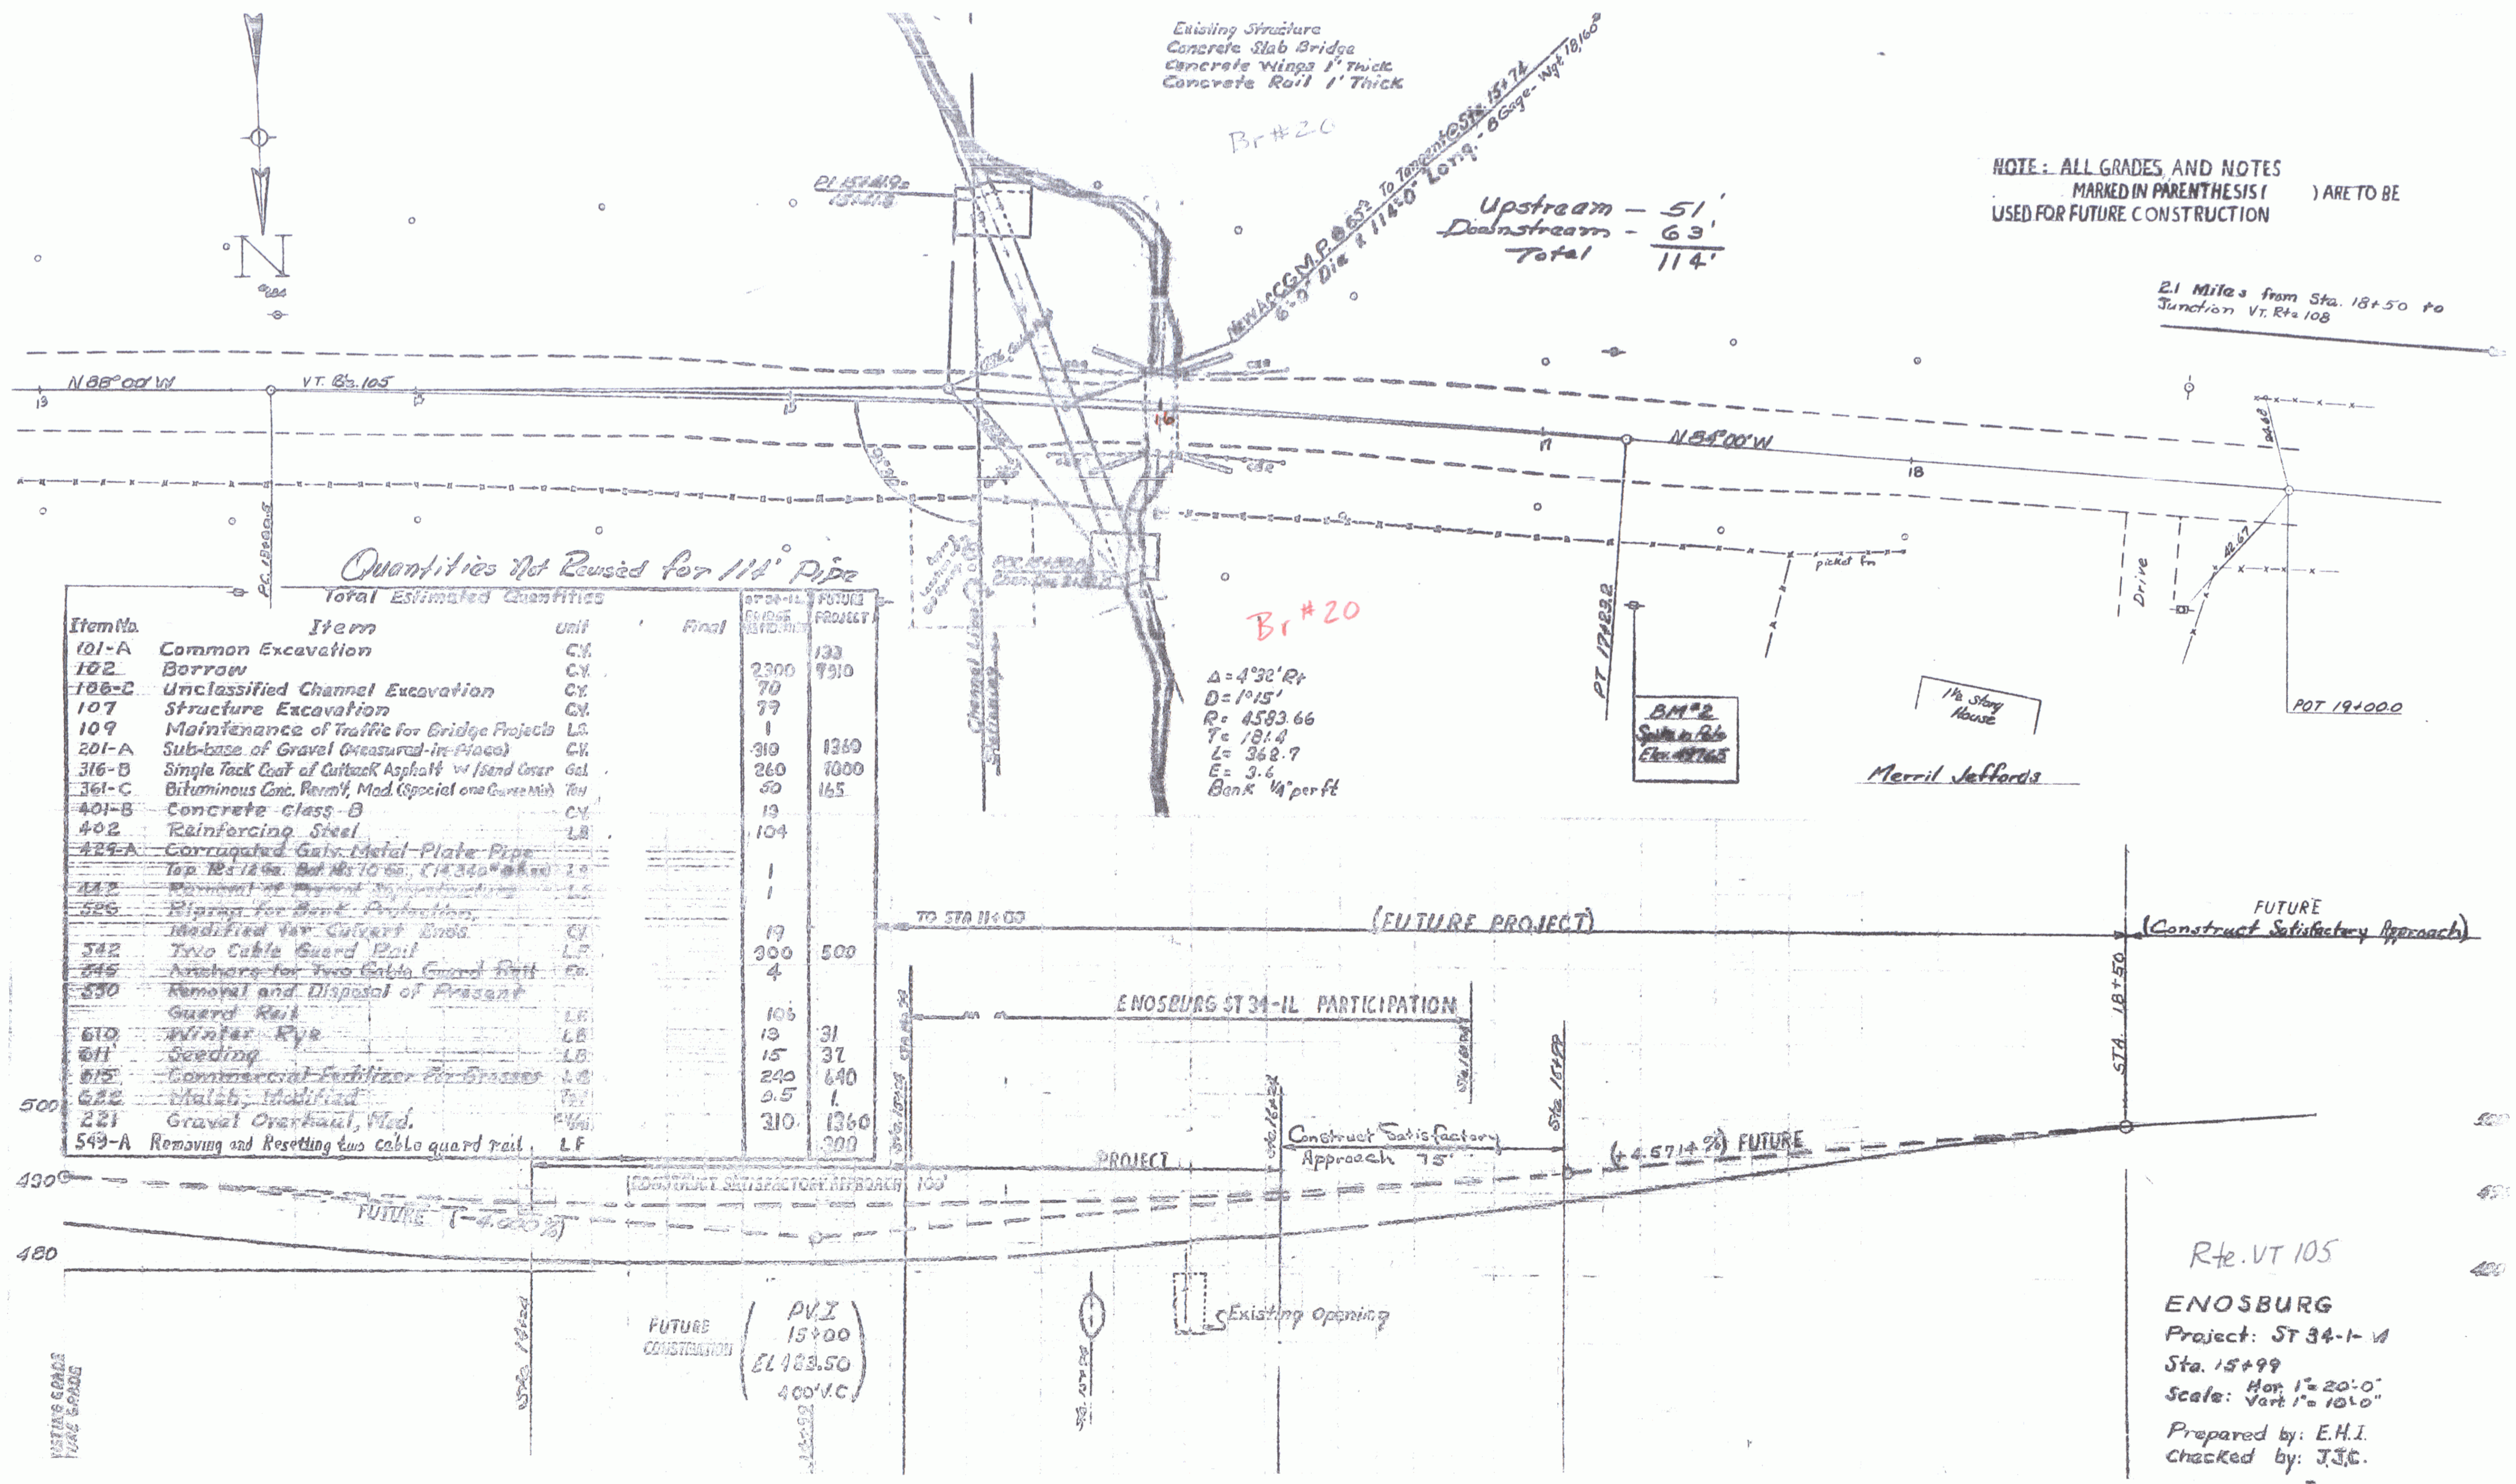

Quantities Not Reused for 114' Pipe

Total Estimated Quantities

Item No.	Item	Unit	Final	ST 34-IL Bridge	Future Project
101-A	Common Excavation	C.Y.			133
102	Borrow	C.Y.		2300	7910
106-C	Unclassified Channel Excavation	C.Y.		70	
107	Structure Excavation	C.Y.		79	
109	Maintenance of Traffic for Bridge Projects	L.S.		1	
201-A	Sub-base of Gravel (Measured-in-Place)	C.Y.		310	1360
316-B	Single Tack Coat of Cutback Asphalt w/Sand Cover	Gal.		260	1000
361-C	Bituminous Conc. Pavm't, Mod. (Special one Course Mix)	Ton		50	165
~~401-B~~	~~Concrete class B~~	C.Y.		13	
402	Reinforcing Steel	LB.		104	
~~429-A~~	~~Corrugated Galv. Metal Plate Pipe~~				
	~~Top [illegible]~~	L.S.		1	
~~442~~	~~Removal of Present Superstructure~~	L.S.		1	
~~526~~	~~Riprap for Bank Protection,~~				
	~~Modified for Culvert Ends~~	C.Y.		19	
542	Two Cable Guard Rail	L.F.		300	500
~~545~~	~~Anchors for Two Cable Guard Rail~~	Ea.		4	
~~550~~	~~Removal and Disposal of Present~~				
	~~Guard Rail~~	L.F.		106	
610	Winter Rye	LB.		13	31
611	Seeding	LB.		15	37
~~615~~	~~Commercial Fertilizer for Grasses~~	LB.		240	640
~~622~~	~~Mulch, Modified~~	Ton		0.5	1.
221	Gravel Overhaul, Mod.	C.Y./Mi.		310	1360
549-A	Removing and Resetting two cable guard rail	L.F.			300

Rte. VT 105

ENOSBURG

Project: ST 34-1-(1)

Sta. 15+99

Scale: Hor. 1" = 20'-0", Vert. 1" = 10'-0"

Prepared by: E.H.I.

Checked by: J.J.C.

SHEET 2

2