


FED. ROAD DIST. NO.	STATE	PROJ. NO.	FISCAL YEAR	SHEET NO.	TOTAL SHEETS
9	Vt.			2	8

DATE	BY
PLAN	PROF.
NOTED	NOTED
NOTE BOOK	ALSO CHECKED
NO.	NO.

DATE	BY
PROFILE	PROF.
NOTED	NOTED
NOTE BOOK	ALSO CHECKED
NO.	NO.

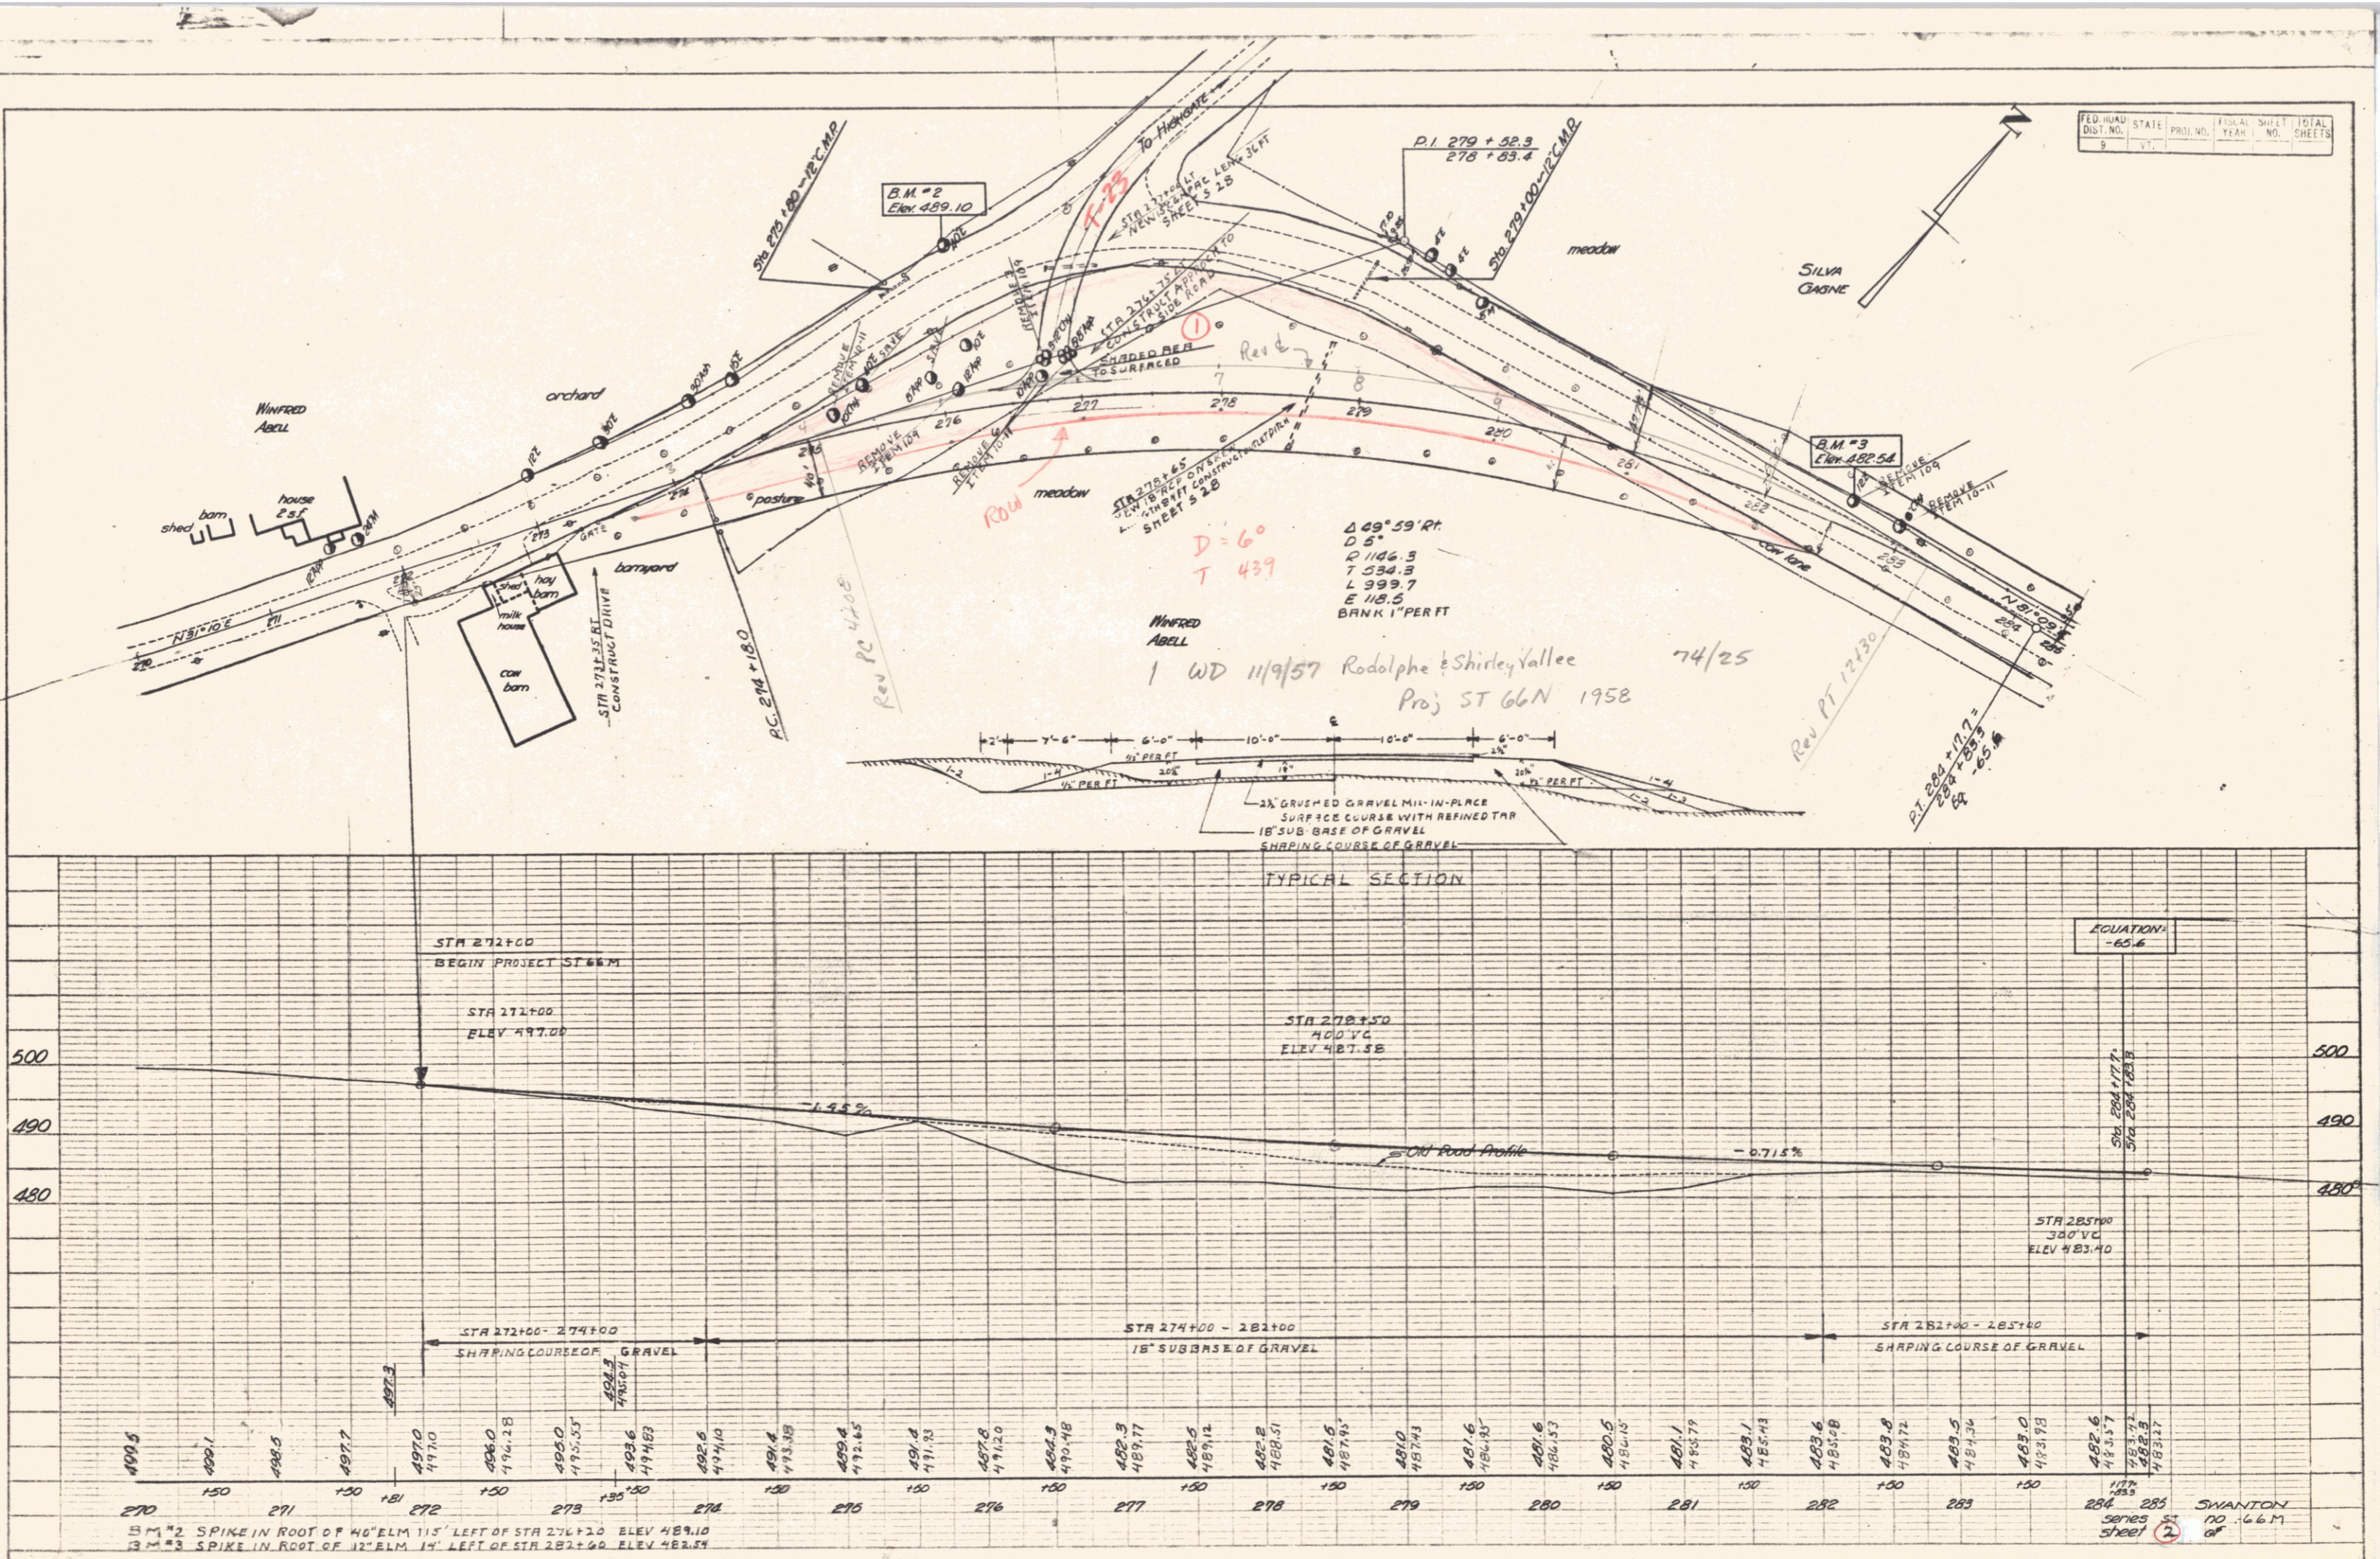

1 WD 11/9/57 Rodolphe & Shirley Yaliec
 Proj ST 66N 1958

$D = 60$
 $T = 439$
 BANK 1 PER FT

TYPICAL SECTION

1" #2 SPIKE IN ROOT OF W^o ELM 115' LEFT OF STA 274+2.0 ELEV 489.10
 3" #3 SPIKE IN ROOT OF 12" ELM 14' LEFT OF STA 282+6.0 ELEV 482.54

SWANTON
 Series 51
 sheet 2 of 8