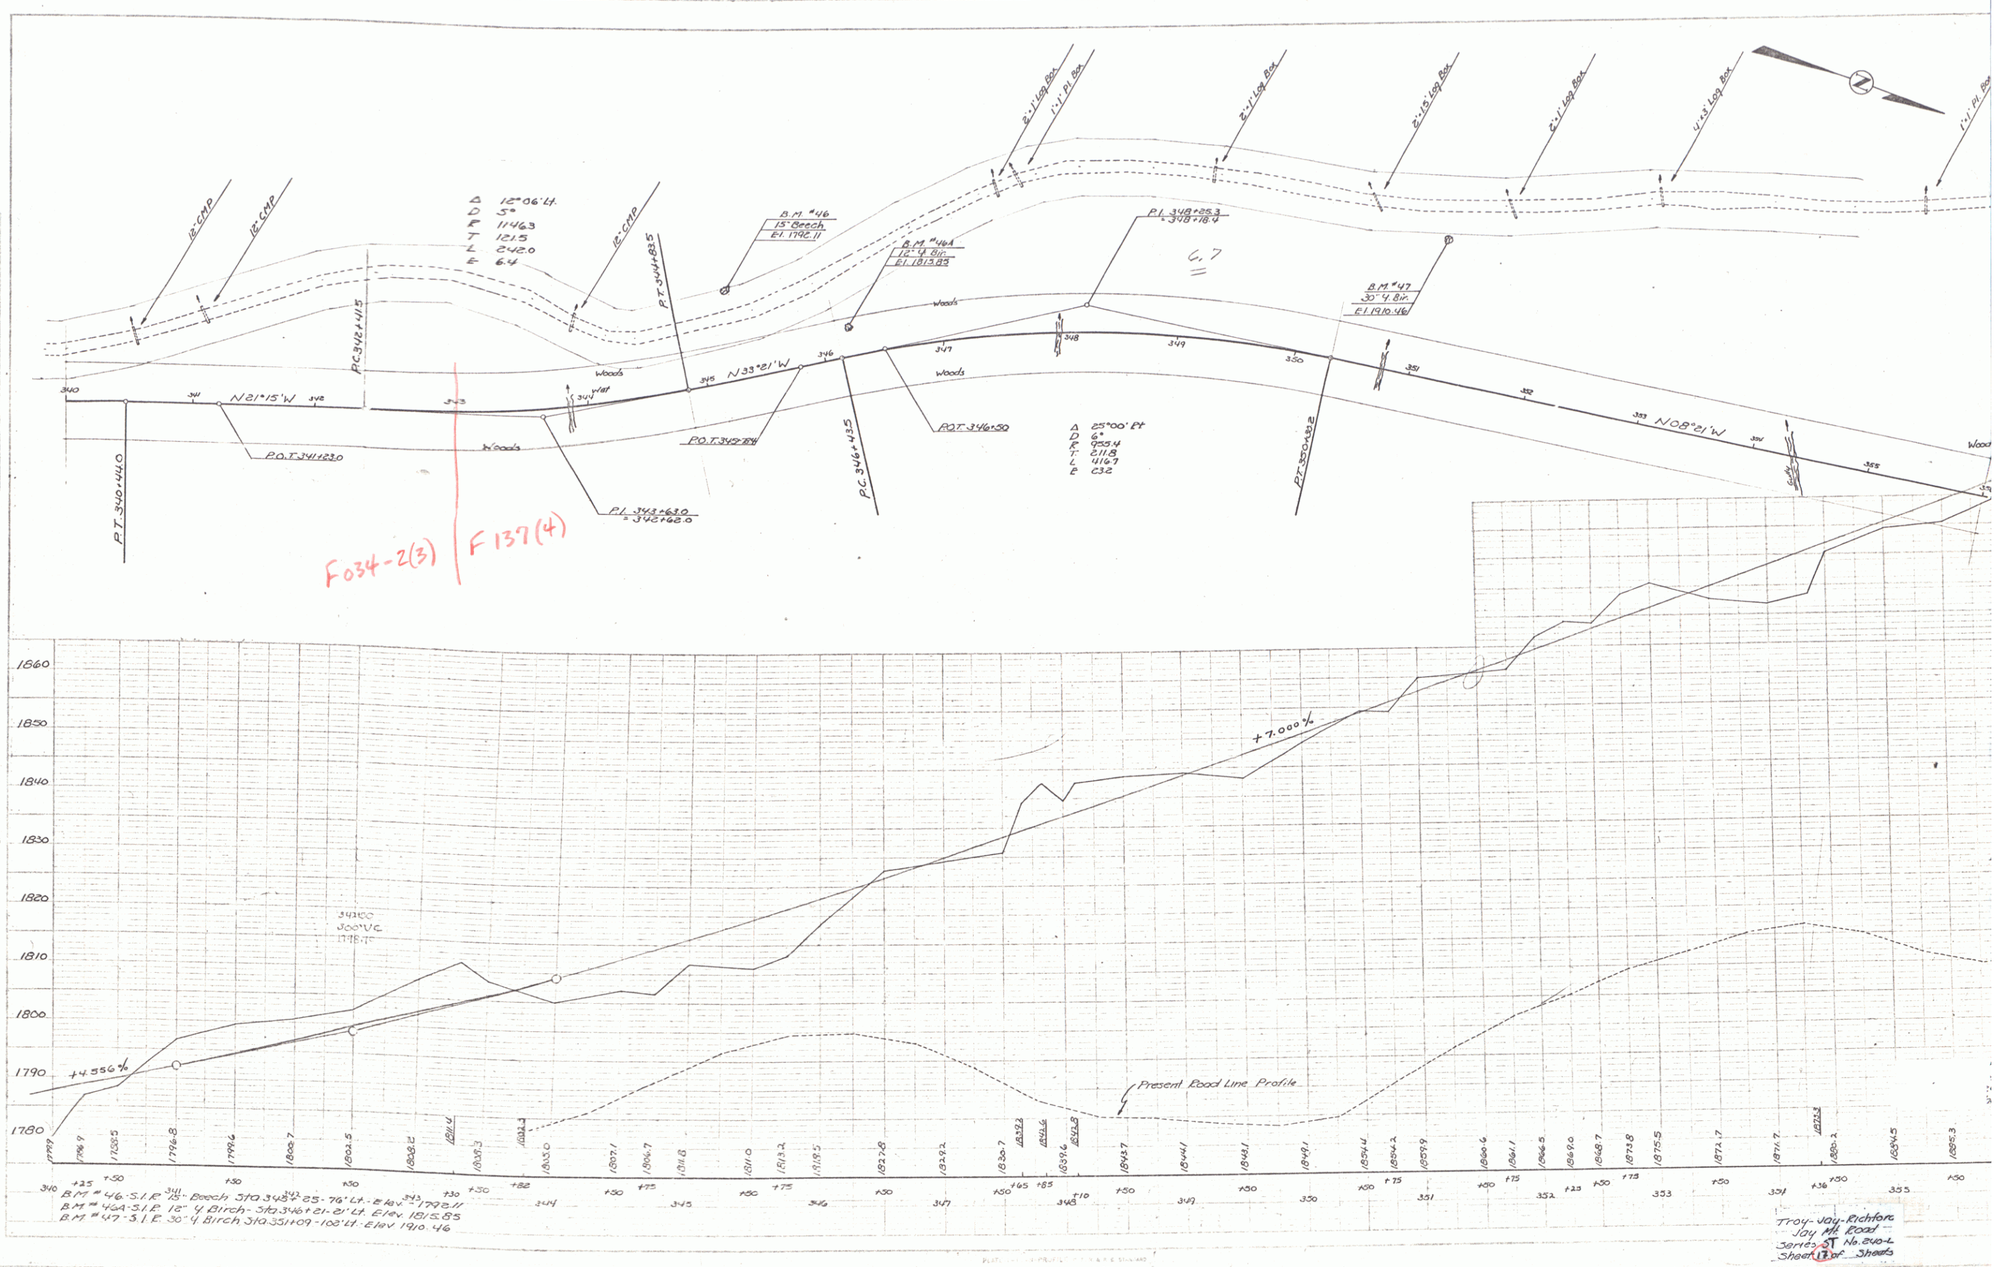
Δ 12°06'44"
D 5°
R 1146.3
T 121.5
L 242.0
E 6.4
12" CMP
P.T. 340+44.0
P.C. 341+41.5
P.T. 344+83.5
P.O.T. 341+23.0
P.I. 343+63.0 = 342+68.0
P.C. 346+43.5
P.O.T. 346+50
P.I. 348+85.3 = 348+78.4
P.T. 350+68.2
B.M. #46 15" Beech El. 1792.11
B.M. #46A 12" Y. Birch El. 1815.85
B.M. #47 30" Y. Birch El. 1910.46
2'-1' Log Box
1'-1' Pl. Box
2'-1.5' Log Box
4'-1.5' Log Box
N21°15'W
N33°21'W
N08°21'W
Woods
Δ 25°00' Rt
D 6°
R 955.4
T 211.8
L 416.7
E 23.2
F034-2(3)
F137(4)
+4.556%
+7.000%
Present Road Line Profile
Troy-Jay-Richford
Jay Mt. Road
Series ST No. 8404
Sheet 17 of Sheets
B.M. #46-S.I.E. 15" Beech Sta. 343+25-76' Lt.-Elev. 1792.11
B.M. #46A-S.I.E. 12" Y. Birch-Sta. 346+21-21' Lt. Elev. 1815.85
B.M. #47-S.I.E. 30" Y. Birch Sta. 351+09-102' Lt.-Elev. 1910.46

17