FED. ROAD DIST. NO.	STATE	FED. AID PROJECT NO.	FISCAL YEAR	SHEET NO.
9	VT	E-137-L.	1932	

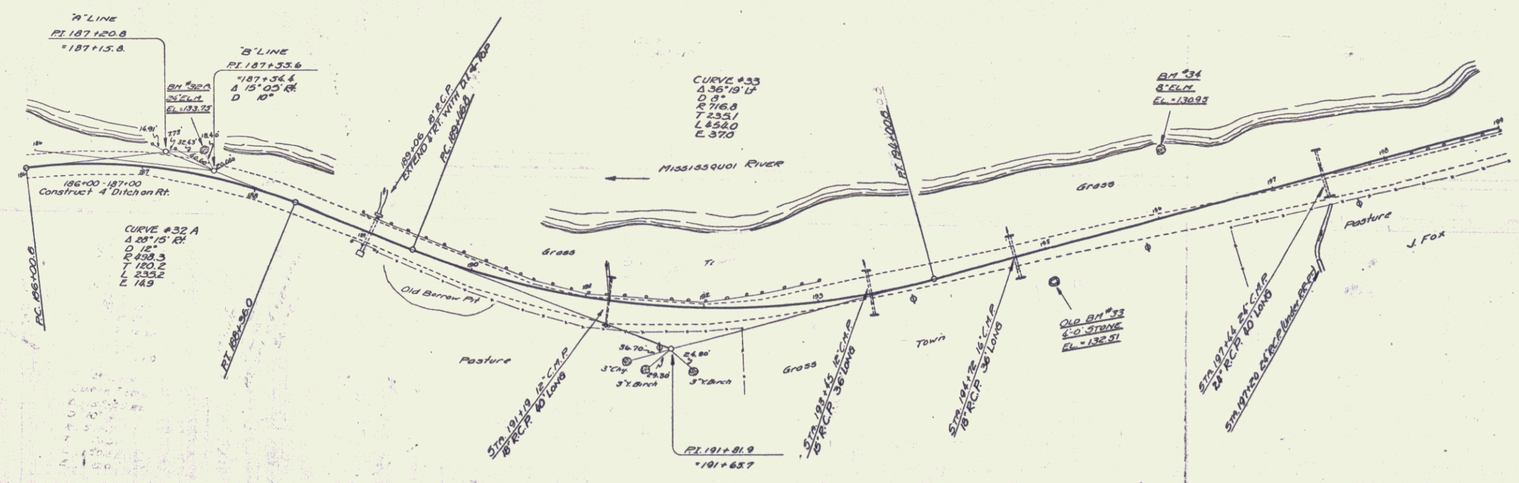

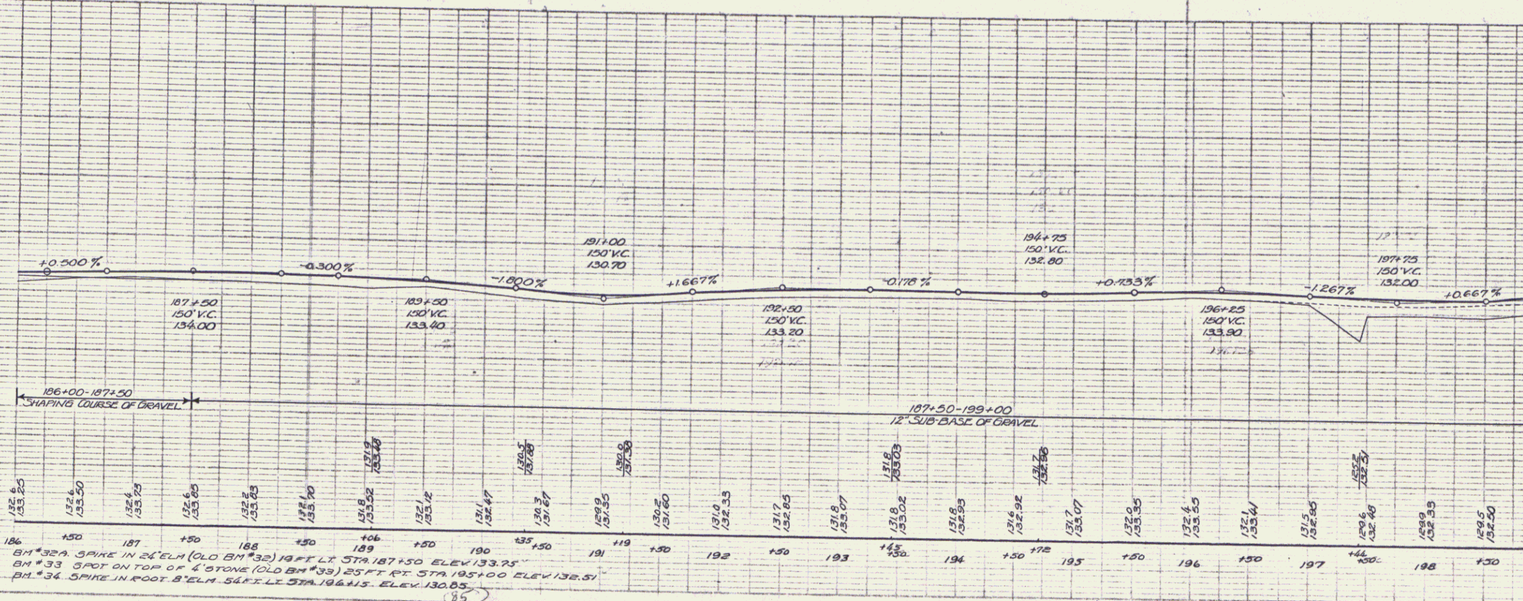

BM #32A. SPIKE IN 26" ELM (OLD BM #32) 19 FT. LT. STA. 187+50 ELEV 133.75'
BM #33 SPOT ON TOP OF 5' STONE (OLD BM #33) 25 FT. RT. STA. 195+00 ELEV 132.51'
BM. #34. SPIKE IN ROOT 8" ELM. 54 FT. LT. STA. 196+15. ELEV. 130.85

SERIES E-137 L.
SHEET 4 OF

5