E137-A 1932 4 10

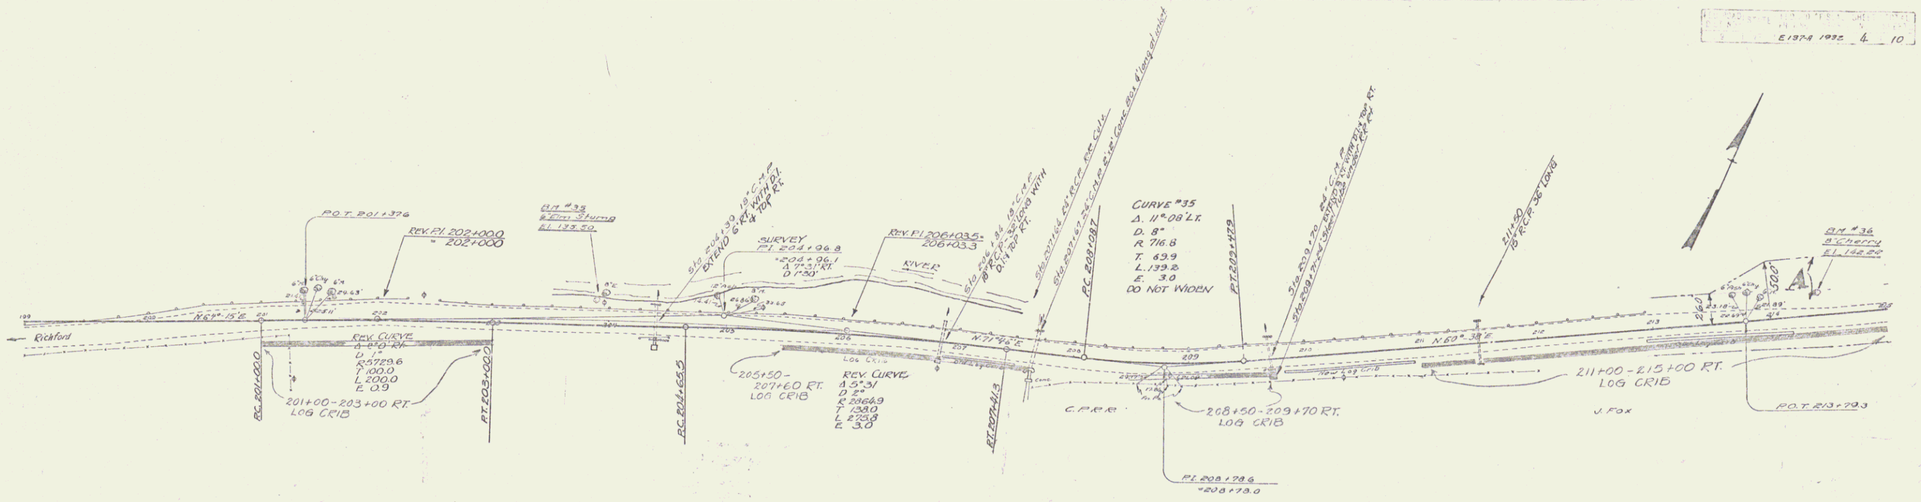

PARCEL	INSTRUMENT	DATE	GRANTOR	GRANTEE	RECORDED RICHFORD		REMARKS
A	Q.C.D.	12-12-32	Wm & BERTHA BLAIR	ST. OF VT.	BOOK 37	PAGE 16	DATE 12-12-32

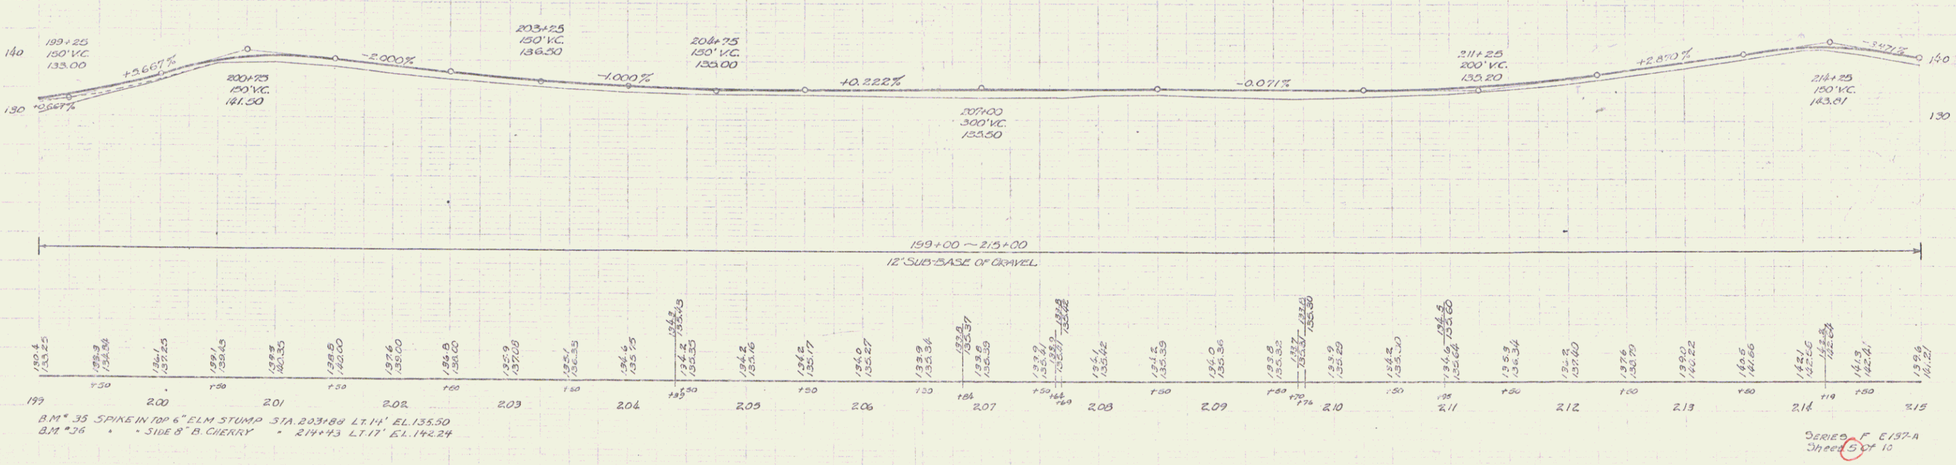

B.M. #35 SPIKE IN TOP 6" ELM STUMP STA. 203+88 LT. 14' EL. 135.50
B.M. #36 " " SIDE 8" B. CHERRY " 214+43 LT. 17' EL. 142.24

SERIES F E137-A
Sheet 5 of 10

2