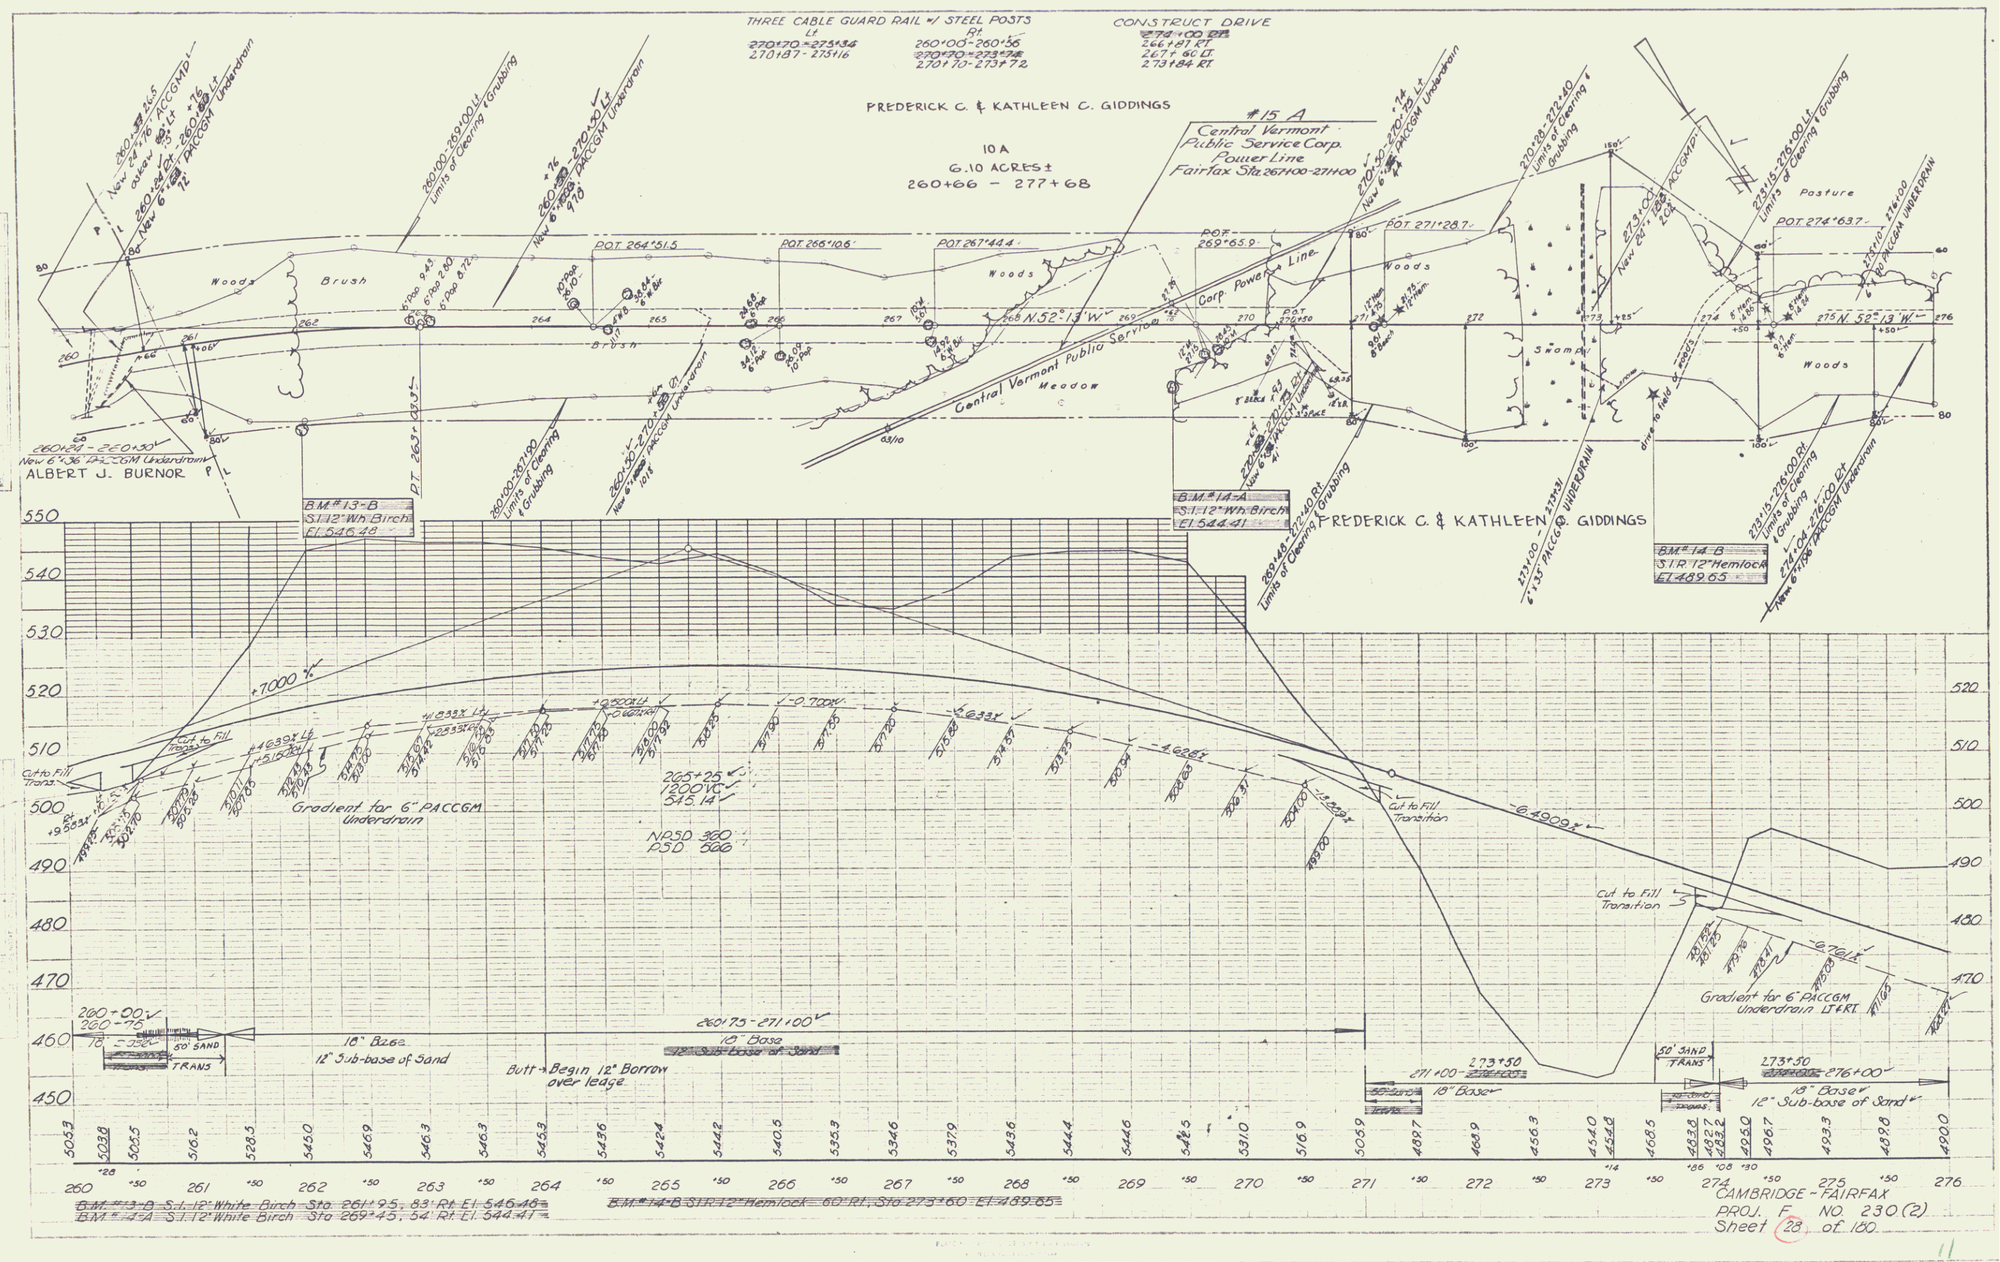
THREE CABLE GUARD RAIL w/ STEEL POSTS
Lt
270+70 - 273+34
270+87 - 273+16
Rt
260+00 - 260+56
270+70 - 273+72
270+70 - 273+72
CONSTRUCT DRIVE
~~274+00 Rt~~
266+87 Rt
267+60 Lt
273+84 Rt
PREDERICK C. & KATHLEEN C. GIDDINGS
10 A
6.10 ACRES ±
260+66 - 277+68
#15 A
Central Vermont
Public Service Corp.
Power Line
Fairfax Sta. 267+00 - 271+00
Woods
Brush
Meadow
Swamp
Pasture
Central Vermont Public Service Corp. Power Line
N.52°-13' W.
ALBERT J. BURNOR
PREDERICK C. & KATHLEEN C. GIDDINGS
B.M. #13-B
S.I. 12" Wh. Birch
El. 546.48
B.M. #14-A
S.I. 12" Wh. Birch
El. 544.41
B.M. #14-B
S.I.R. 12" Hemlock
El. 489.65
Gradient for 6" PACCGM Underdrain
Cut to Fill Transition
265+25
2001 VC
545.14
N 250 360
P 250 560
18" Base
12" Sub-base of Sand
50' SAND TRANS
Butt → Begin 12" Borrow over leage
260+75 - 271+00
271+00 - 273+50
273+50 - 276+00
Gradient for 6" PACCGM Underdrain Lt & Rt
CAMBRIDGE - FAIRFAX
PROJ. F NO. 230 (2)
Sheet 28 of 180