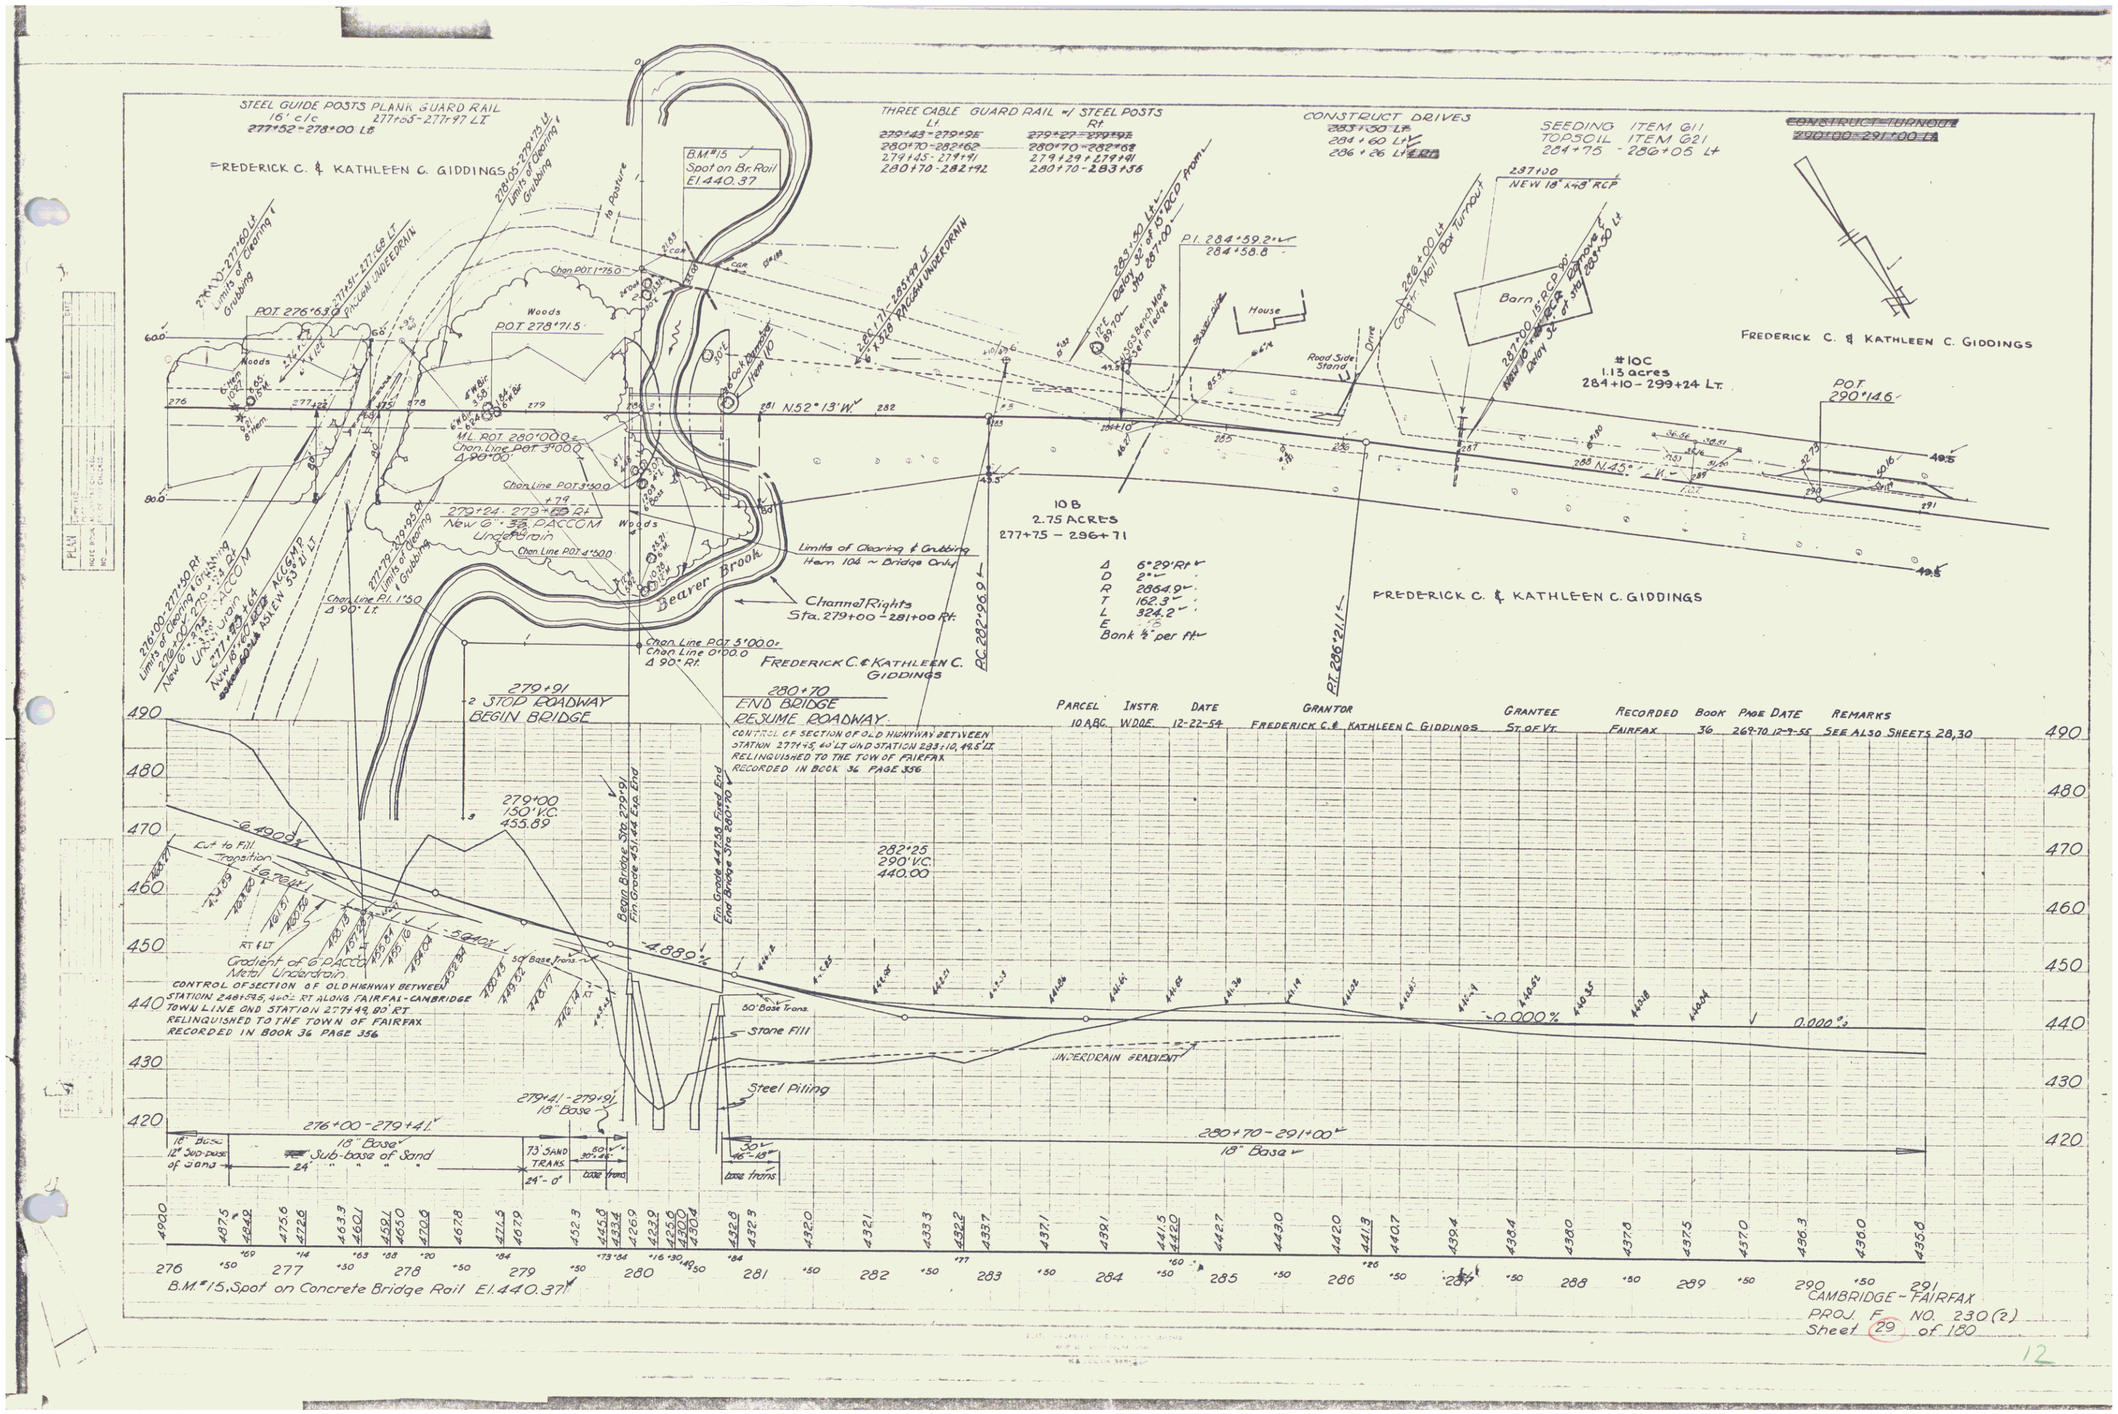

Parcel	Instr.	Date	Grantor	Grantee	Recorded	Book	Page	Date	Remarks
10 ABC	W.D.&E.	12-22-54	Frederick C. & Kathleen C. Giddings	St. of Vt.	Fairfax	36	269-70	12-9-55	See Also Sheets 28, 30

CAMBRIDGE - FAIRFAX
PROJ. F NO. 230(2)
Sheet 29 of 180

12