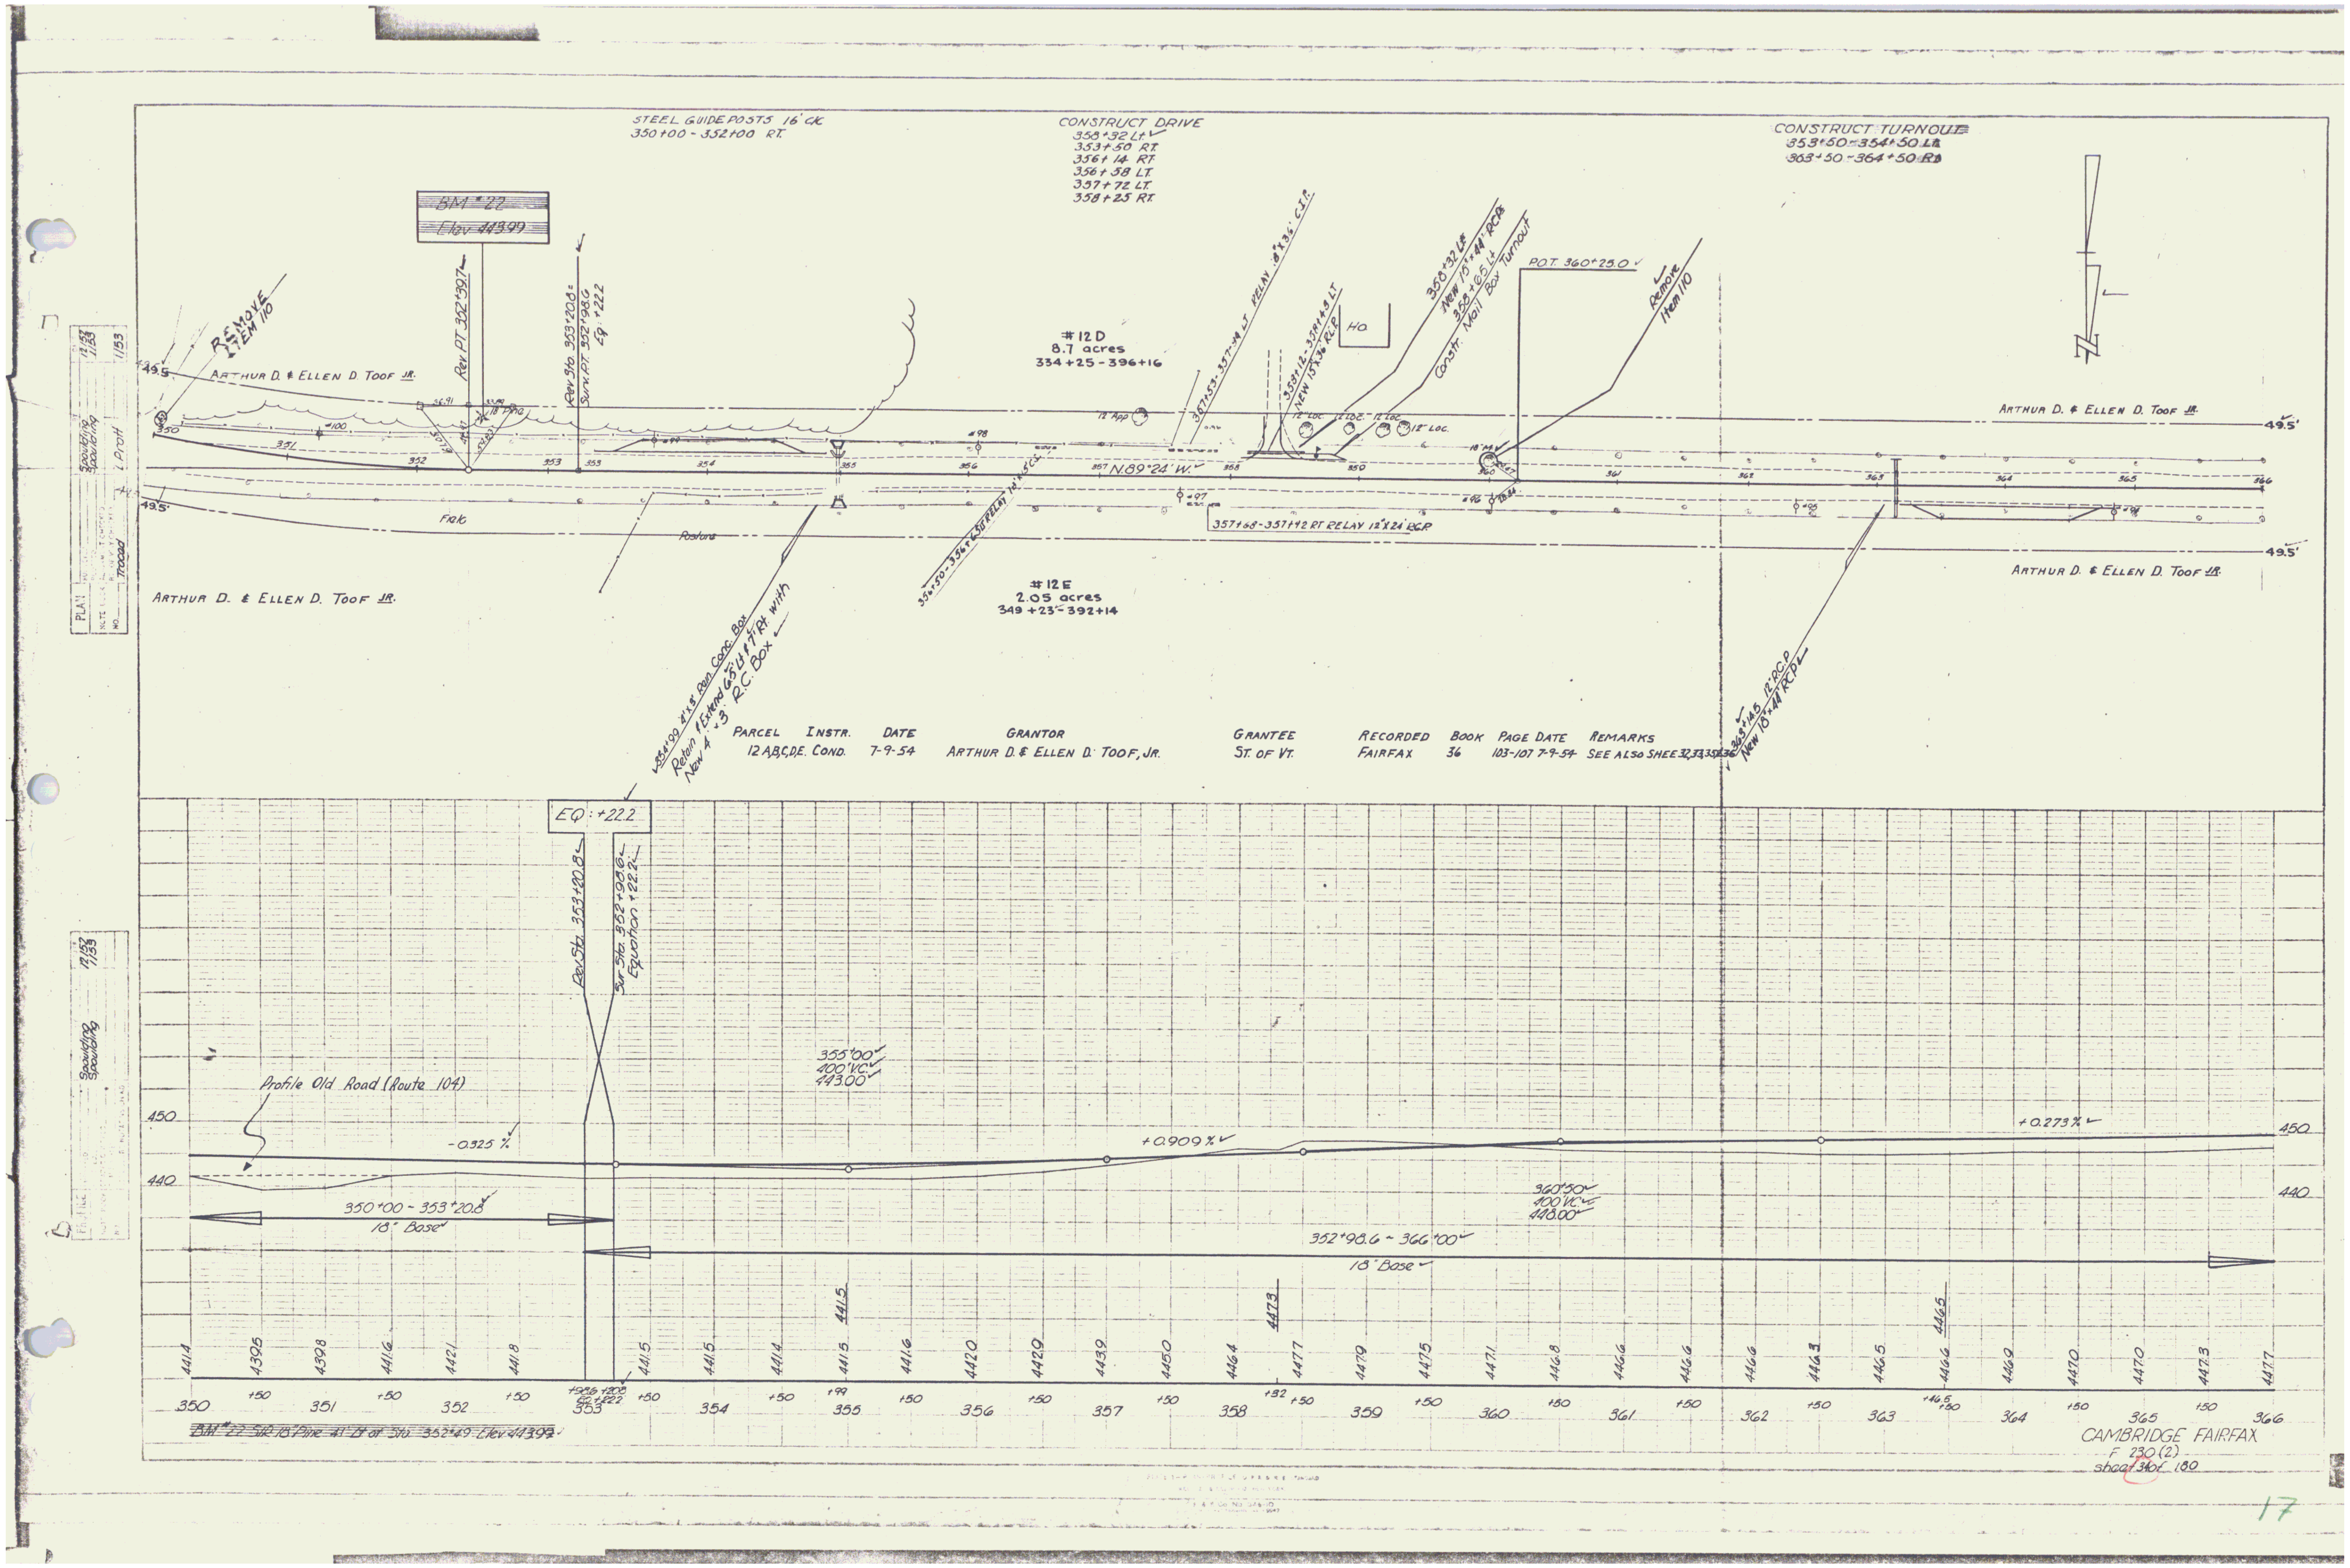
STEEL GUIDE POSTS 16' ck
350+00 - 352+00 RT.
CONSTRUCT DRIVE
353+32 Lt
353+50 RT
356+14 RT
356+38 LT
357+72 LT
358+25 RT
CONSTRUCT TURNOUT
353+50 - 354+50 Lt
363+50 - 364+50 Rt
BM #22
REMOVE ITEM 110
ARTHUR D. & ELLEN D. TOOF JR.
#12D
8.7 acres
334+25 - 396+16
N89°24' W.
P.O.T. 360+25.0
Remove Item 110
#12E
2.05 acres
349+23 - 392+14
357+08 - 357+42 RT RELAY 15"x24" UCP
ARTHUR D. & ELLEN D. TOOF JR.
PARCEL INSTR. DATE GRANTOR GRANTEE RECORDED BOOK PAGE DATE REMARKS
12 A,B,C,D,E. COND. 7-9-54 ARTHUR D. & ELLEN D. TOOF, JR. ST. OF VT. FAIRFAX 36 103-107 7-9-54 SEE ALSO SHEE
EQ +22.2
Equation +22.2
Profile Old Road (Route 104)
-0.325 %
355+00
400' VC
443.00
+0.909 %
+0.273 %
350+00 - 353+20.8
18' Base
352+98.6 - 366+00
18' Base
360+50
400' VC
448.00
450
440
350 351 352 353 354 355 356 357 358 359 360 361 362 363 364 365 366
BM #22 Elev 443.97
CAMBRIDGE FAIRFAX
F 230 (2)
sheet 36 of 180
17