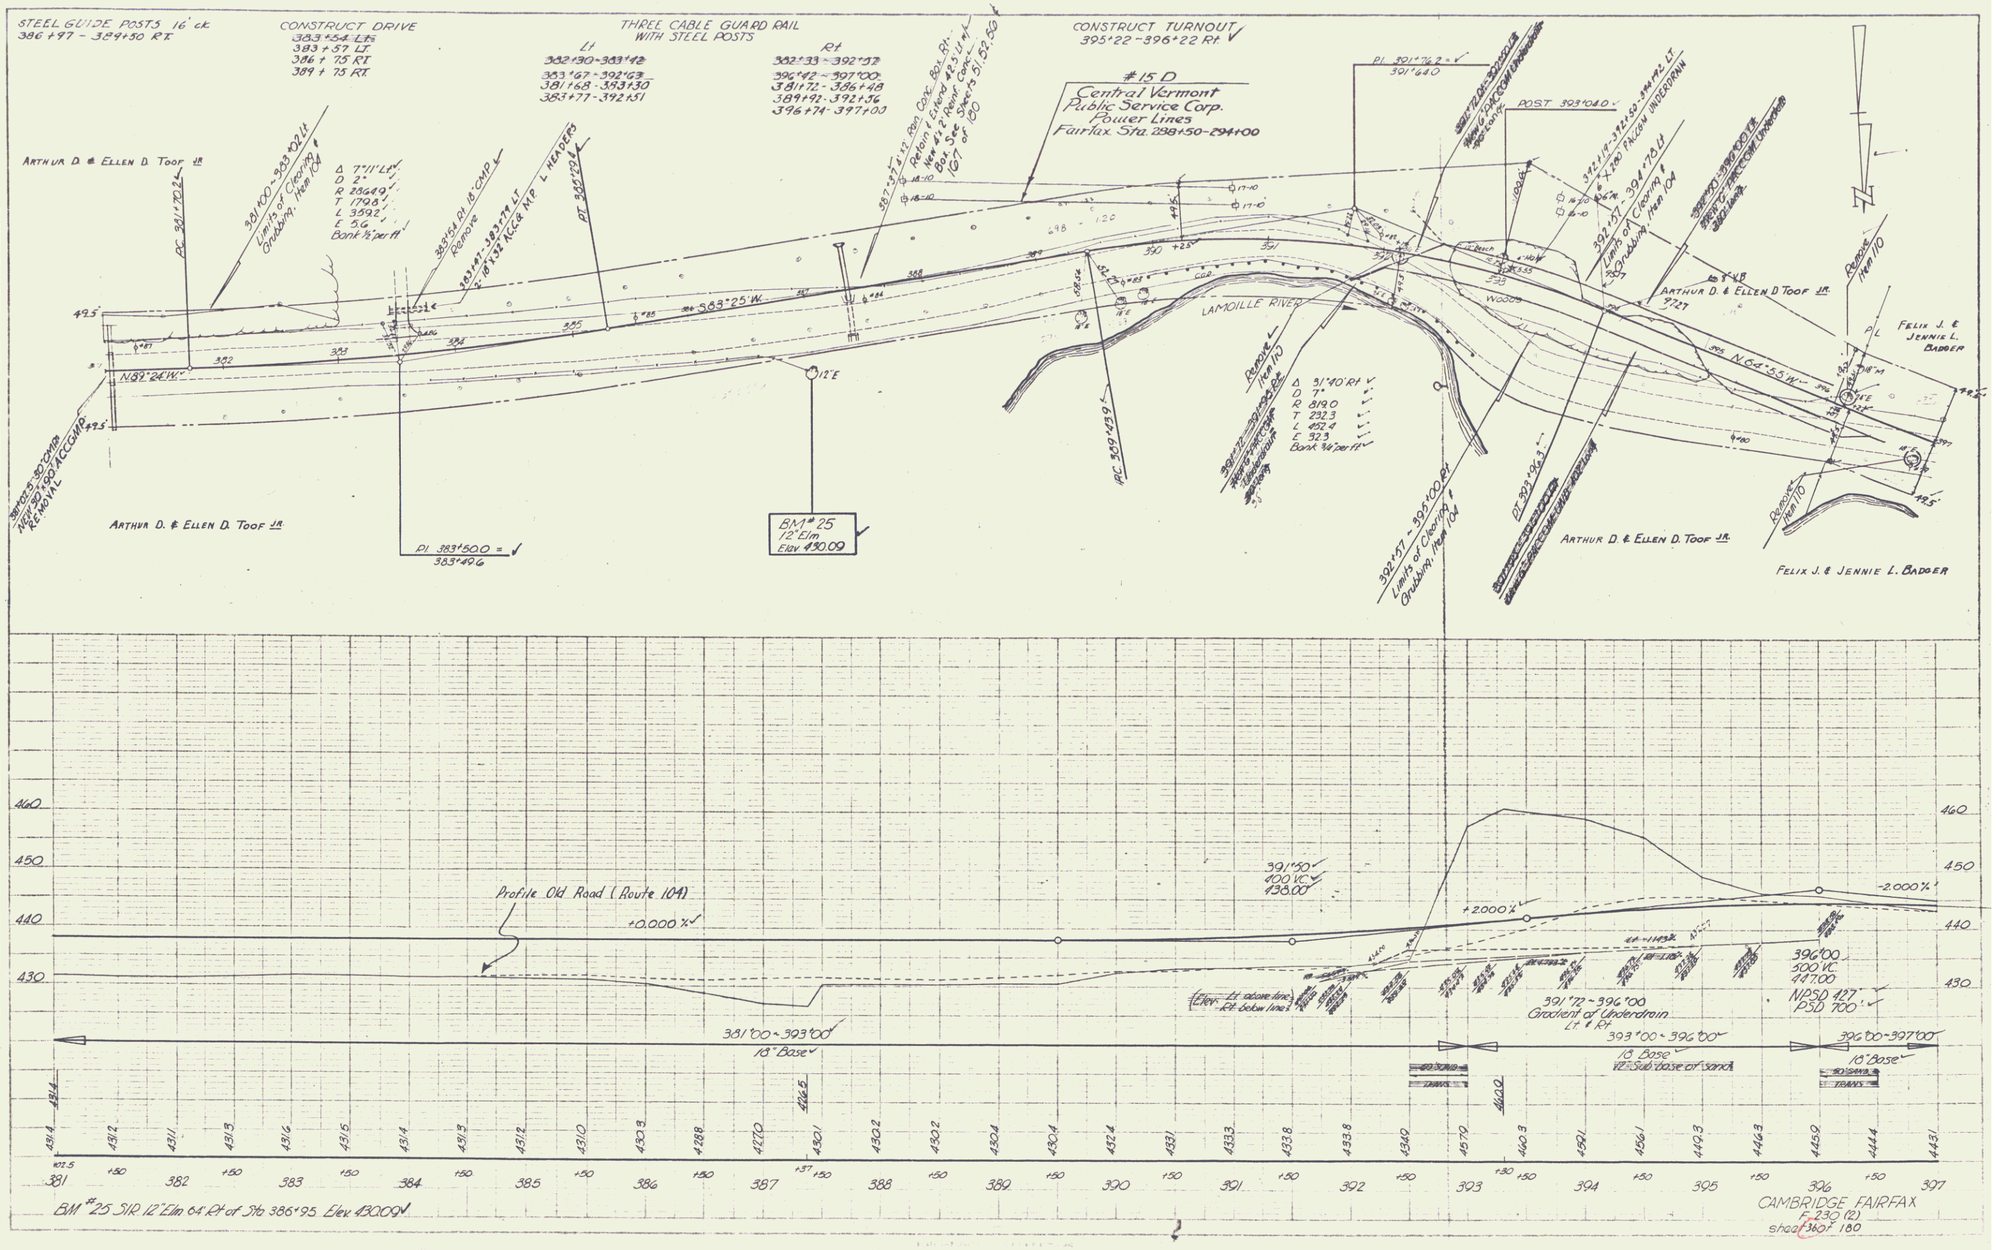
STEEL GUIDE POSTS 16' ck.
386+97 - 389+50 Rt.
CONSTRUCT DRIVE
383+54 Lt.
383+57 Lt.
386+75 Rt.
389+75 Rt.
THREE CABLE GUARD RAIL WITH STEEL POSTS
Lt
382+30-383+43
383+67-392+63
381+68-383+30
383+77-392+51
Rt
382+33-392+37
395+42-397+00
381+72-386+48
389+92-392+36
396+74-397+00
CONSTRUCT TURNOUT
395+22-396+22 Rt.
#15 D
Central Vermont
Public Service Corp.
Power Lines
Fairfax Sta. 289+50-294+00
ARTHUR D. & ELLEN D. TOOF JR.
LAMOILLE RIVER
FELIX J. & JENNIE L. BADGER
BM #25
12" Elm
Elev 430.09
Profile Old Road (Route 104)
+0.000%
+2.000%
-2.000%
391+50
100 VC
438.00
396+00
500 VC
447.00
NPSD 427
PSD 700
391+72-396+00
Gradient of Underdrain
Lt & Rt
381+00-393+00
18" Base
393+00-396+00
18" Base
12" Sub base of sand
396+00-397+00
18" Base
BM #25 S/R 12" Elm 64' Rt of Sta 386+95 Elev 430.09
CAMBRIDGE FAIRFAX
F-230 (2)
sheet 3 of 180

17