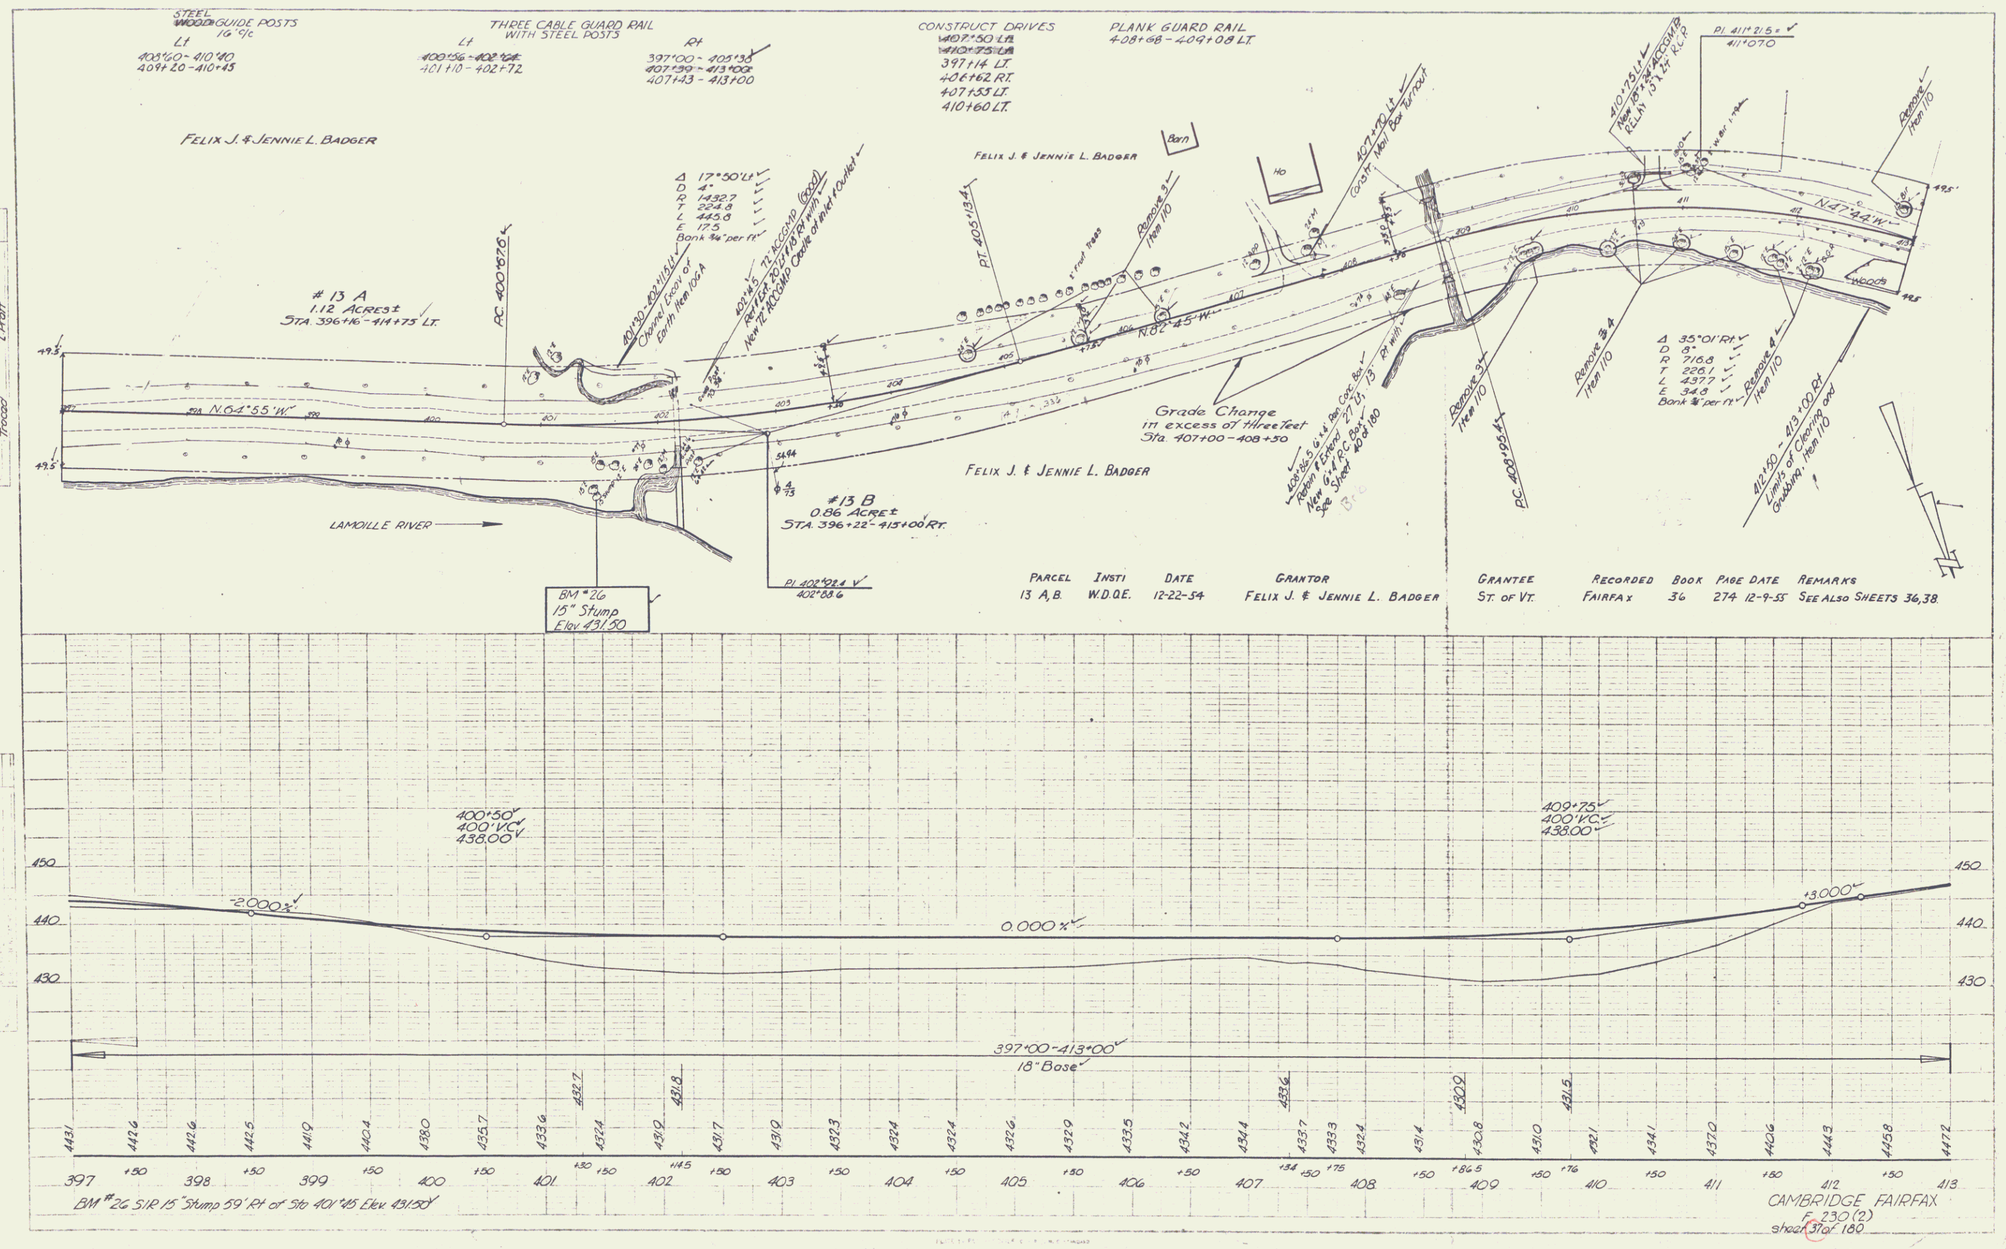
STEEL ~~WOOD~~ GUIDE POSTS 16' c/c
Lt
403+60 - 410+40
409+20 - 410+45
THREE CABLE GUARD RAIL WITH STEEL POSTS
Lt
~~400+56 - 402+04~~
401+10 - 402+72
Rt
397+00 - 405+35
407+99 - 413+00
407+43 - 413+00
CONSTRUCT DRIVES
~~407+50 Lt~~
~~410+75 Lt~~
397+14 LT.
406+62 RT.
407+55 LT.
410+60 LT.
PLANK GUARD RAIL
408+68 - 409+08 LT
FELIX J. & JENNIE L. BADGER
Δ 17°50' Lt
D 4°
R 1432.7
T 224.8
L 445.8
E 17.5
Bank ¾" per ft
Remove Item 110
Barn
Ho
Grade Change
Sta. 407+00 - 408+50
13 A
1.12 Acres±
STA. 396+16 - 414+75 LT.
P.C. 400+67.6
N.64°55' W.
N.62°45' W.
N.47°42' W.
LAMOILLE RIVER
13 B
0.86 Acre±
STA. 396+22 - 415+00 RT.
BM #26
15" Stump
Elev. 431.50
P.I. 402+92.4
402+88.6
P.I. 411+21.5
411+07.0
Δ 35°01' Rt
D 8°
R 716.8
T 225.1
L 437.7
E 34.8
Bank ⅜" per ft
P.C. 408+95.4
Woods
412+50 - 413+00 Rt
Limits of Clearing and Grubbing Item 110
PARCEL INSTI DATE GRANTOR
13 A,B. W.D.Q.E. 12-22-54 FELIX J. & JENNIE L. BADGER
GRANTEE RECORDED BOOK PAGE DATE REMARKS
ST. OF VT. FAIRFAX 36 274 12-9-55 SEE ALSO SHEETS 36,38.
400+50
400' V.C.
438.00
409+75
400' V.C.
438.00
-2.000%
0.000%
+3.000%
397+00-413+00
18" Base
397 398 399 400 401 402 403 404 405 406 407 408 409 410 411 412 413
BM #26 S1R 15" Stump 59' Rt of Sta 401+45 Elev 431.50
CAMBRIDGE FAIRFAX
F 230 (2)
