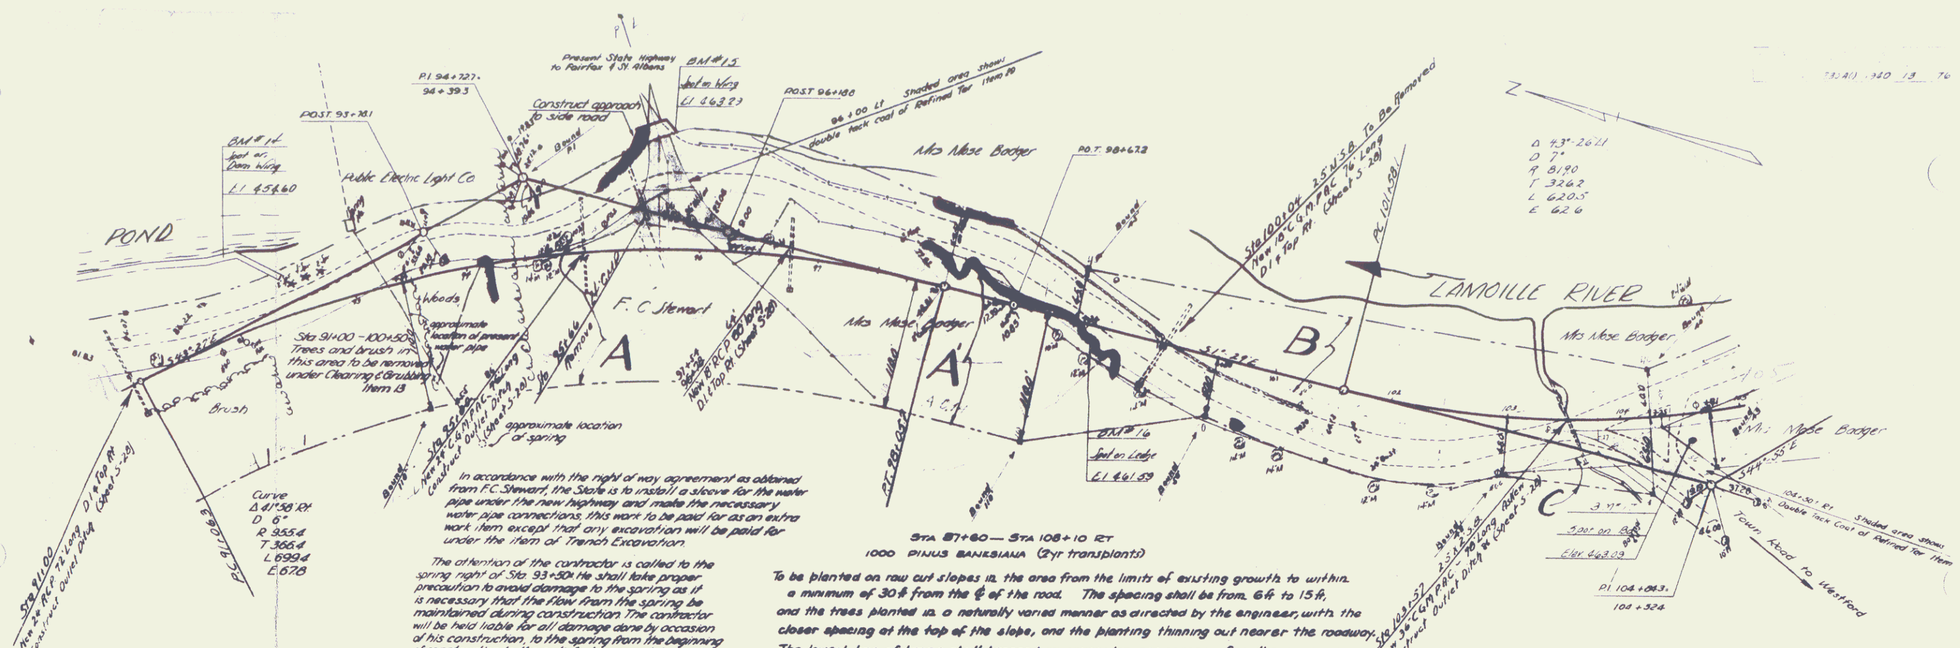
POND
Public Electric Light Co.
Brush
Trees and brush in this area to be removed under Clearing & Grubbing Item 13
approximate location of present water pipe
approximate location of spring
F. C. Stewart
Mrs Mose Badger
LAMOILLE RIVER
Town Road to Westford
Curve
Δ 41°58' Rt
D 6°
R 955.4
T 366.4
L 699.4
E 67.8
In accordance with the right of way agreement as obtained from F.C. Stewart, the State is to install a sleeve for the water pipe under the new highway and make the necessary water pipe connections, this work to be paid for as an extra work item except that any excavation will be paid for under the item of Trench Excavation.
The attention of the contractor is called to the spring right of Sta. 93+50 Rt. He shall take proper precaution to avoid damage to the spring as it is necessary that the flow from the spring be maintained during construction. The contractor will be held liable for all damage done by occasion of his construction, to the spring from the beginning of construction to the satisfactory completion of the project.
STA 87+60 — STA 108+10 RT
1000 PINUS BANKSIANA (2yr transplants)
To be planted on raw cut slopes in the area from the limits of existing growth to within a minimum of 30 ft from the ℄ of the road. The spacing shall be from 6 ft to 15 ft, and the trees planted in a naturally varied manner as directed by the engineer, with the closer spacing at the top of the slope, and the planting thinning out nearer the roadway. The lowest line of trees shall present an irregular appearance from the roadway.
(See sheet 4-A)
Shaded area shows Double Back Coat of Refined Tar Item 19
Construct approach to side road
Present State Highway to Fairfax & St. Albans
Spot on Wing
El. 463.23
BM #14
Spot on Dam Wing
El. 454.60
BM #16
Spot on Ledge
El. 461.59
P.O.S.T. 93+281
P.O.S.T. 96+180
P.O.T. 98+672
P.I. 94+727
94+39.3
P.C. 101+58
P.I. 104+063
104+324
Elev. 463.03
Δ 43°-26' Lt
D 7°
R 819.0
T 326.2
L 620.5
E 62.6
Sta 91+00 Rt
New 24" RCP 72' long
Construct Outlet Ditch
D 1' Top Rt. (Sheet 5-20)
Sta 100+04 25' Lt
New 18" CMP 86' long
D 1' Top Rt. (Sheet 5-20)
Sta 103+32 35' Lt
New 36" CMP 80' long
Construct Outlet Ditch
D 1' Top Rt. (Sheet 5-20)
Sta 96+00 Lt
New 18" RCP 80' long
D 1' Top Rt. (Sheet 5-20)
Sta 100+04 25' Lt To Be Removed
Double Back Coat of Refined Tar Item 19
Sta 91+00
Sta 94+39.3
Sta 96+00
Sta 98+67
Sta 100+04
Sta 103+32
Sta 104+06
