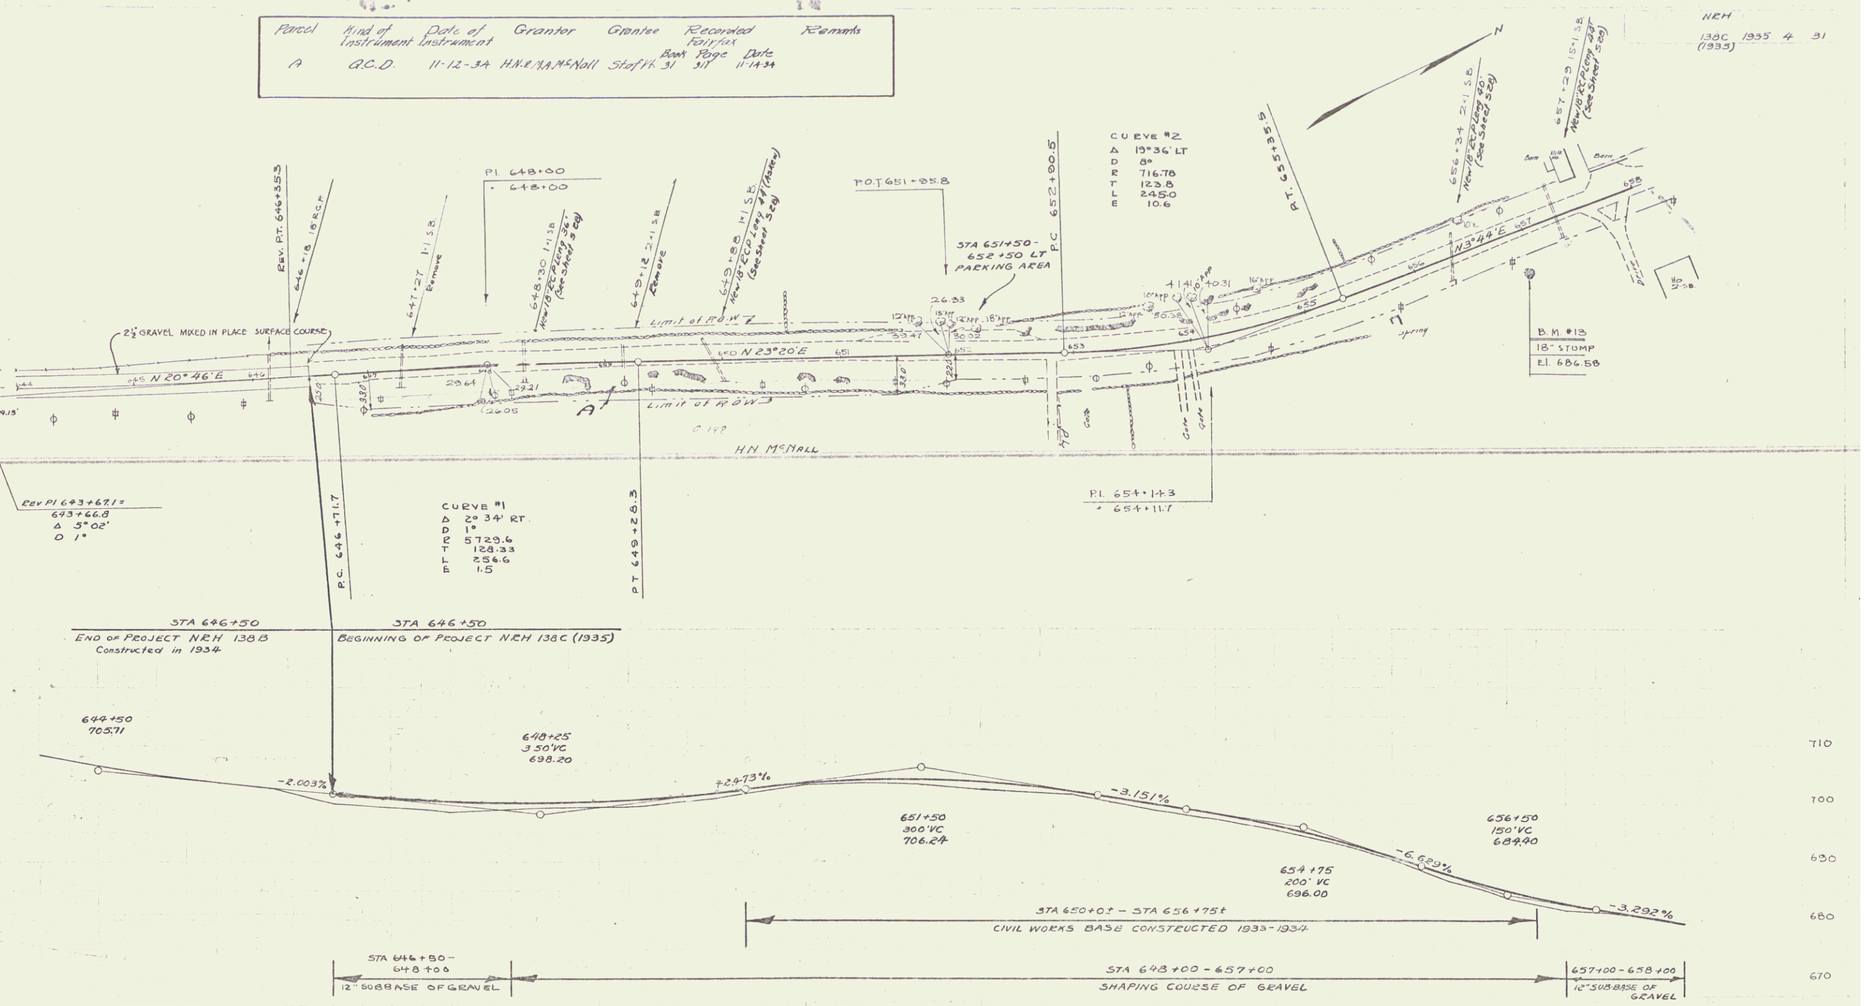Parcel	Kind of Instrument	Date of Instrument	Grantor	Grantee	Recorded Fairfax Book	Page	Date	Remarks
