Parcel	Kind of Instrument	Date of Instrument	Grantor	Grantee	Recorded Fairfax Book	Page	Date	Remarks
B'&C'	QCD	2-14-35	Jas & Lumina Rolle	State of Va.	31	322	2-19-35	

NRH
138C(1935) 1935 6 31

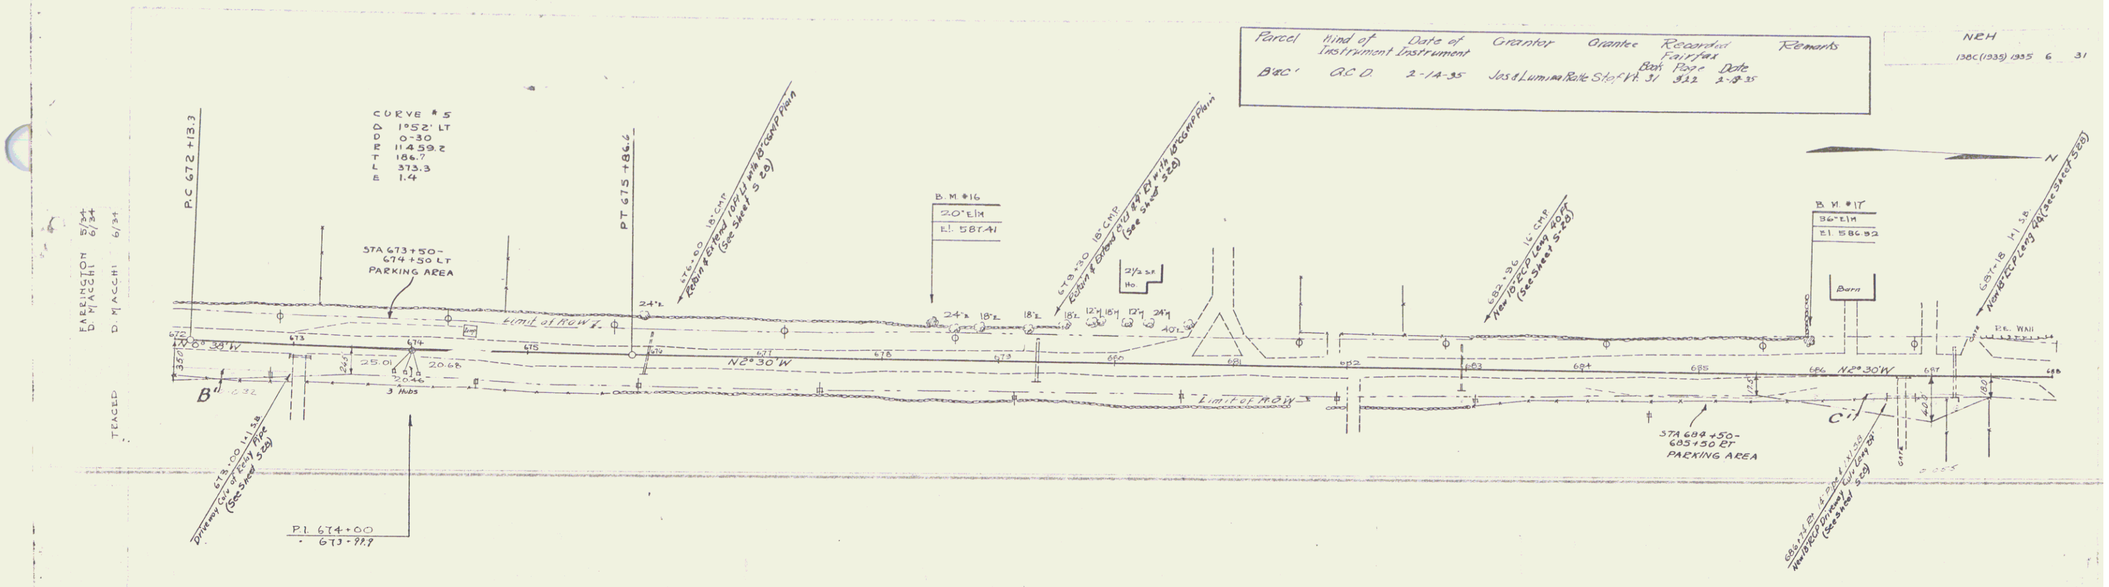

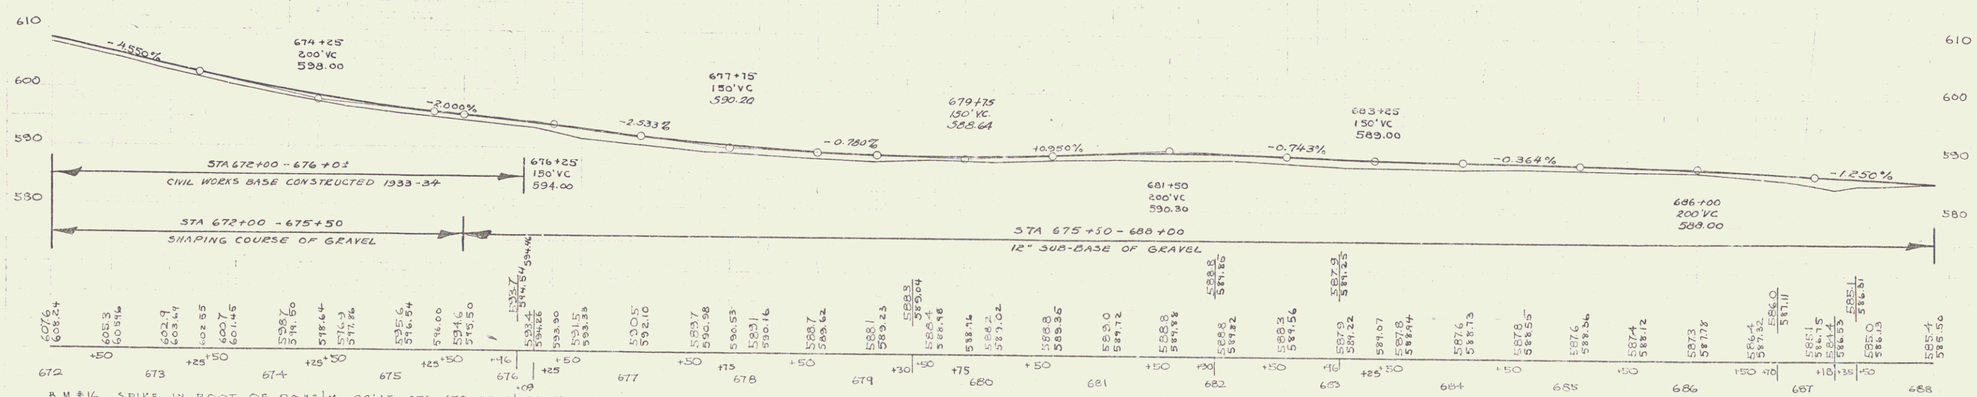

B.M. #16 SPIKE IN ROOT OF 20" ELM 28' LT. STA 678+42 El 587.41
B.M. #17 " " " 36" ELM 26' LT. STA 685+80 El 586.52

SERIES NRH NO. 138C (1935)
SHEET NO. 6 OF 31

4