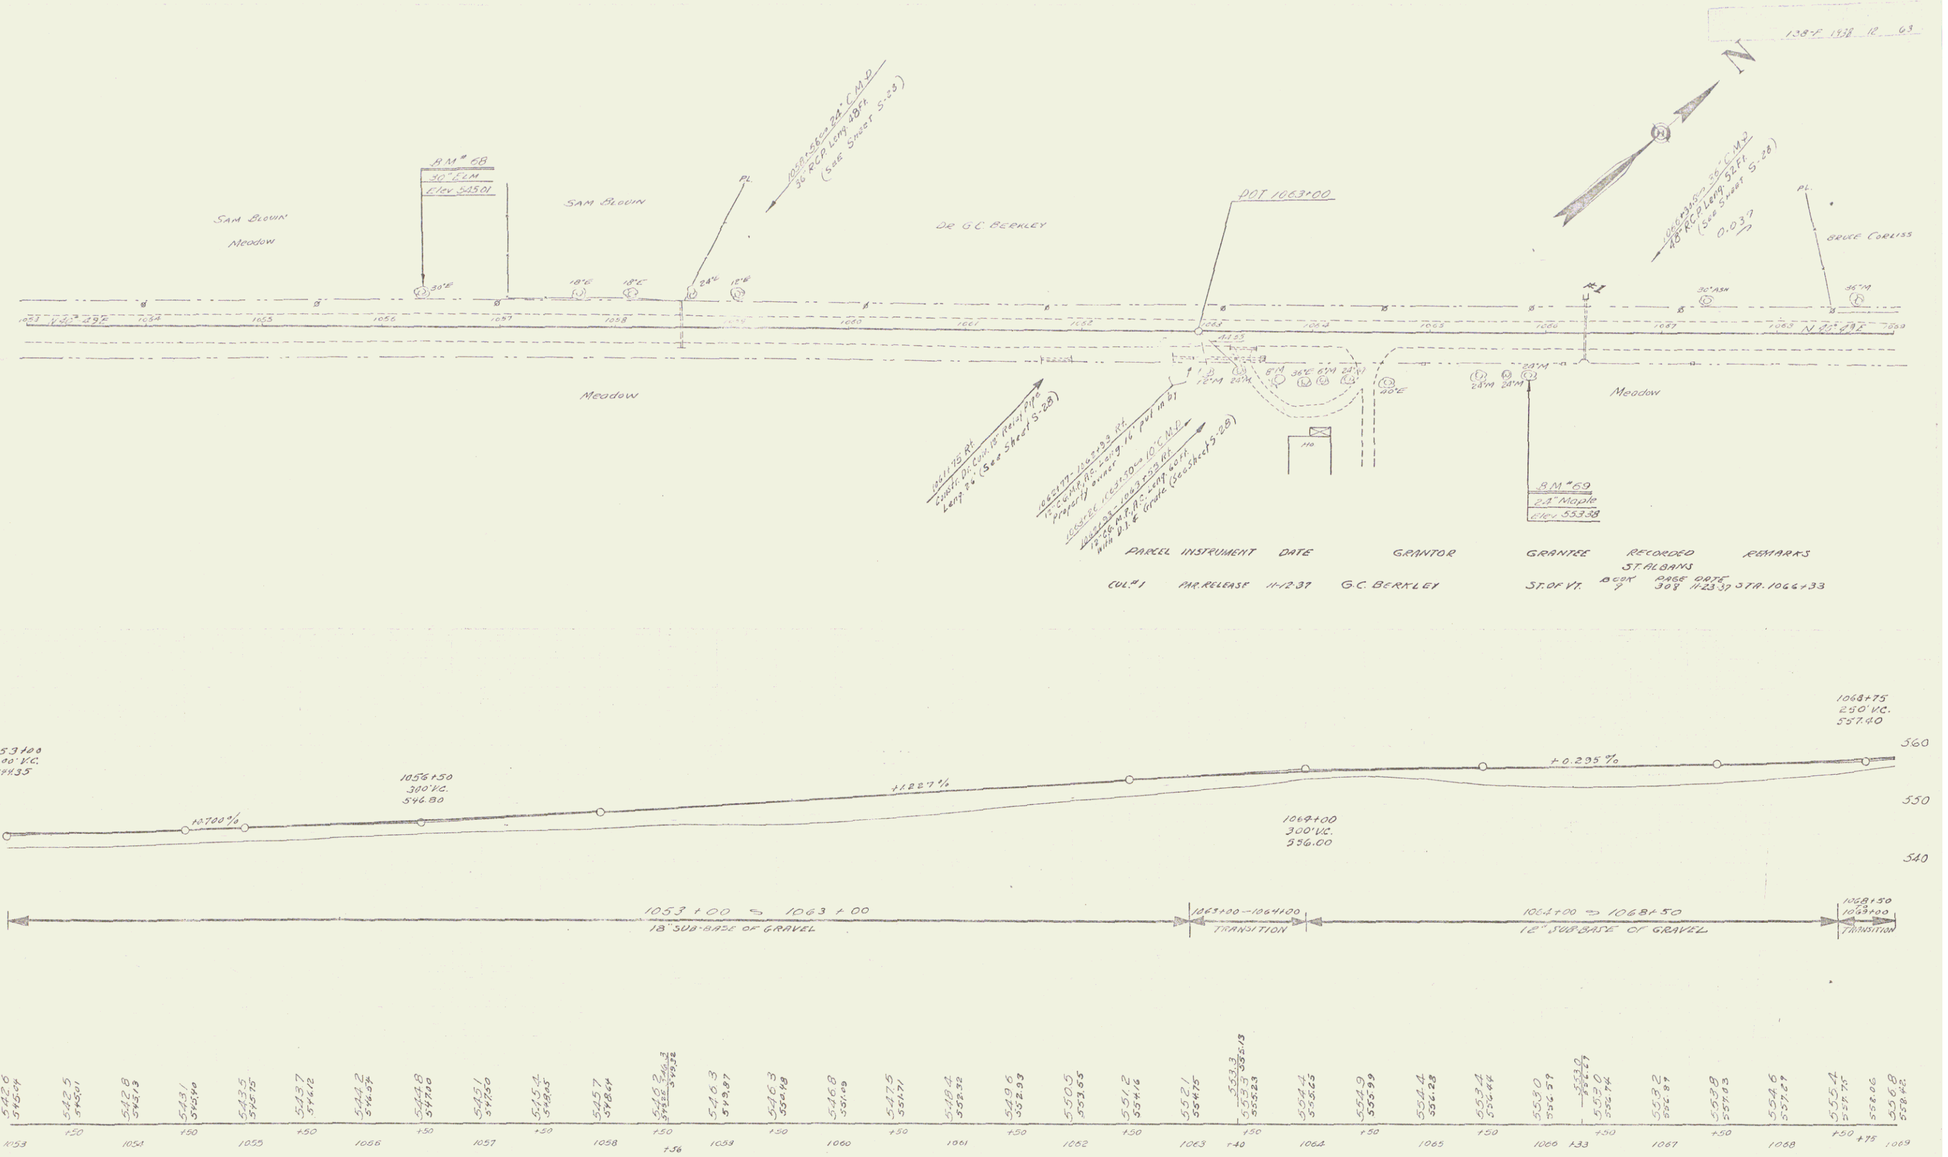

BM #68 Spike in Root of 30" Elm 25.5' Lt of Sta 1056+32 Elev 545.01'
BM #69 Spike in Root of 24" Maple 33' Rt. of Sta 1065+67 Elev 553.38'

SERIES F-P NO. 138-F
SHEET 12 OF 63

10