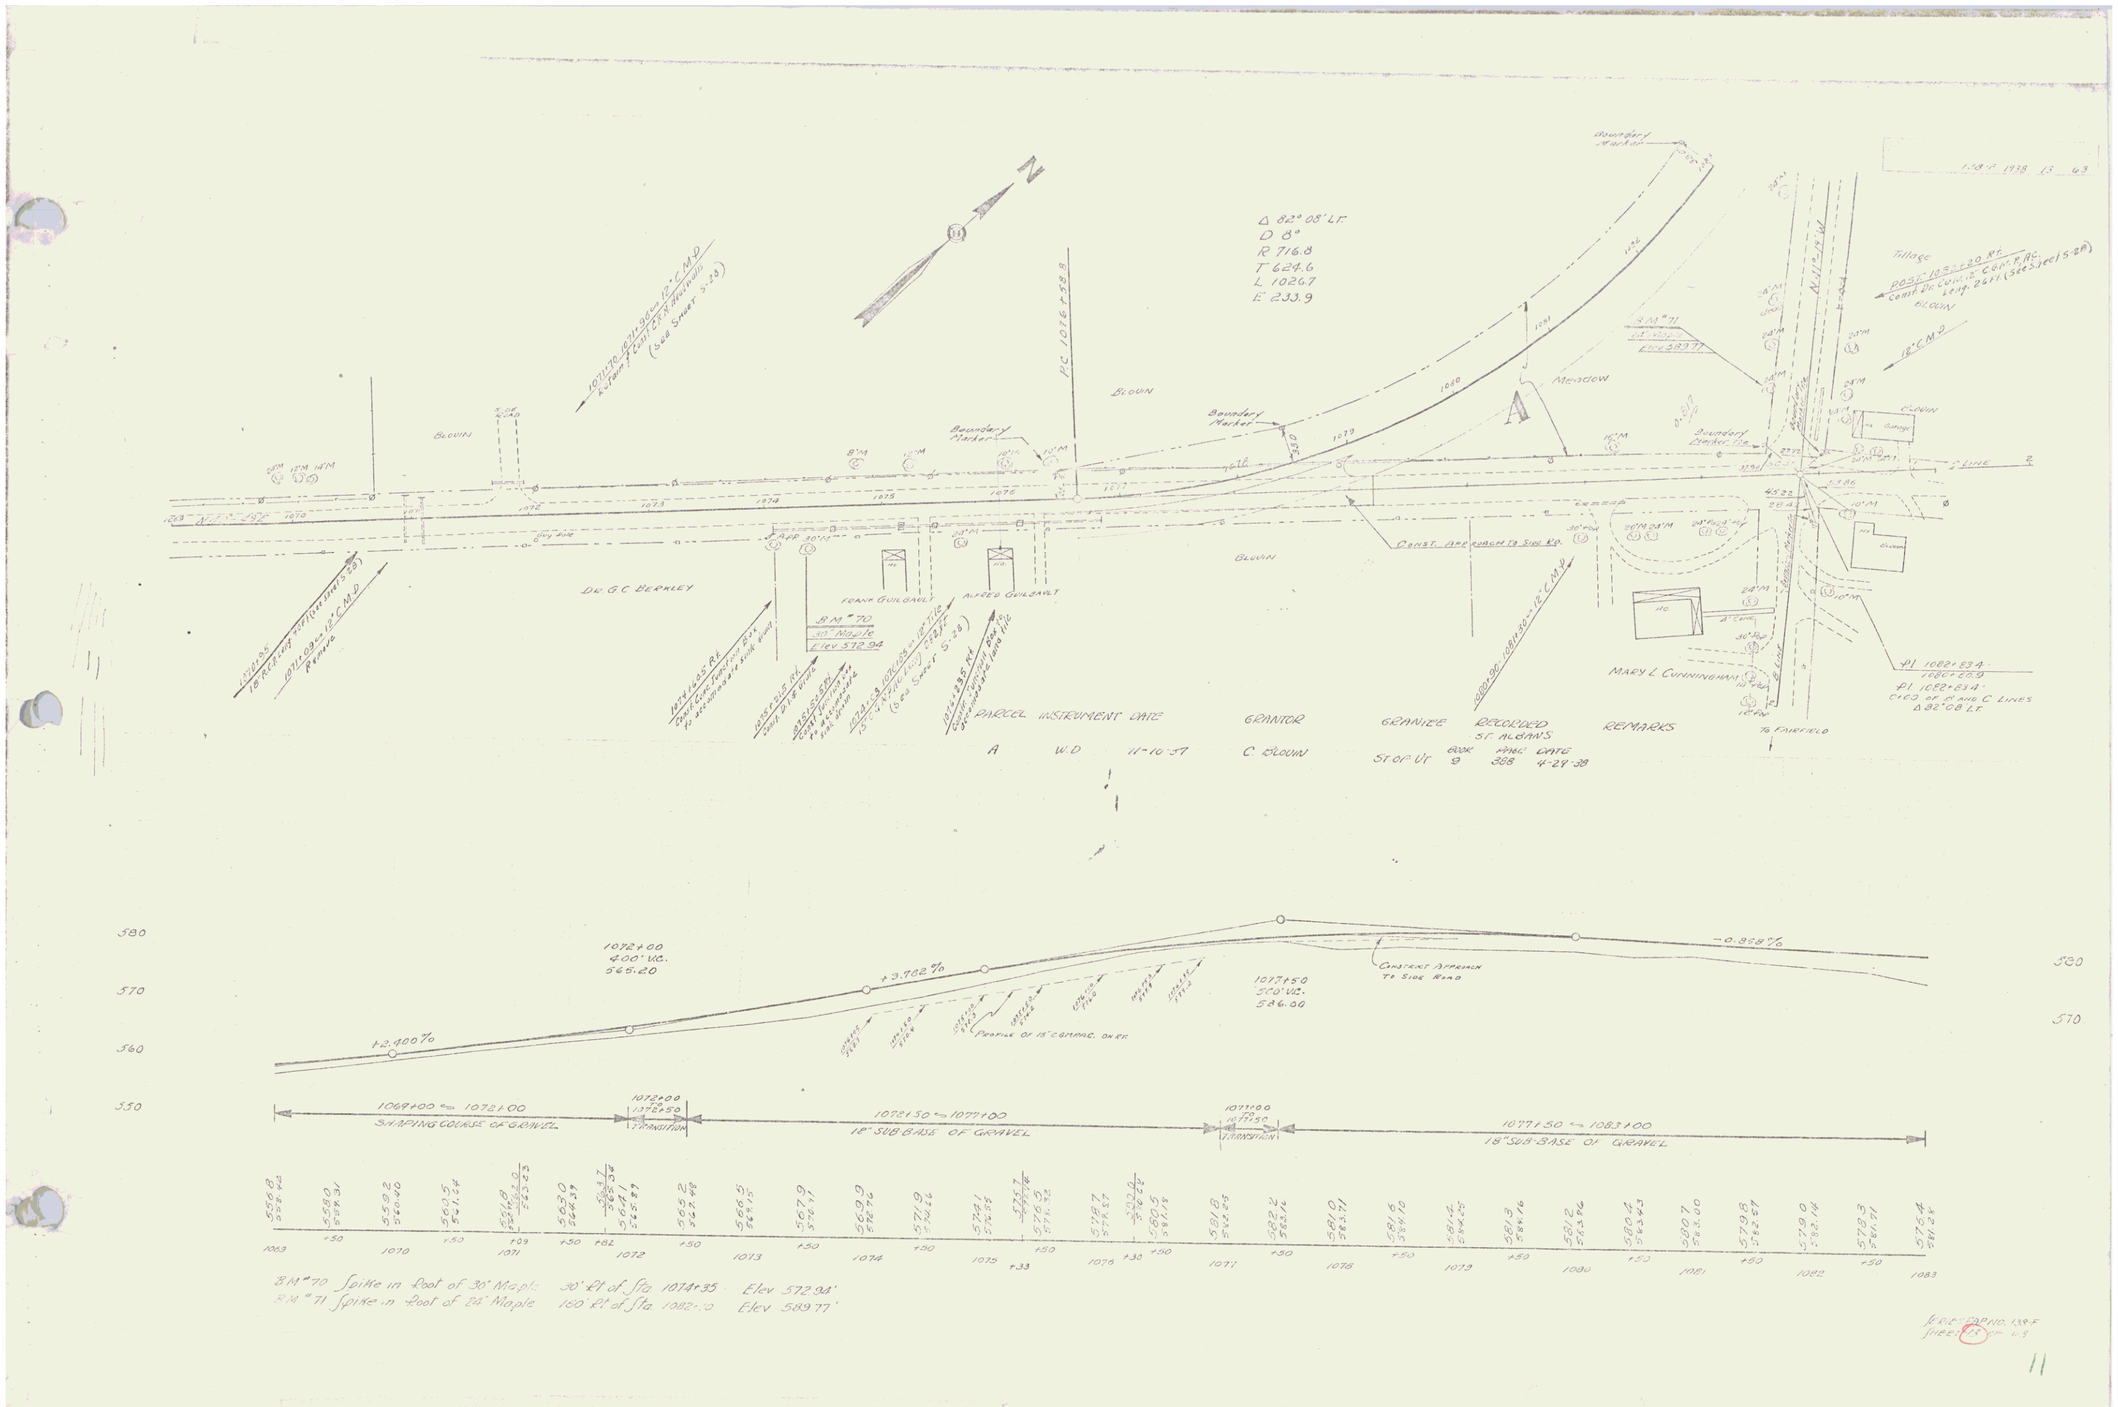
Δ 82° 08' LT.
D 8°
R 716.8
T 624.6
L 1026.7
E 233.9
P.C. 1076+79.8
Boundary Marker
Meadow
Village
Const. Dr. Curb & Gr. Rd.
Const. Approach to Side Rd.
Dr. G.C. Berkley
Frank Guilault
Alfred Guilault
Mary L. Cunningham
To Fairfield
Parcel Instrument Date Grantor Grantee Recorded St. Albans Remarks
A W.D 11-10-37 C. Blown St. of Vt. Book 9 Page 508 Date 4-24-38
580
570
560
550
1072+00
400' V.C.
565.20
+2.400%
+3.782%
-0.958%
1077+50
500' V.C.
546.00
Profile of 18" Compac. on Rt.
1069+00 ⇔ 1072+00
Shaping Course of Gravel
1072+00 to 1072+50
Transition
1072+50 ⇔ 1077+00
18" Sub-Base of Gravel
1077+00 to 1077+50
Transition
1077+50 ⇔ 1083+00
18" Sub-Base of Gravel
BM #70 Spike in Root of 30" Maple 30' Rt of Sta. 1074+35 Elev 572.94'
BM #71 Spike in Root of 24" Maple 160' Rt of Sta. 1082+0 Elev 589.77'

11