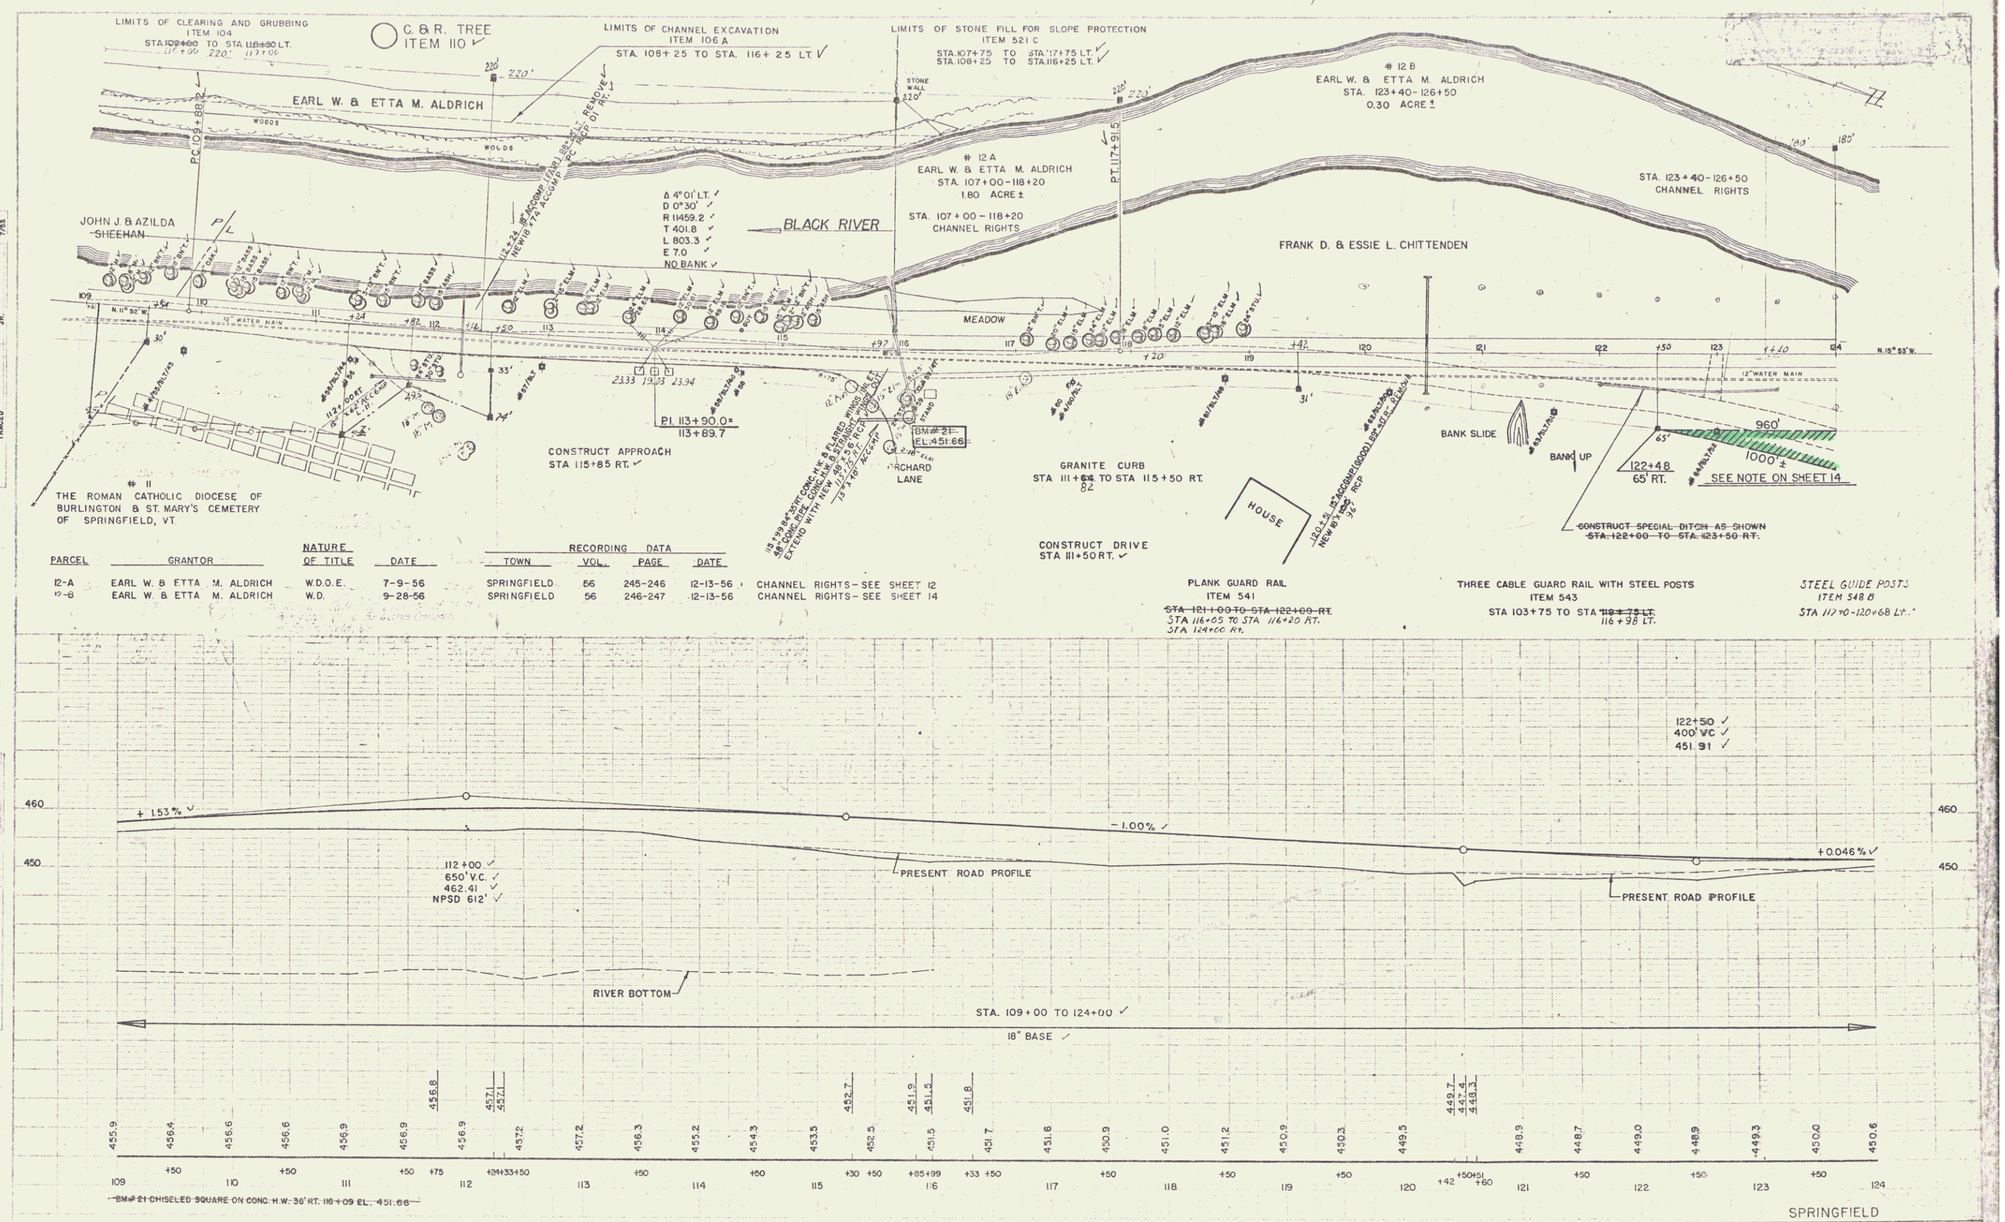

PARCEL	GRANTOR	NATURE OF TITLE	DATE	RECORDING DATA TOWN	VOL.	PAGE	DATE	
12-A	EARL W. & ETTA M. ALDRICH	W.D.O.E.	7-9-56	SPRINGFIELD	56	245-246	12-13-56	CHANNEL RIGHTS - SEE SHEET 12
12-B	EARL W. & ETTA M. ALDRICH	W.D.	9-28-56	SPRINGFIELD	56	246-247	12-13-56	CHANNEL RIGHTS - SEE SHEET 14

PLANK GUARD RAIL
ITEM 541
~~STA 121+00 TO STA 122+00 RT.~~
STA 116+05 TO STA 116+20 RT.
STA 124+00 RT.

THREE CABLE GUARD RAIL WITH STEEL POSTS
ITEM 543
STA 103+75 TO STA ~~118+75 LT.~~ 116+98 LT.

STEEL GUIDE POSTS
ITEM 548 B
STA 112+10 - 120+68 LT.

JUL 2 1980

SPRINGFIELD

THE CLARKESON ENGINEERING CO., INC.
CONSULTING ENGINEERS
BOSTON MASSACHUSETTS

SHEET 13 OF 114