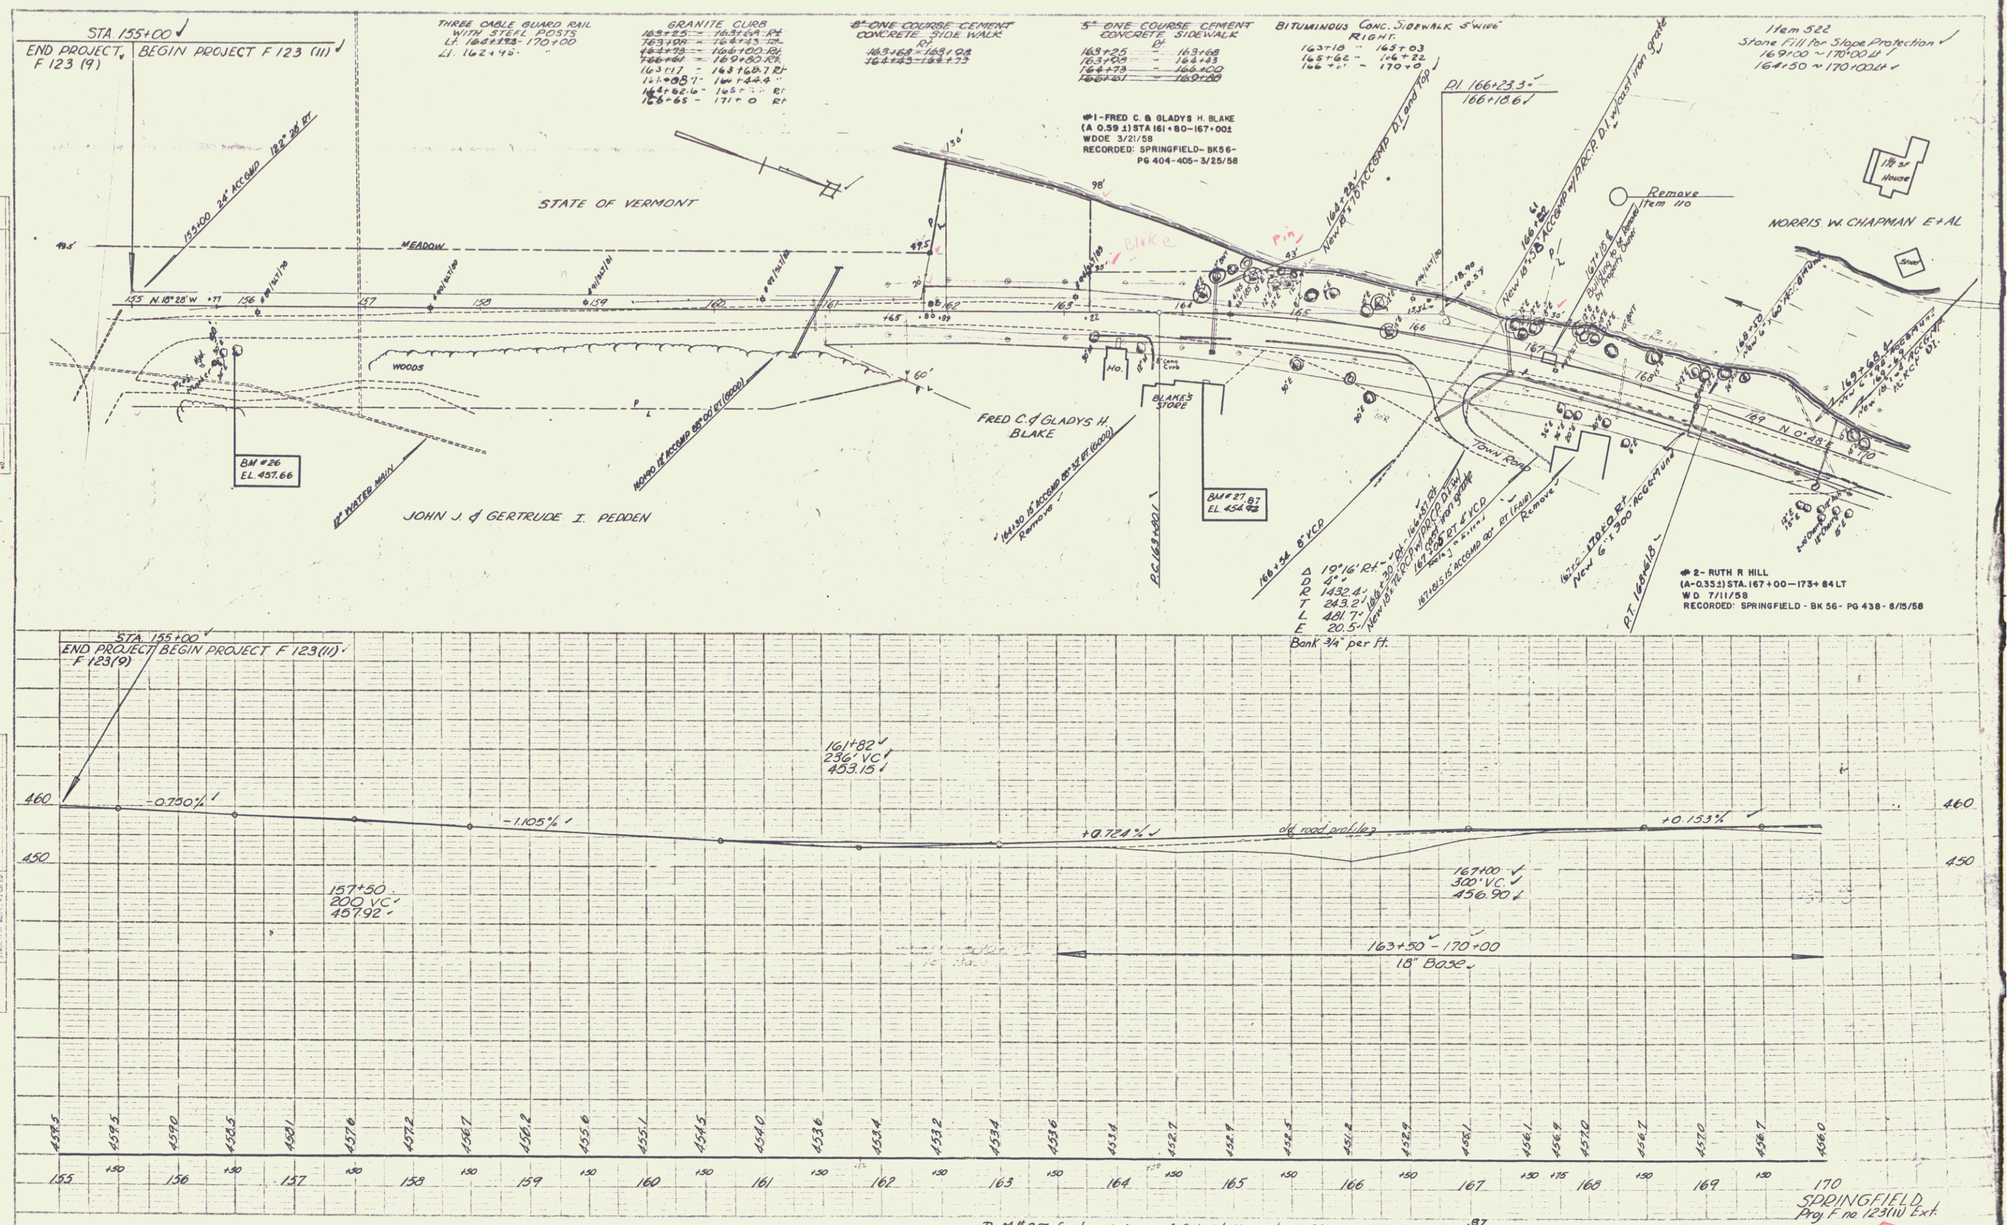
STA. 155+00
END PROJECT F 123 (9)
BEGIN PROJECT F 123 (11)
THREE CABLE GUARD RAIL WITH STEEL POSTS
GRANITE CURB
8" ONE COURSE CEMENT CONCRETE SIDE WALK
5" ONE COURSE CEMENT CONCRETE SIDEWALK
BITUMINOUS CONC. SIDEWALK 5' WIDE RIGHT
Item 522
Stone Fill for Slope Protection
#1 - FRED C. & GLADYS H. BLAKE
(A 0.59 ±) STA 161+80-167+00 ±
WDOE 3/21/58
RECORDED: SPRINGFIELD- BK56- PG 404-405- 3/25/58
STATE OF VERMONT
MEADOW
WOODS
BM #26
EL 457.66
JOHN J. & GERTRUDE I. PEDDEN
FRED C. & GLADYS H. BLAKE
BLAKE'S STORE
BM #27
EL 454.97
TOWN ROAD
NORRIS W. CHAPMAN ET AL
Remove Item 110
PI 166+23.3
166+18.61
Δ 19°16' RT
D 4°0'
R 1432.4'
T 243.2'
L 481.7'
E 20.5'
Bank 3/4" per ft.
#2 - RUTH R HILL
(A-0.35 ±) STA. 167+00 - 173+84 LT
WD 7/11/58
RECORDED: SPRINGFIELD - BK 56 - PG 438 - 8/15/58
STA. 155+00
END PROJECT F 123(9)
BEGIN PROJECT F 123(11)
-0.750%
-1.105%
+0.724%
+0.153%
old road profile
161+82
256' VC
453.15
157+50
200' VC
457.92
167+00
300' VC
456.90
163+50 - 170+00
18" Base
BM #27 Spot on S.W. Cor. of Side Walk 60' Rt. Sta. 164+25 Elev. 454.97
SPRINGFIELD
Proj F no 123(11) Ext.
SHEET 6 OF 41