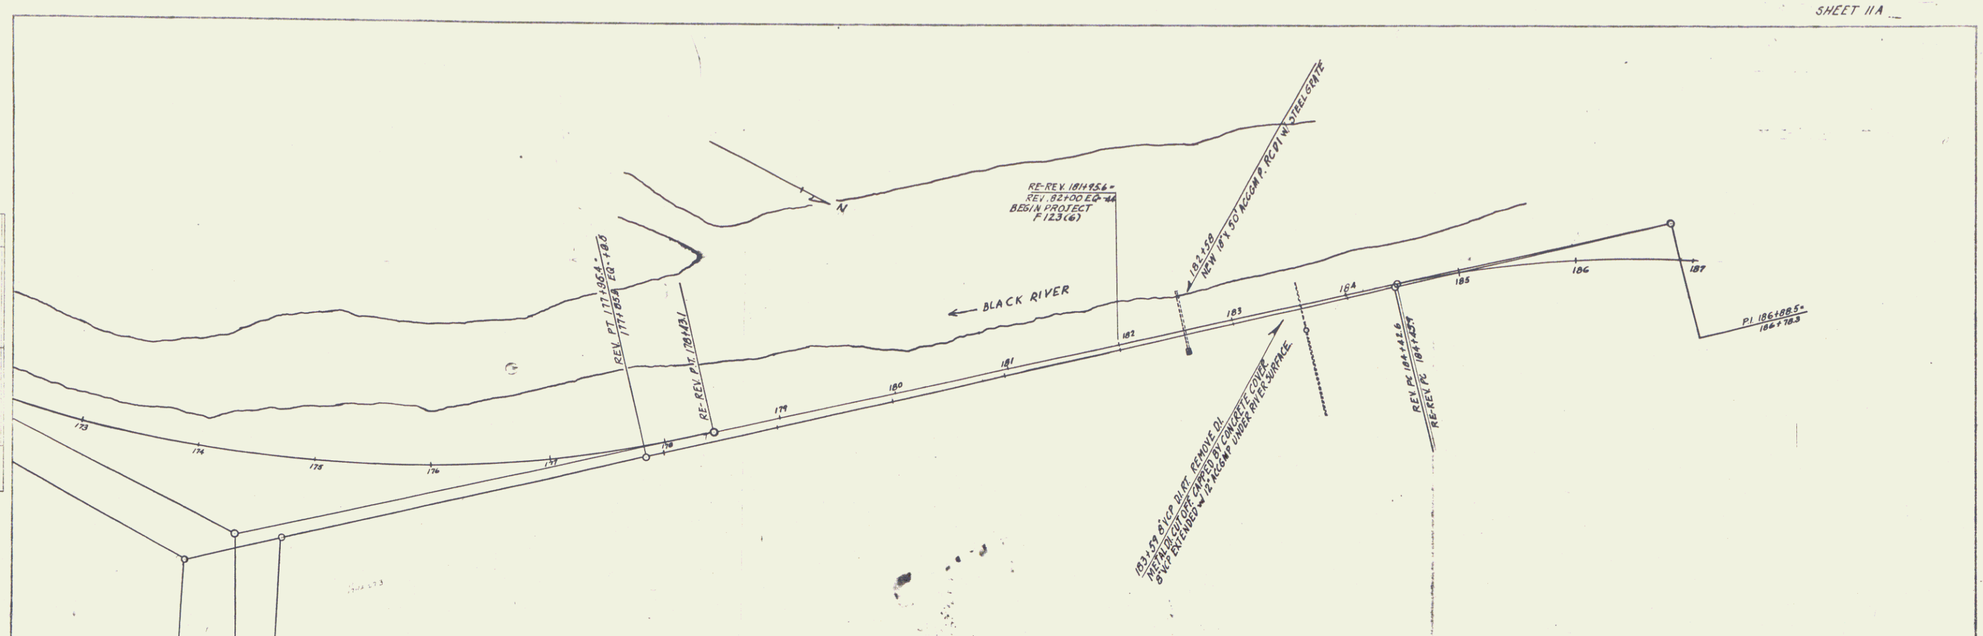
N
BLACK RIVER
RE-REV. 181+95.6+
REV. 182+00 EQ-4A
BESIN PROJECT
F123(6)
182+58
NEW 18"x 50' ACCM P. RC PI W. STEEL GRATE
REV. PT. 177+95.4+
177+85.8
RE-REV. PT. 178+19.1
173
174
175
176
177
178
179
180
181
182
183
184
185
186
187
REV. PI. 184+42.6
184+42.5T
RE-REV. TC
P.I. 186+88.5+
186+78.3
183+59 6"CP DI. RT. REMOVE DI.
3"NT EXTENDED W. 12" ACCMP UNDER RIVER SURFACE.
RE-REV. PI
174+59.4+
174+17.3
REV. PI 174+27.7
173+23.3
PI 174+93.3
Δ=37°43'
D=5°30'
PLAN
PROFILE