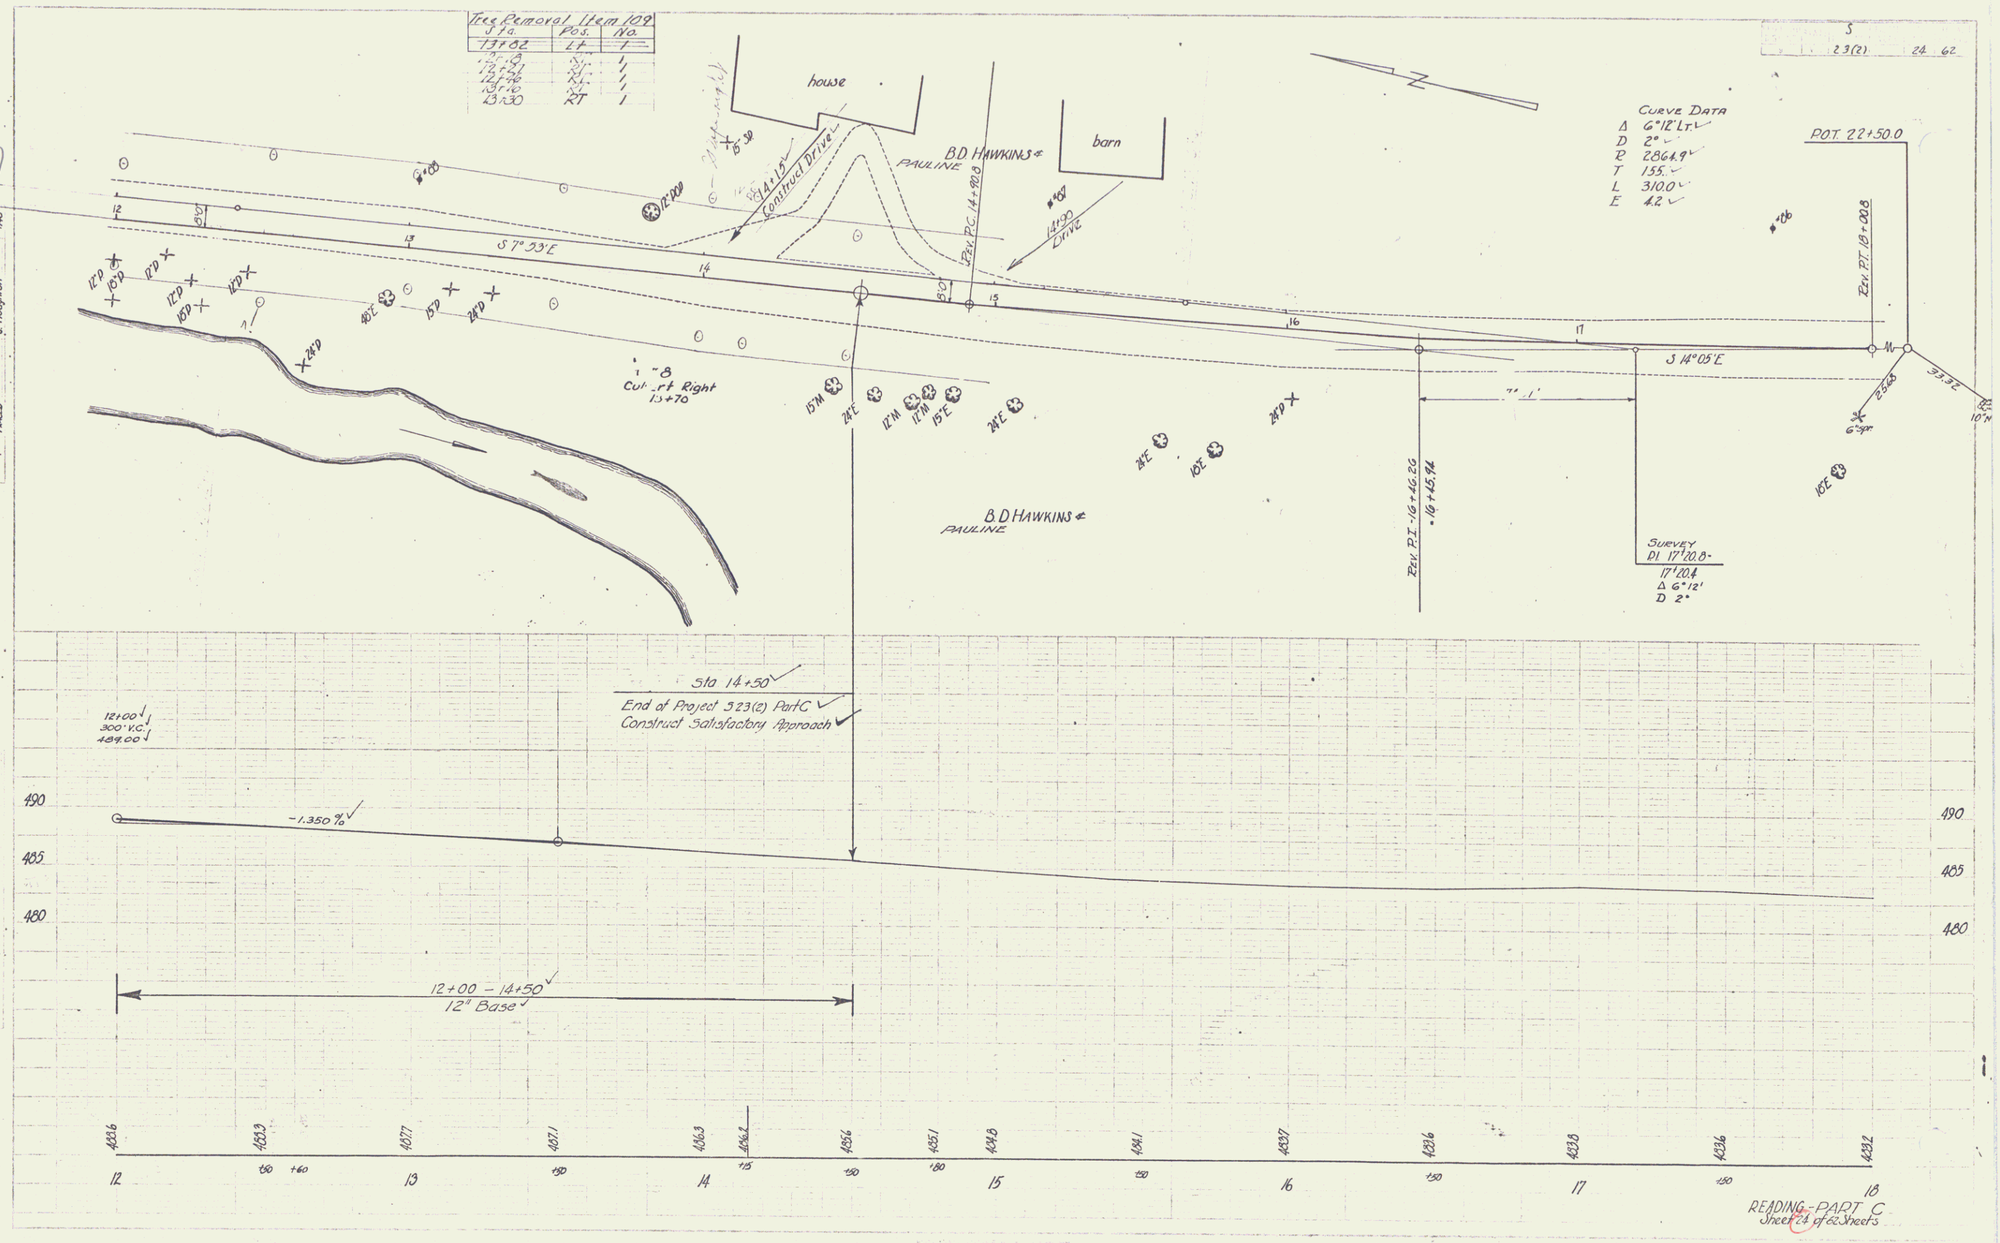Tree Removal Item 109		
Sta.	Pos.	No.
13+02	Lt.	1
12+80	Rt.	1
12+84	Rt.	1
12+86	Rt.	1
13+10	Rt.	1
13+30	Rt.	1