CLEARING & GRUBBING		
STA.	STA.	POS.
33+55	39+55	LT.
33+50	34+55	RT.
35+35	39+75	RT.
40+95	42+00	LT.
41+50	44+90	RT.
43+50	44+50	LT.

CONSTRUCT APPROACHES	
STA.	POS.
~~33+00~~ 36+86	~~LT.~~ LT

CONSTRUCT DRIVES	
STA.	
~~40+50~~ RT.	(WOOD ROAD TO EXISTING ROAD)

Δ 53° 33' LT.
D 4°
R 1432.7
T 722.9
L 1338.8
E 172.1
BANK 1/2" PER FT.

B.M. NO. 4
ELEV. 998.11

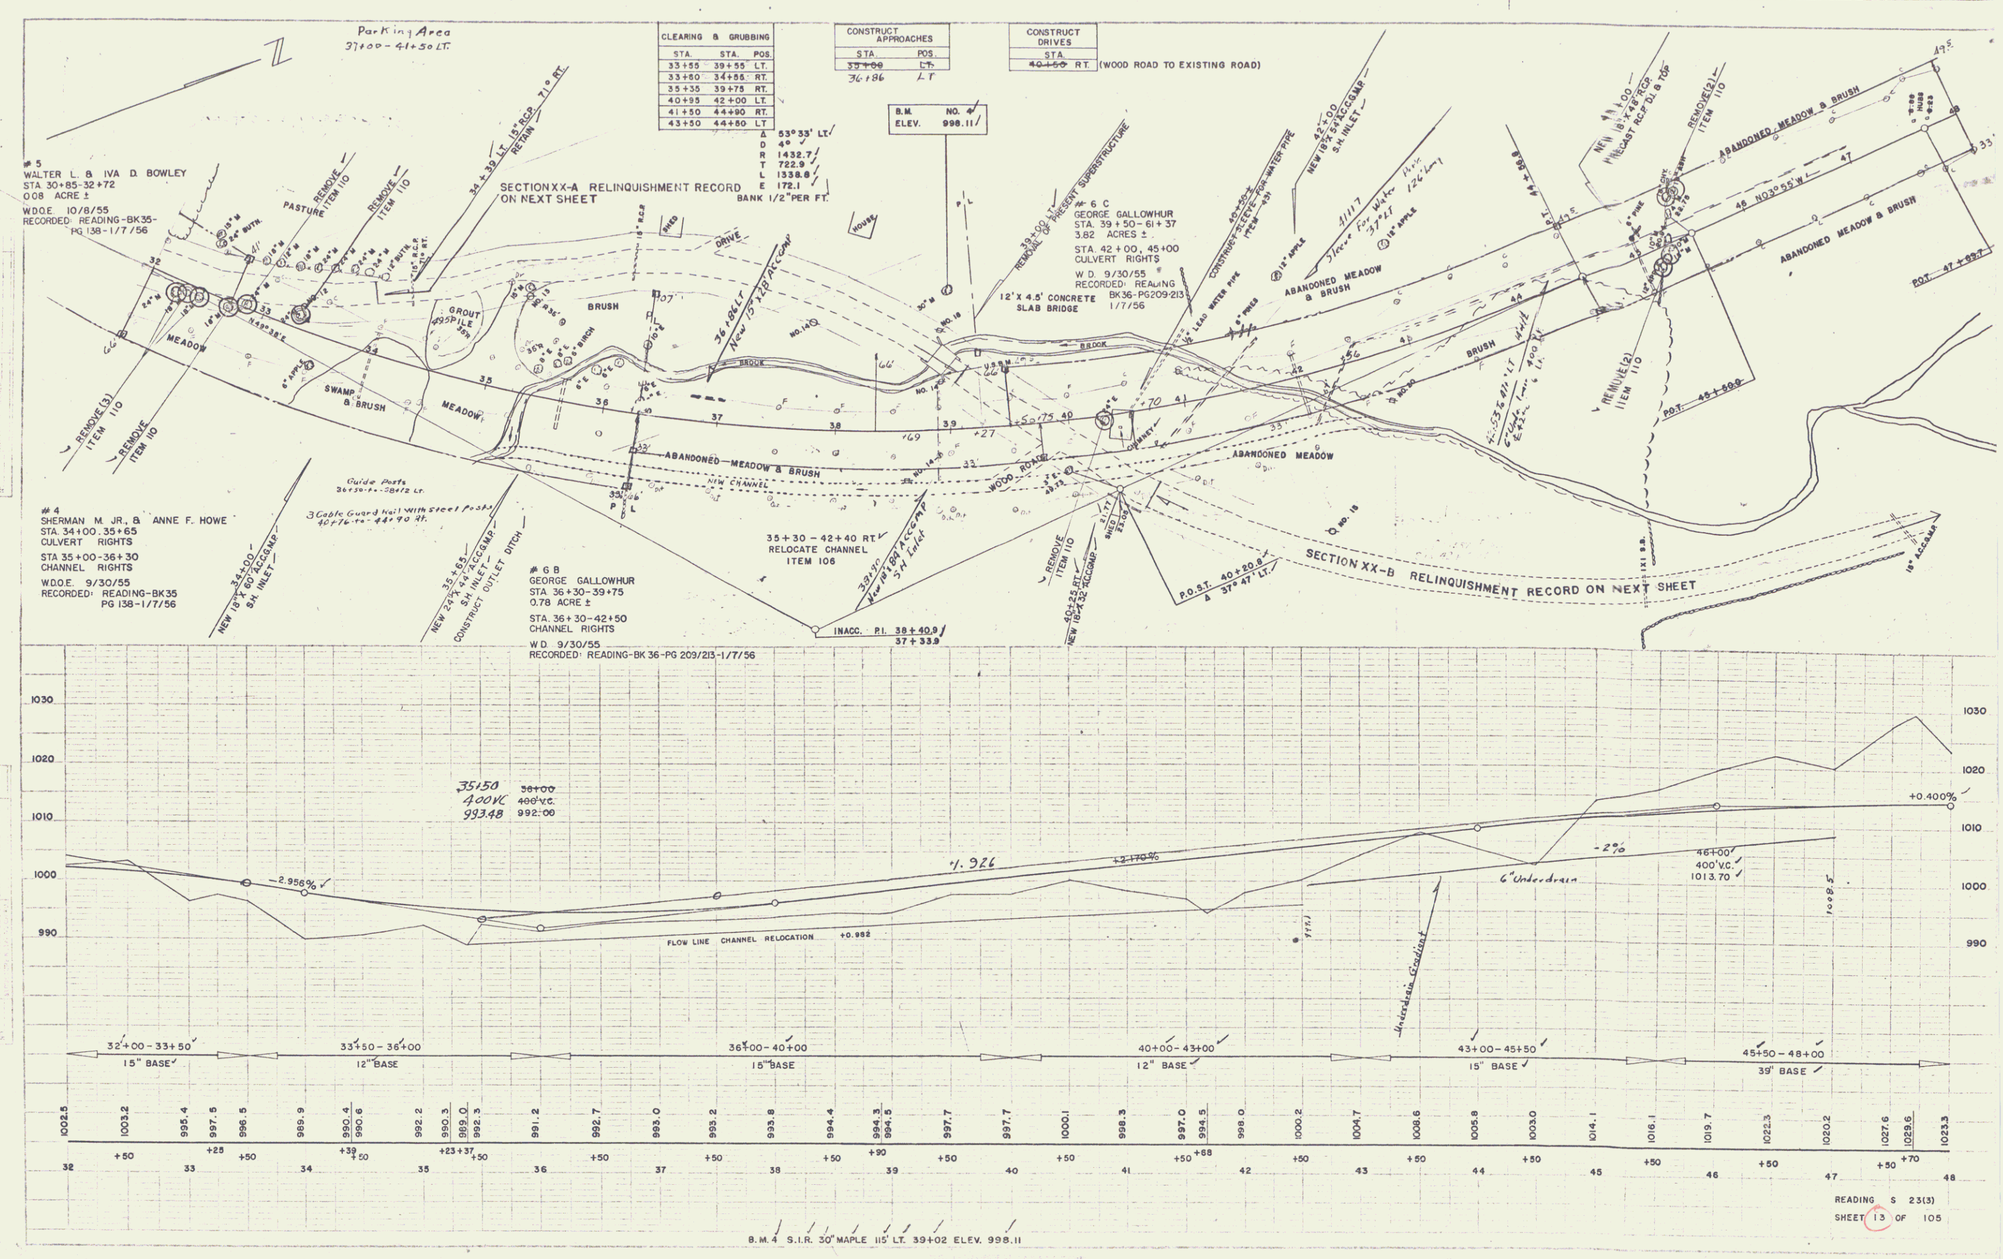

5