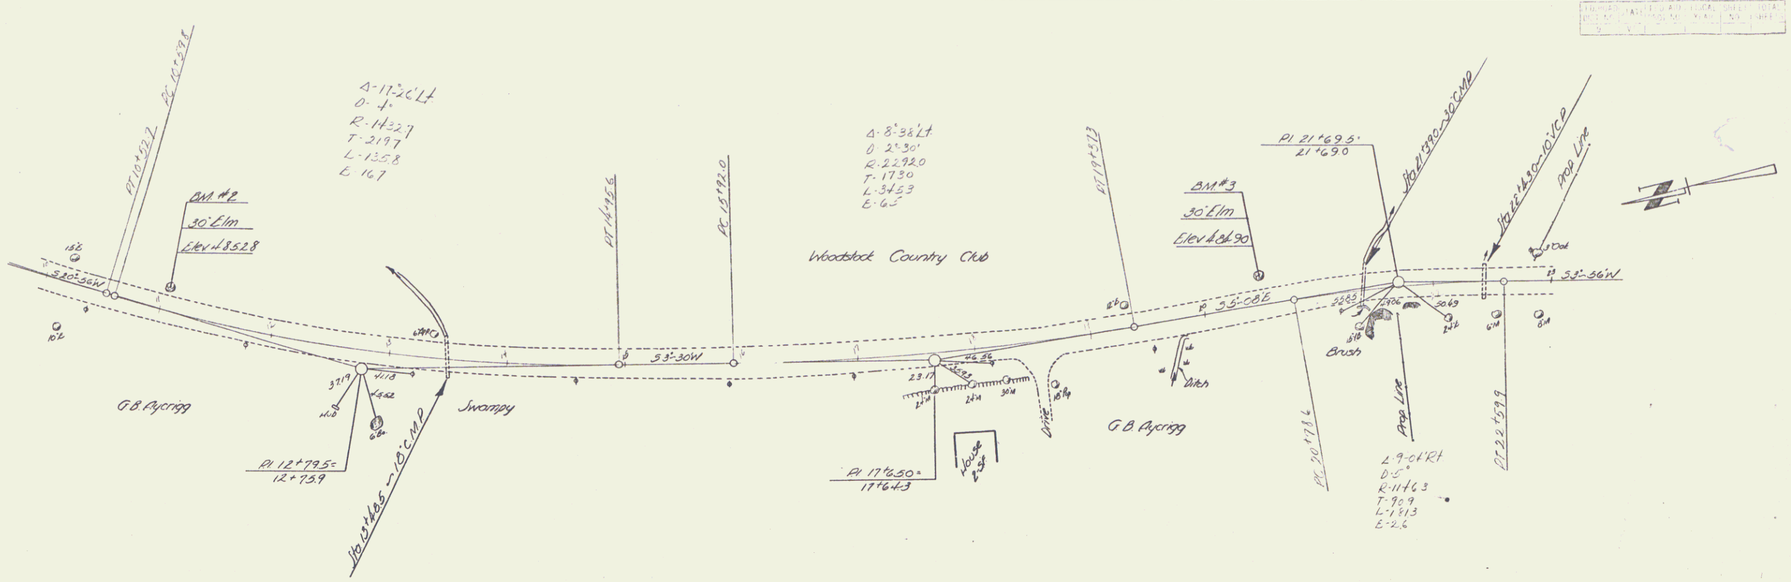

10	11	12	13	14	15	16	17	18	19	20	21	22	23
BM#2 J1R 30" Elm 16.5'Lt of Sta 11+05 Elev 485.28													
BM#3 " " " 20.5 " " 20+32 " 484.90													

Woodstock Jo. Woodstock Road
Route 106
SHEET 2

2