NRM
BIF 1933 5 11

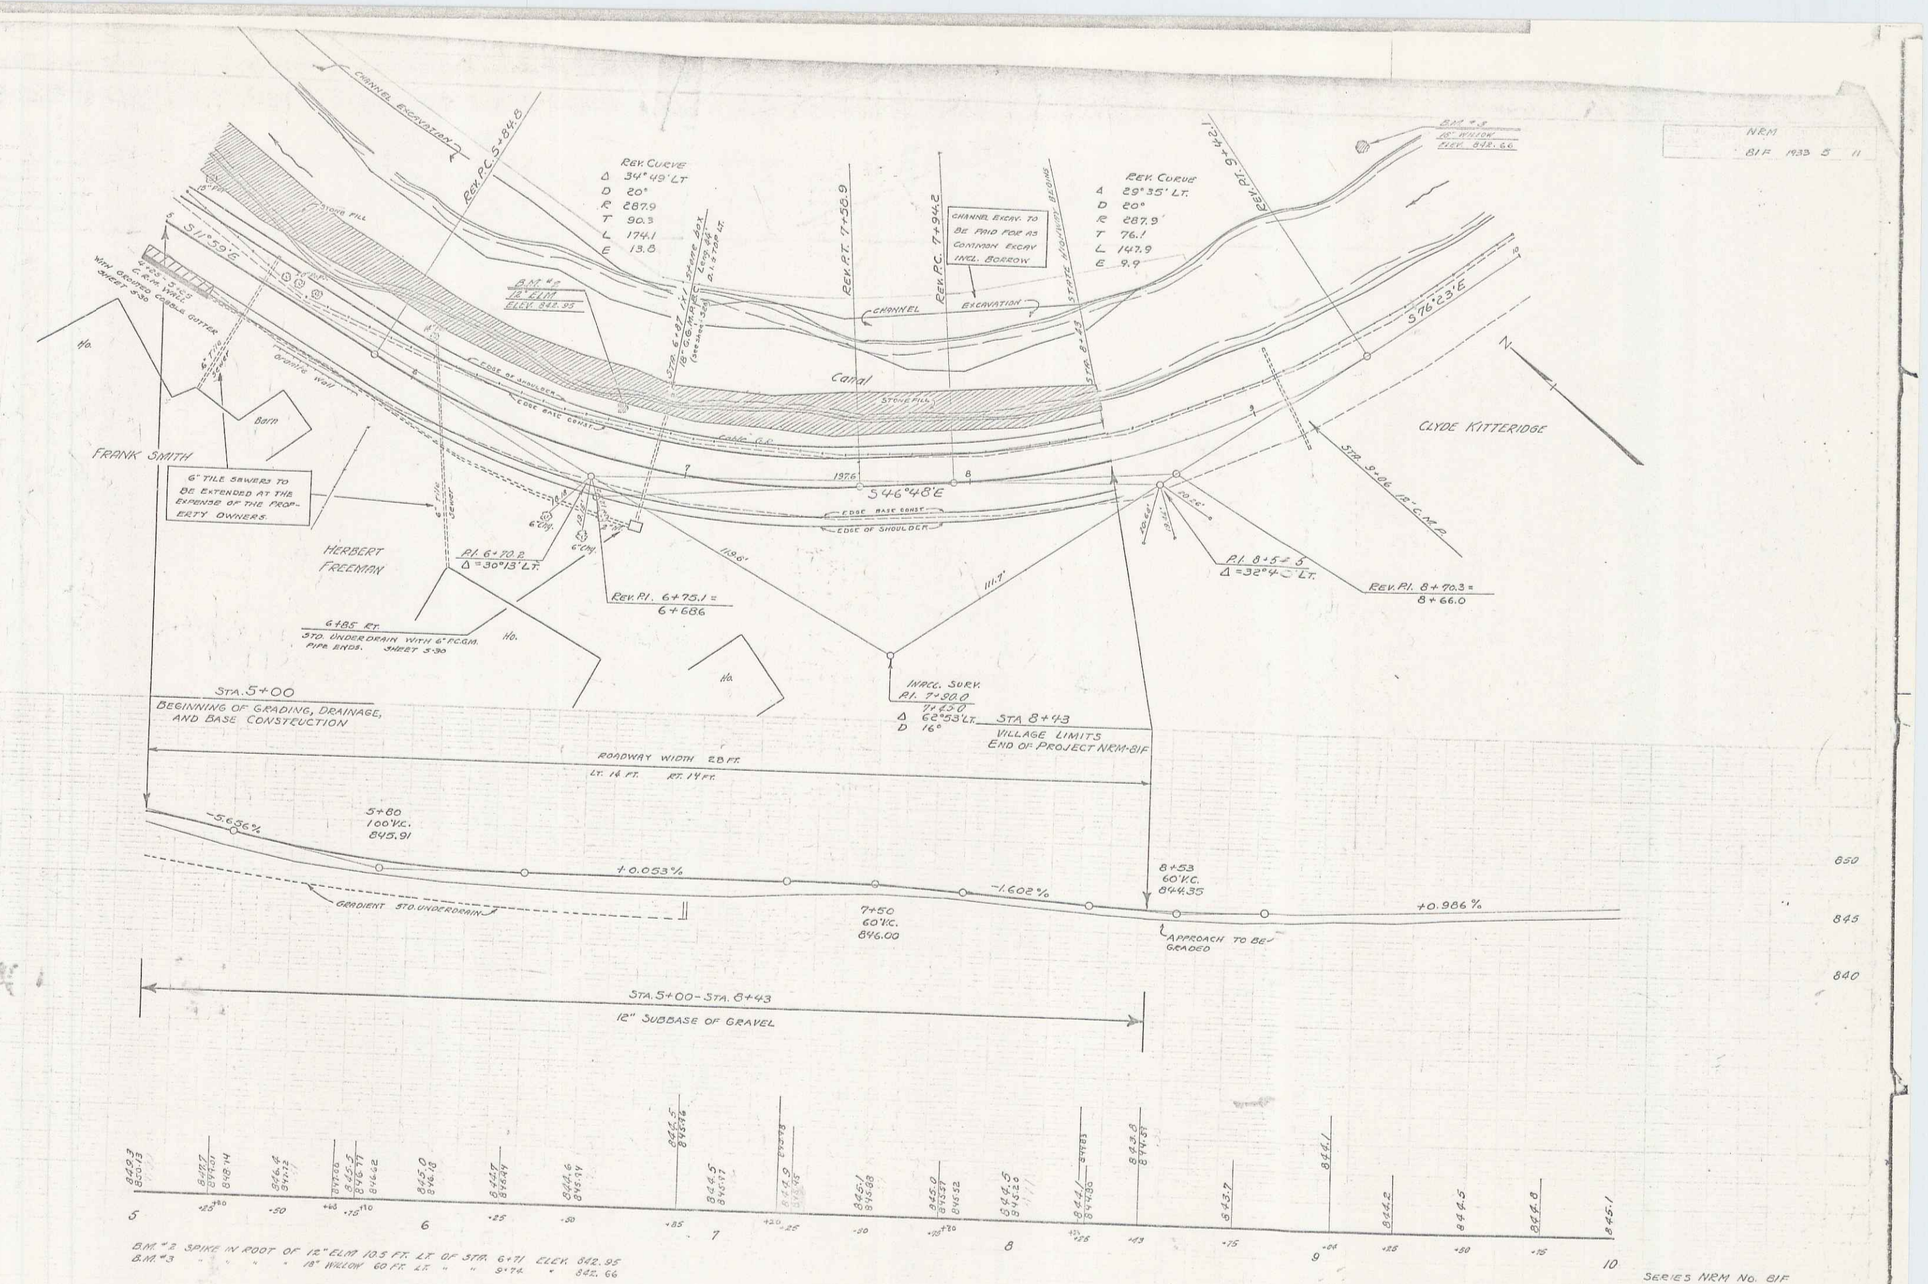

Series NRM No. 81F
Sheet 5 of 11

3