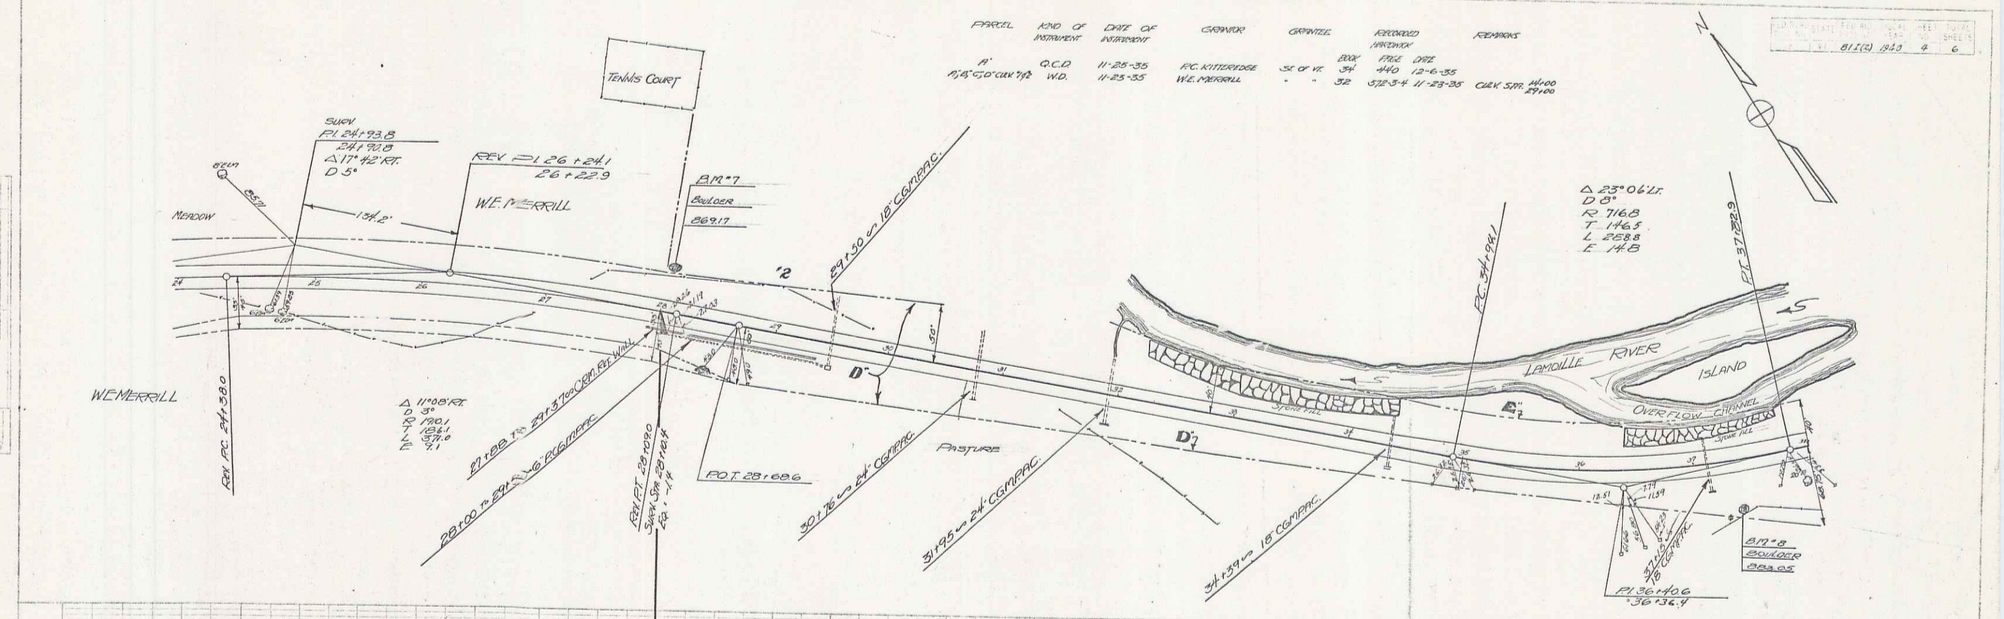PARCEL	KIND OF INSTRUMENT	DATE OF INSTRUMENT	GRANTOR	GRANTEE	RECORDED IN HARDWICK BOOK	PAGE	DATE	REMARKS
A	Q.C.D.	11-25-35	F.C. KITTERIDGE	SE of Vt.	34	440	12-6-35	
P.1.5'-5.0' CLEV. T/R	W.D.	11-23-35	W.E. MERRILL	" "	32	372-3-4	11-23-35	CLEV. S.P.R. 14+00 27+00