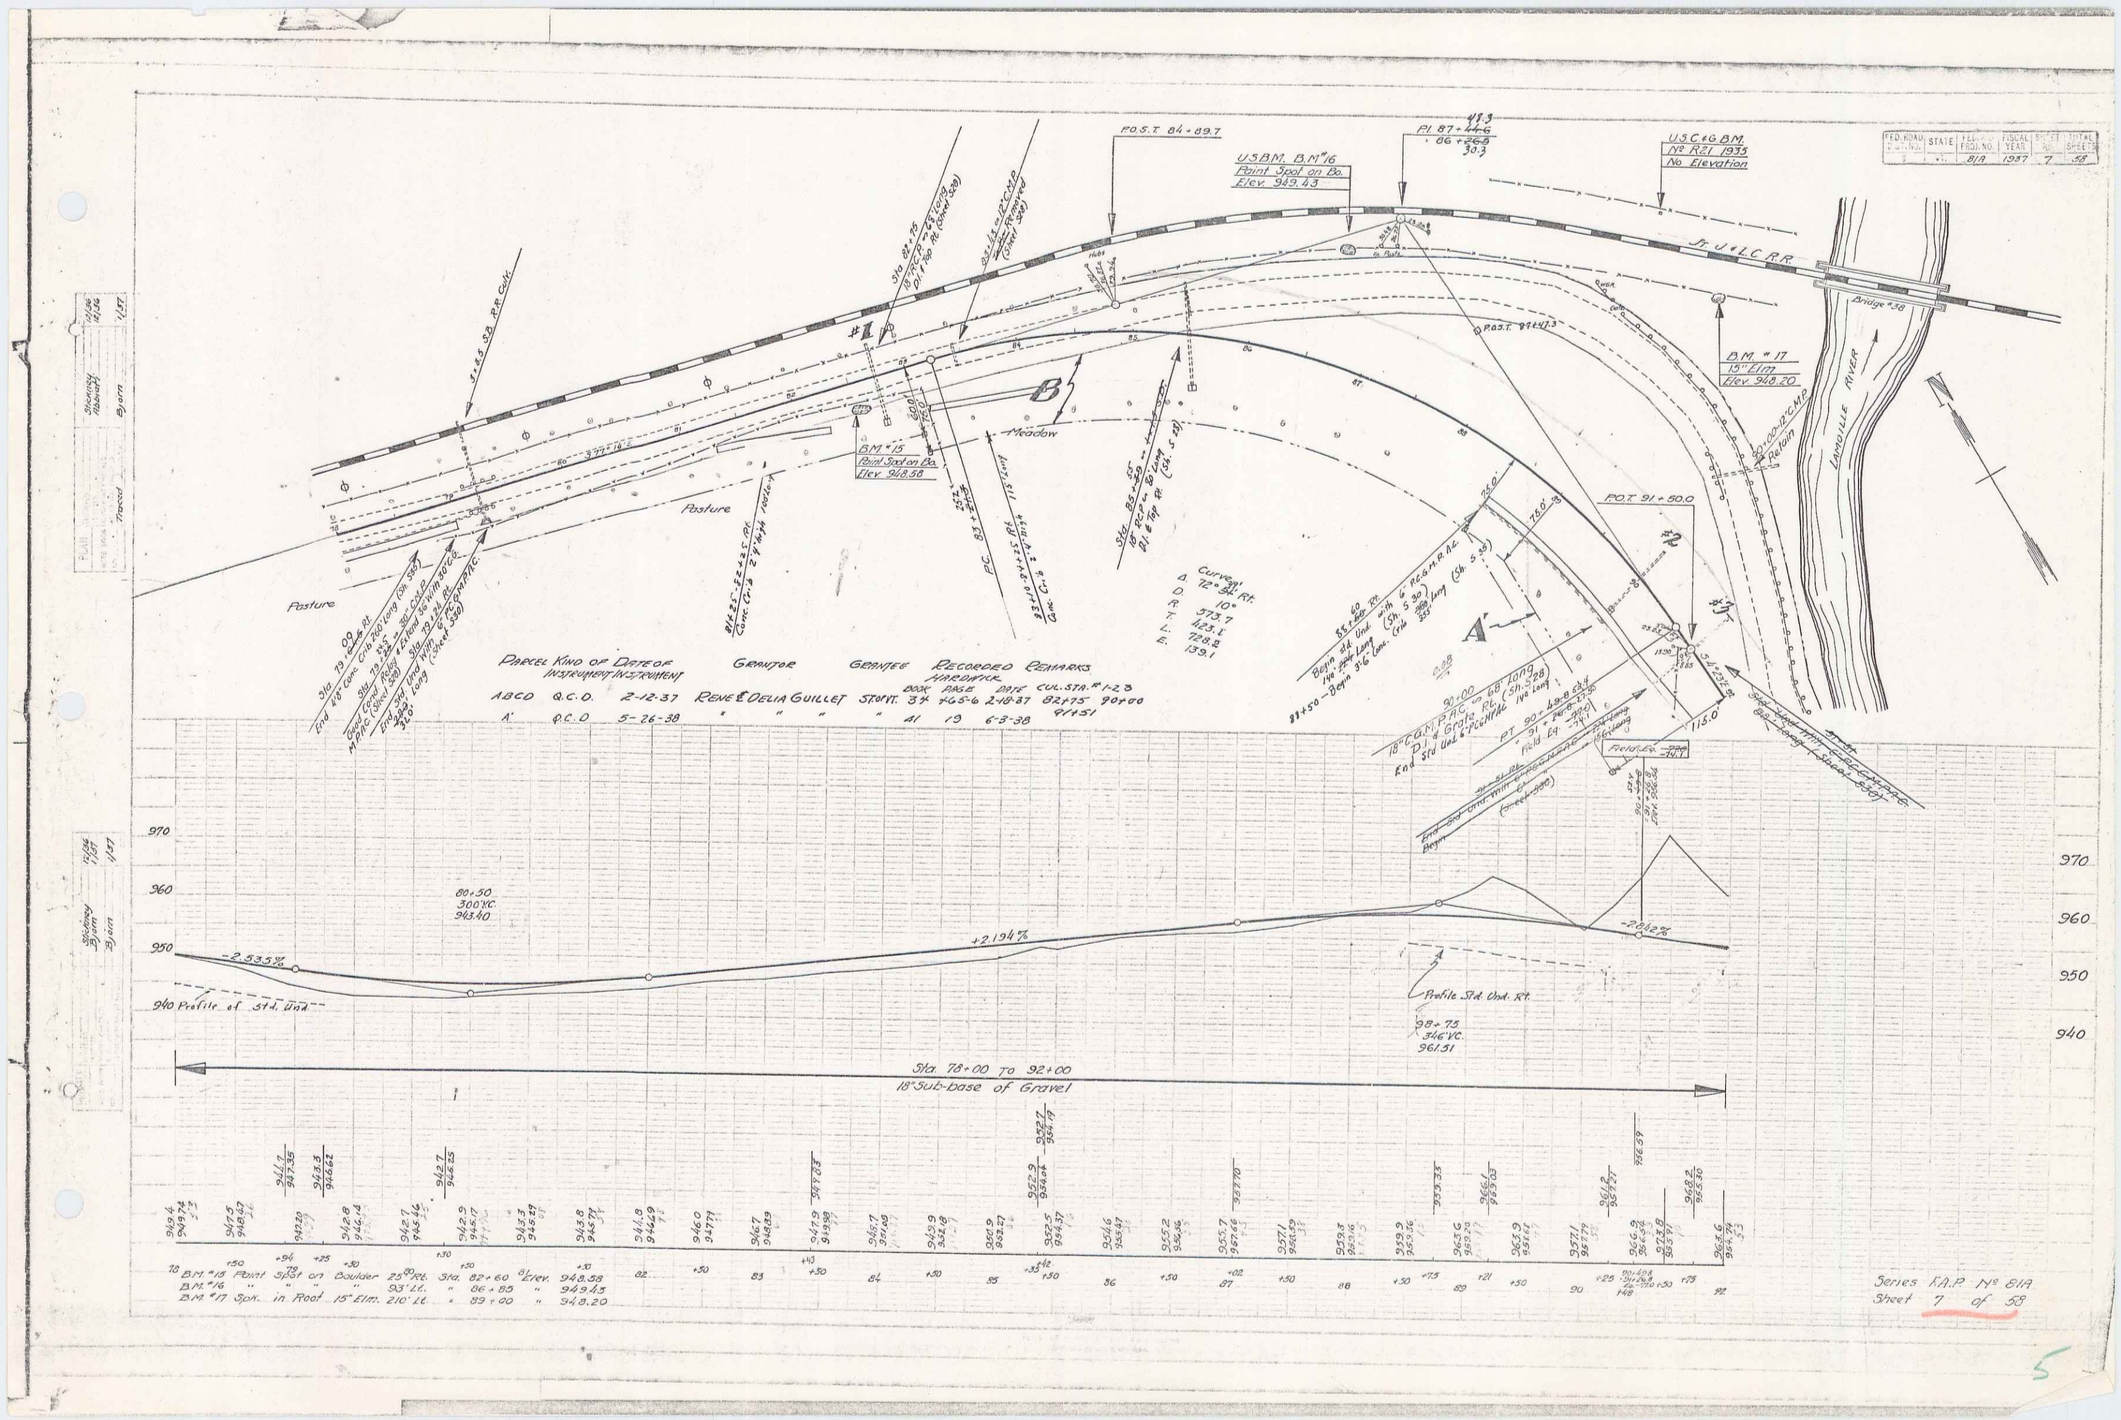
FED. ROAD DIST. NO. | STATE | FED. AID PROJ. NO. | FISCAL YEAR | SHEET NO. | TOTAL SHEETS
2 | VT. | 819 | 1937 | 7 | 58
P.O.S.T. 84+89.7
U.S.B.M. B.M. #16
Paint Spot on Bo.
Elev. 949.43
P.I. 87+46.6
U.S.C.&G.B.M.
No R21 1935
No Elevation
Jct. U.&L.C.R.R.
Bridge #58
LAMOILLE RIVER
B.M. #17
15" Elm.
Elev. 948.20
B.M. #15
Paint Spot on Bo.
Elev. 948.58
Meadow
Pasture
P.O.T. 91+50.0
Curve:
12°30' Rt.
D 10°
R 573.7
T 123.1
L 128.2
E 13.9
Parcel Kind of Instrument Date of Instrument Grantor Grantee Recorded Book Page Date Remarks
ABCD Q.C.D. 2-12-37 Reve & Delia Guillet State Vt. 34 465-6 2-18-37 Cul. Sta. 82+75 90+00
A' Q.C.D. 5-26-38 " " " " 41 13 6-3-38 91+51
Profile of Std. Und.
Profile Std. Und. Rt.
-2.535%
+2.194%
-2.062%
Sta. 78+00 to 92+00
18" Sub-base of Gravel
Series F.A.P. No. 81A
Sheet 7 of 58