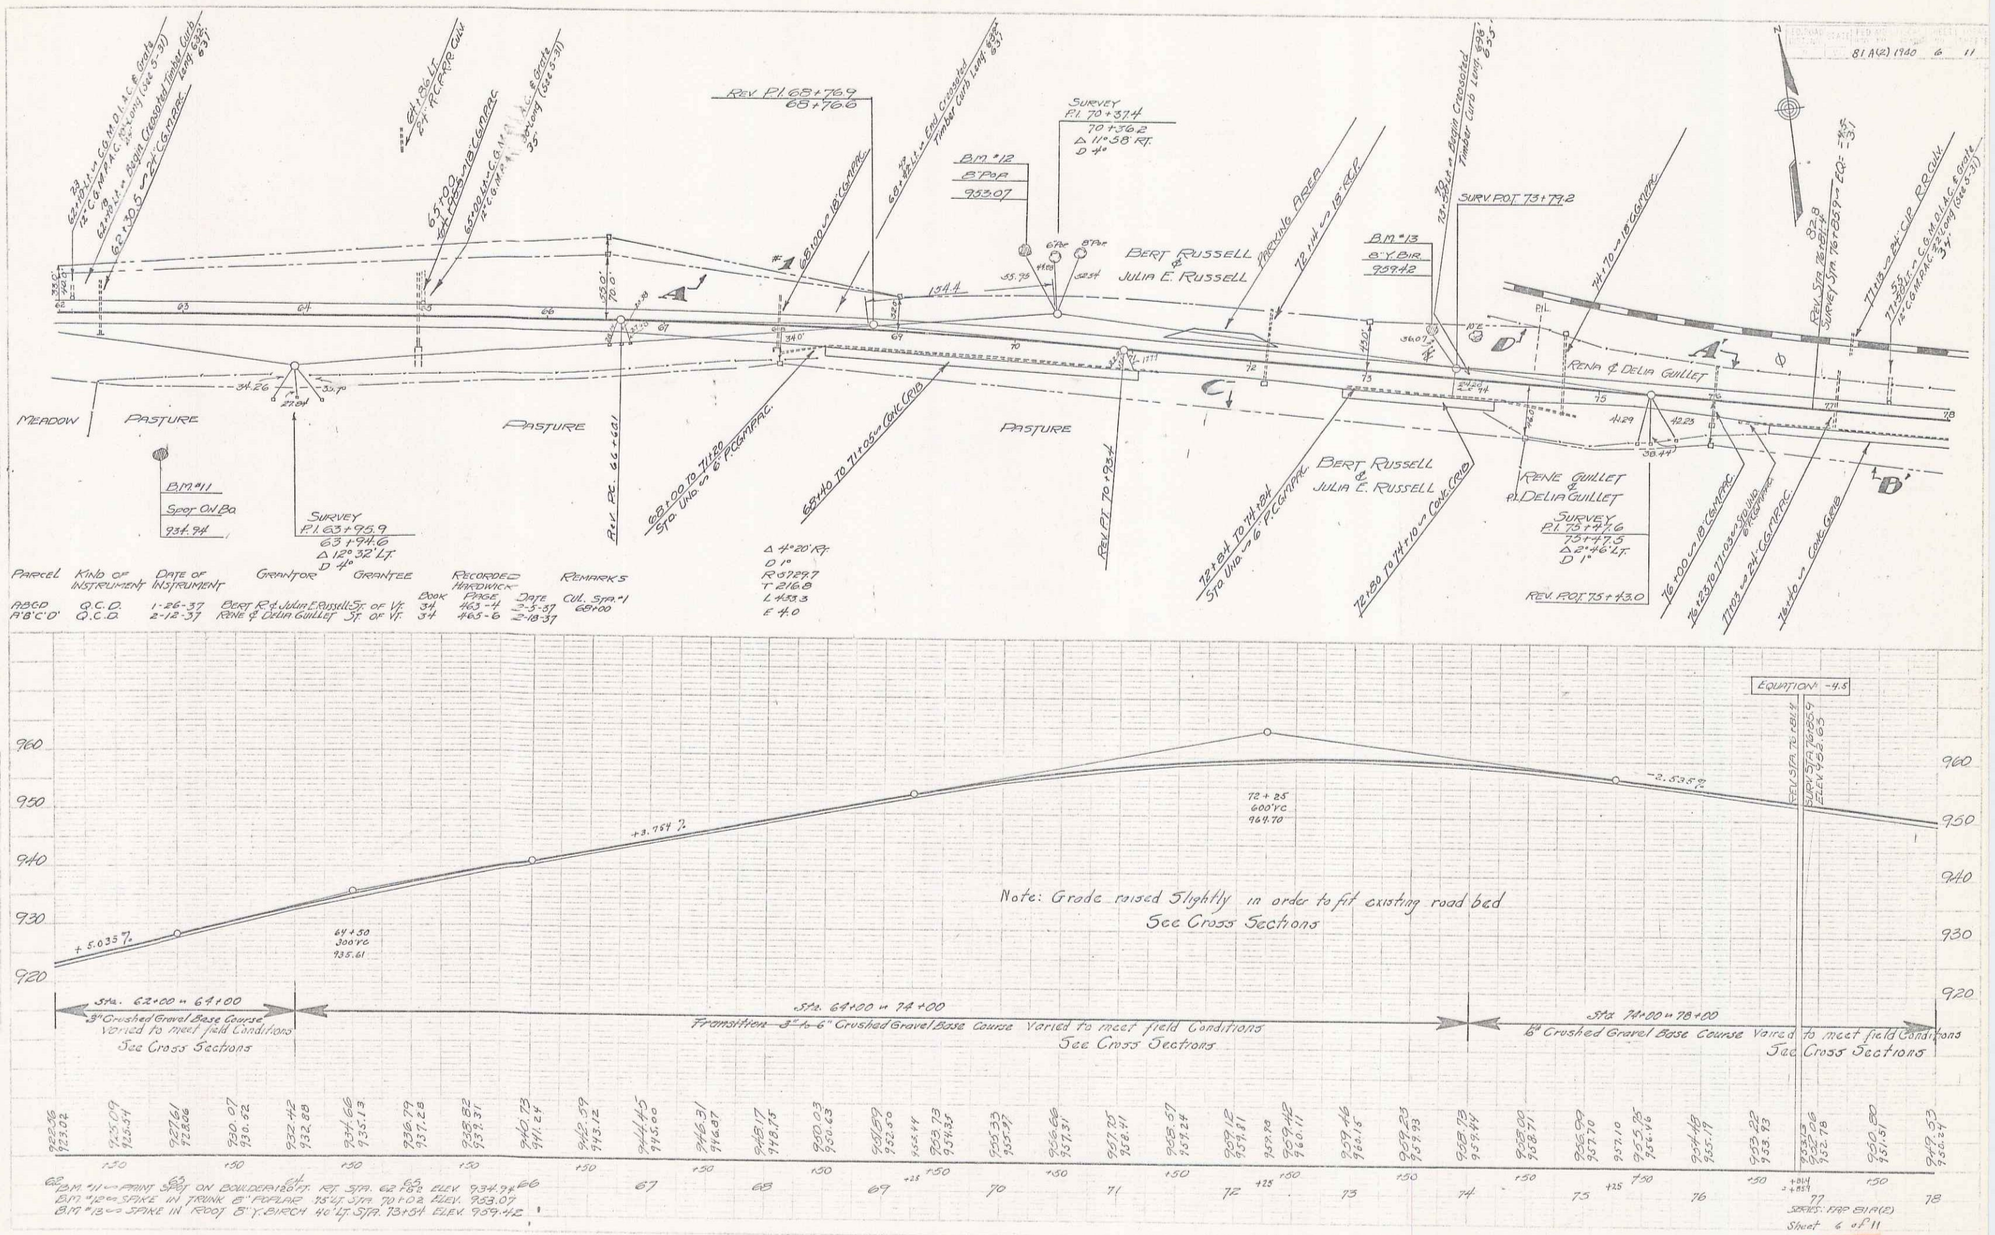
81 A(2) 1940 6 11
Rev. P.I. 68+76.9
68+76.6
Survey P.I. 70+37.4
70+36.2
Δ 11°58' Rt.
D 4°
B.M. #12
8" Pop
953.07
Bert & Julia E. Russell
B.M. #13
8" Y. Bir.
959.42
Surv. P.O.T. 73+79.2
Rena & Delia Guillet
Meadow
Pasture
Pasture
Pasture
B.M. #11
Spot On Bo.
934.94
Survey P.I. 63+75.9
63+94.6
Δ 12°32' Lt.
D 4°
Rev. Pt. 66+68.1
Rev. P.T. 70+93.4
Bert Russell & Julia E. Russell
Rene Guillet & Delia Guillet
Survey P.I. 73+47.6
73+47.5
Δ 2°46' Lt.
D 1°
Rev. P.O.T. 73+43.0
Δ 4°20' Rt.
D 1°
R 1297.7
T 216.8
L 433.3
E 4.0
Parcel | Kind of Instrument | Date of Instrument | Grantor | Grantee | Recorded Book | Page | Date | Remarks
A'B'C'D' | Q.C.D. | 1-26-37 | Bert R. & Julia E. Russell Sr. of Vt. | Sr. of Vt. | 34 | 463-4 | 2-5-37 | Cul. Sta. #1
A'B'C'D' | Q.C.D. | 2-12-37 | Rene & Delia Guillet | Sr. of Vt. | 34 | 465-6 | 2-18-37 | 68+00
Equation: -4.5
Rev. Sta. 70+18.4
Surv. Sta. 70+85.9
Elev. 962.63
+5.035%
+3.754%
-2.535%
64+50
300' VC
935.61
72+25
600' VC
964.70
Note: Grade raised slightly in order to fit existing road bed
See Cross Sections
Sta. 62+00 to 64+00
3" Crushed Gravel Base Course
Varied to meet field Conditions
See Cross Sections
Sta. 64+00 to 74+00
Transition 3" to 6" Crushed Gravel Base Course Varied to meet field Conditions
See Cross Sections
Sta. 74+00 to 78+00
6" Crushed Gravel Base Course Varied to meet field Conditions
See Cross Sections
B.M. #11 = Point Spot on Boulder 180' Rt. Sta. 62+85 Elev. 934.94
B.M. #12 = Spike in Trunk 8" Poplar 15' Lt. Sta. 70+02 Elev. 953.07
B.M. #13 = Spike in Root 8" Y. Birch 40' Lt. Sta. 73+81 Elev. 959.42
Series: Tap 81 A(2)
Sheet 6 of 11
4