BI B 1937 7 102

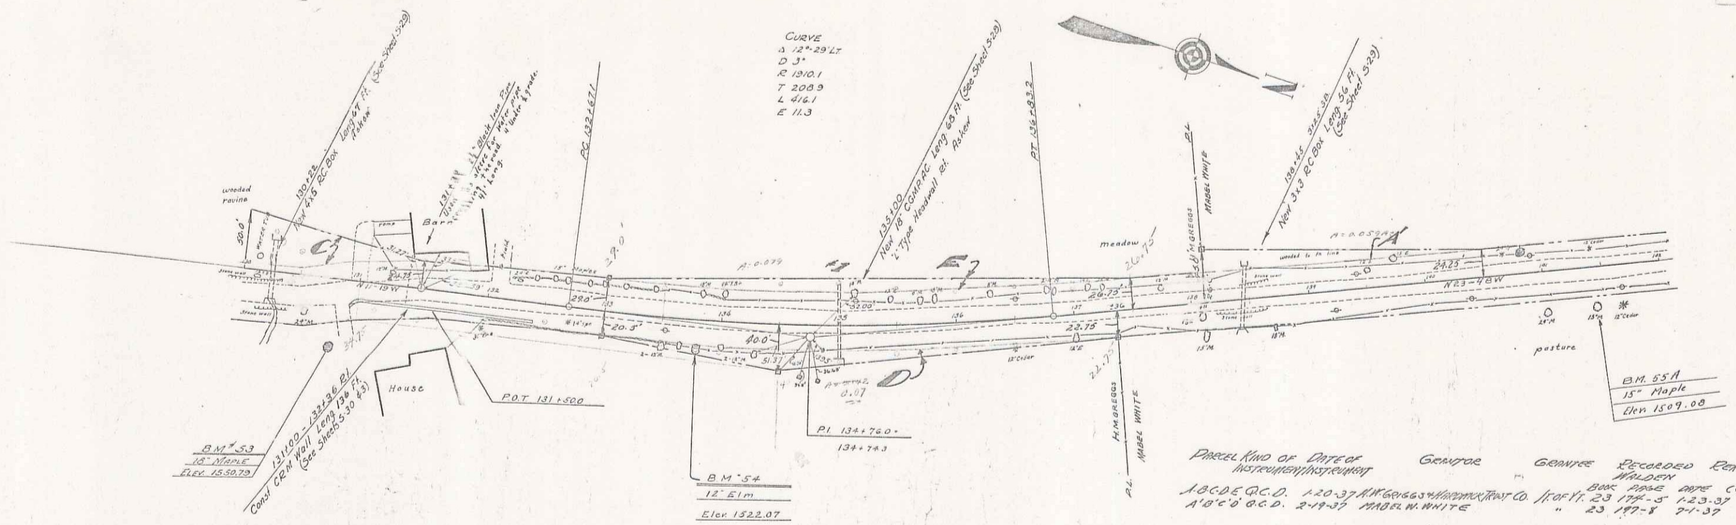

Parcel	Kind of Instrument	Date of Instrument	Grantor	Grantee	Recorded Book	Page	Date	Remarks Walden Cul. Stn. #2
A B C D E F G C D		1-20-37	A.W. Geiggs & Hardwood Prod. Co.	Vt. of Vt.	23	177-5	1-23-37	135+00
A' B' C' D' G C D		2-19-37	Mabel W. White	"	23	187-8	2-1-37	

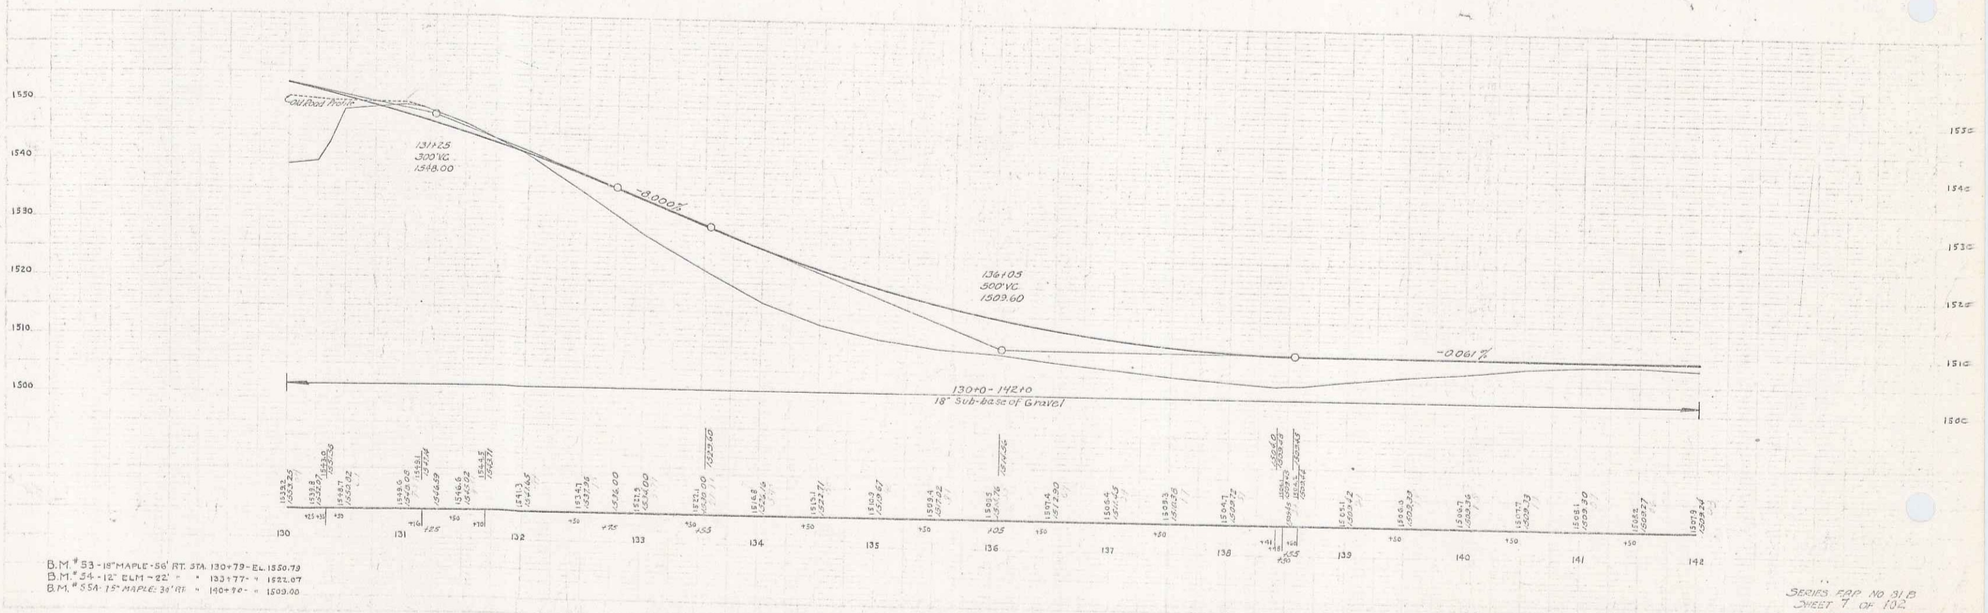

B.M. #53 - 18" MAPLE - 56' RT. STA. 130+79 - EL. 1550.79
B.M. #54 - 12" ELM - 22' " " 133+77 - " 1522.07
B.M. #55A - 15" MAPLE - 38' RT. " 140+90 - " 1509.00

SERIES FAP NO 31 B
SHEET 7 OF 102

4