81-B 1937 B 102

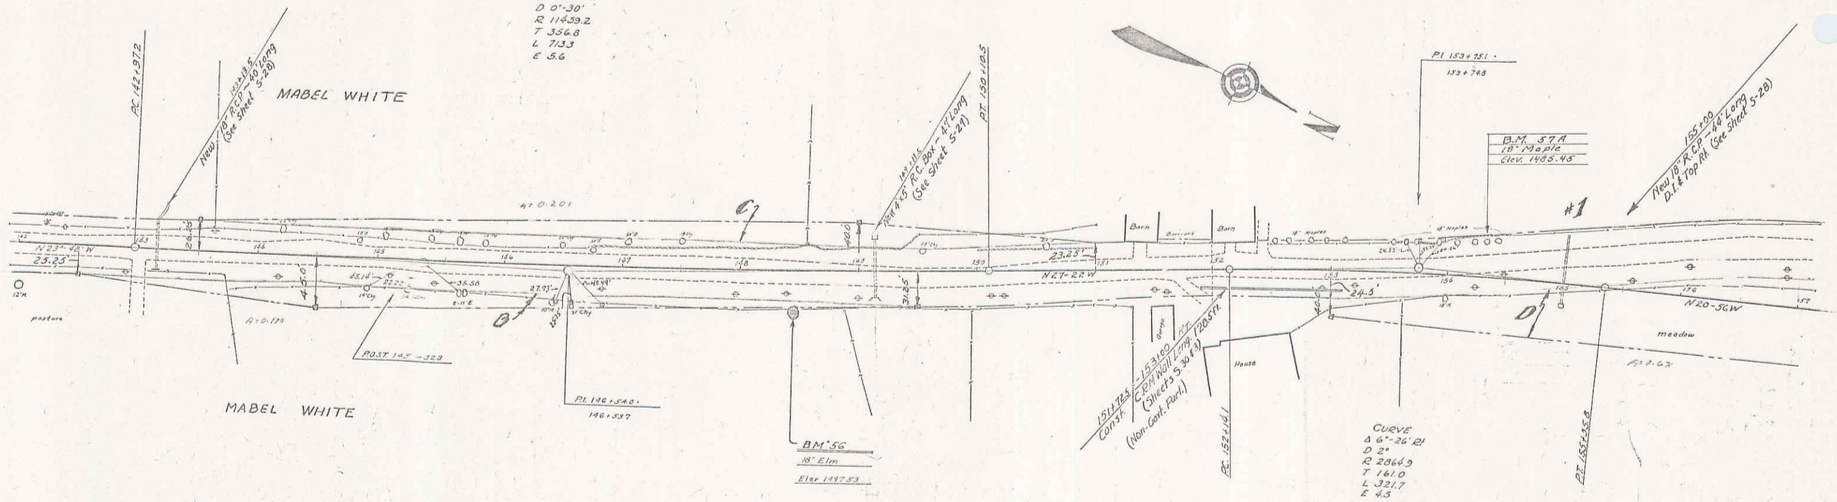

Parcel	Kind of Instrument	Date of Instrument	Grantor	Grantee	Recorded Book	Recorded Page	Remarks Date	Remarks Walden Col. #1
ABCO	Q.C.D.	2-19-37	MABEL W. WHITE	ST. OF VT.	23	197-B	7-1-37	STA. 155+00

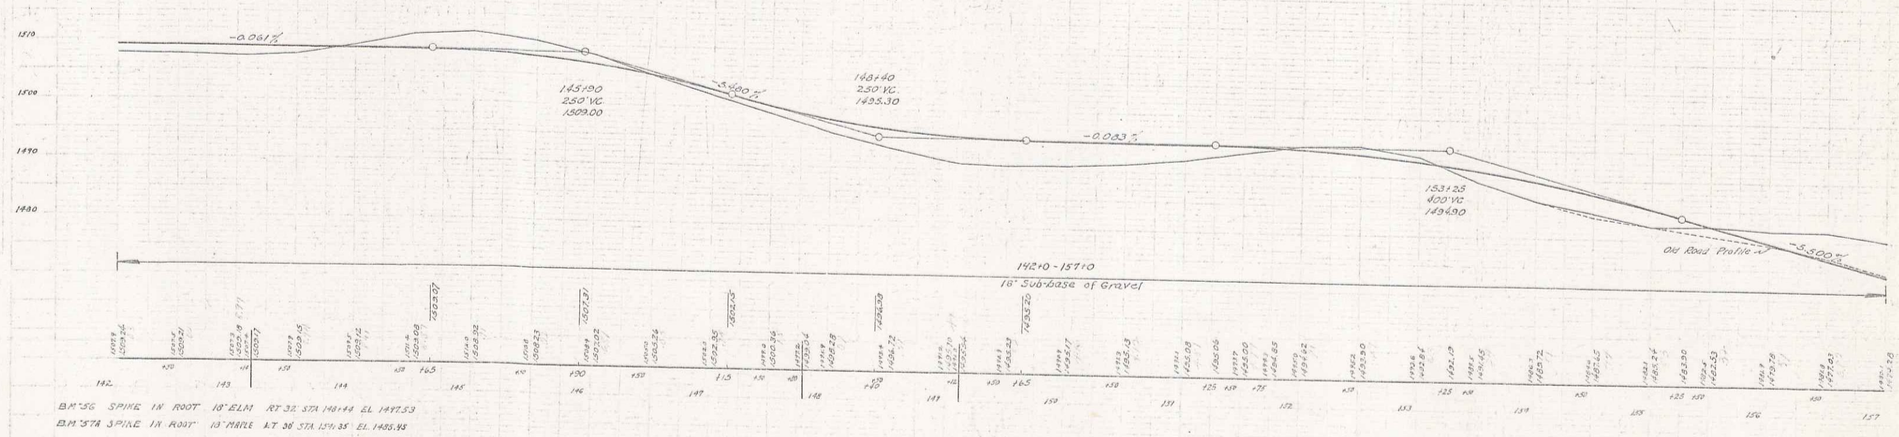

BM 56 SPIKE IN ROOT 18" ELM RT 32 STA 148+44 EL 1497.53

BM 57A SPIKE IN ROOT 18" MAPLE LT 36 STA 1541.35 EL 1485.45

SERIES FAP No 61B
SHEET 8 OF 102

5