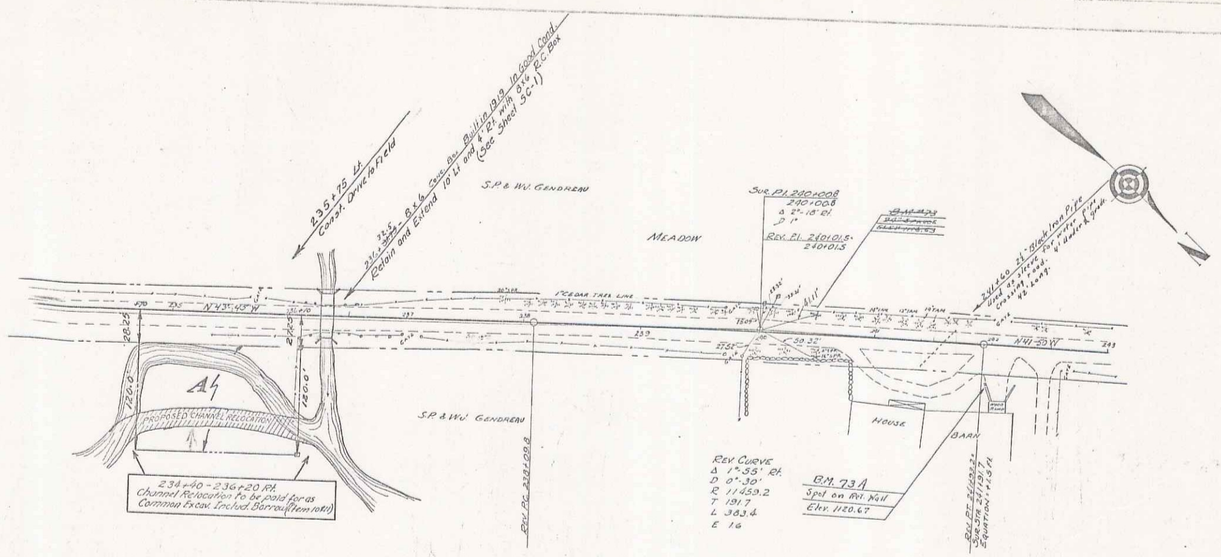

Parcel	Kind of Instrument	Date of Instrument	Grantor	Grantee	Recorded Walden Book	Page	Date	Remarks
1	B.C.D.	6-3-37	S.P. & W.J. Gendreau	State of Vt.	23	183-6	7-1-37	
"	Mtg. Release	5-26-37	Fed. Land Bank	"	23	183-4	7-1-37	
"	"	5-26-37	Fed. Farm Mortgage Corp.	"	23	181-2-3	7-1-37	

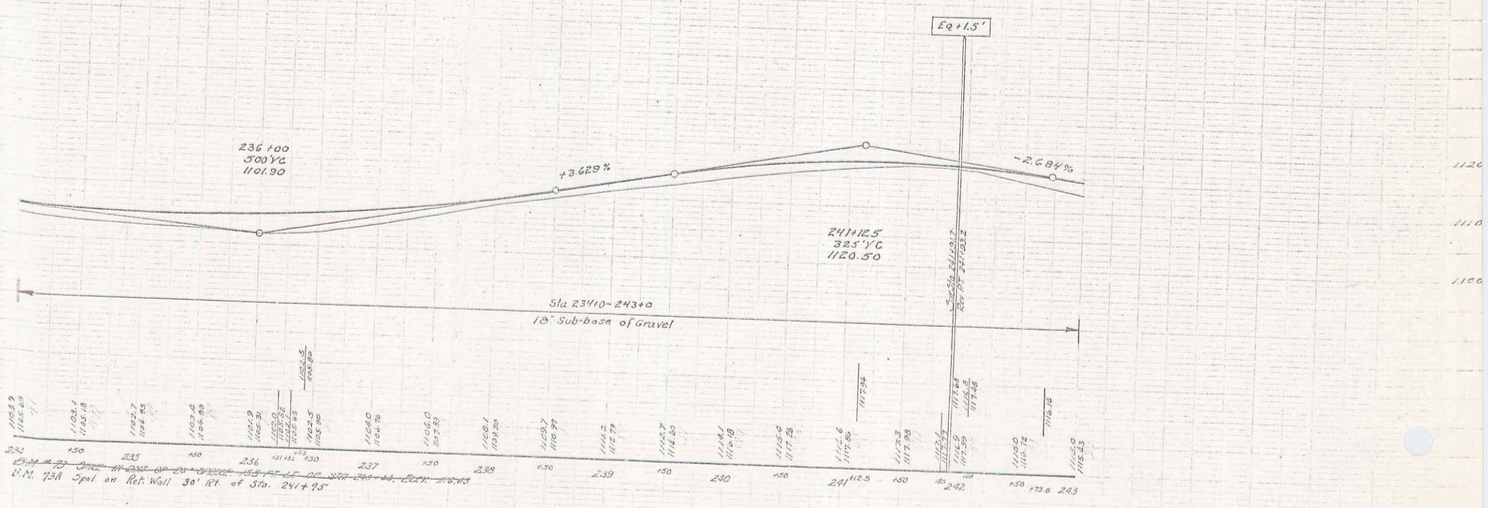

Series FAP no 81B
Sheet 14 of 102