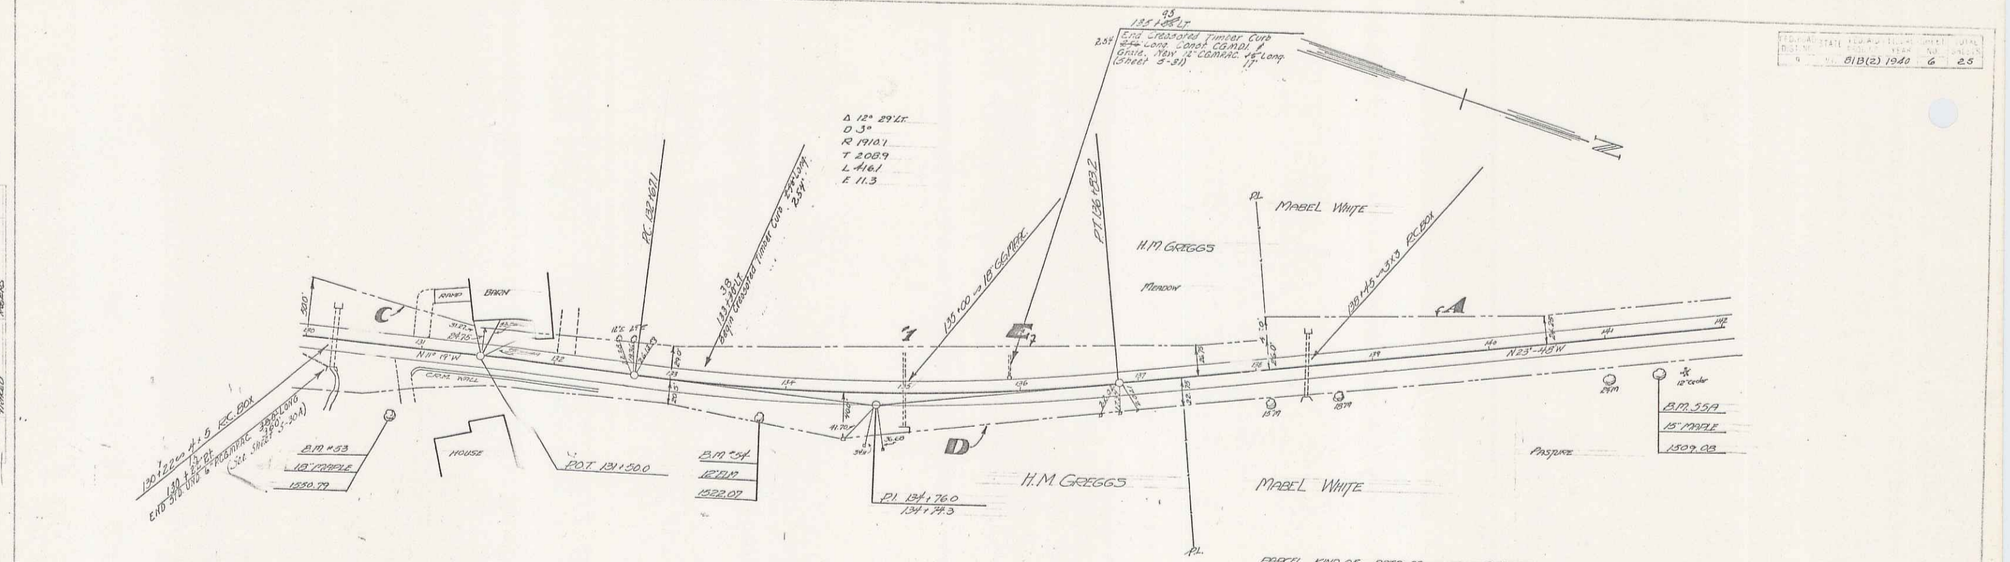

PARCEL	KIND OF INSTRUMENT	DATE OF INSTRUMENT	GRANTOR	GRANTEE	RECORDED WALDEN BOOK	PAGE	DATE	REMARKS COL. STA. ±
11.8'CO.F	QCD	1-20-37	H.M. GREGGS & HARDWICK TRUST CO.	State of Vt.	23	144-5	1-23-37	135+00
11.8'CO	QCD	2-19-37	MABEL W. WHITE	" "	23	147-8	7-1-37	

B.M. "53" ⟹ 18" MAPLE ⟹ 36' RT. STA. 130+77 EL. 1550.79
B.M. "54" ⟹ 12" ELM ⟹ 22' " " 133+77 " 1522.07
B.M. "55A" ⟹ 15" MAPLE ⟹ 30' " " 140+40 " 1507.08

4