9	V	818(2)	1950	9	25	

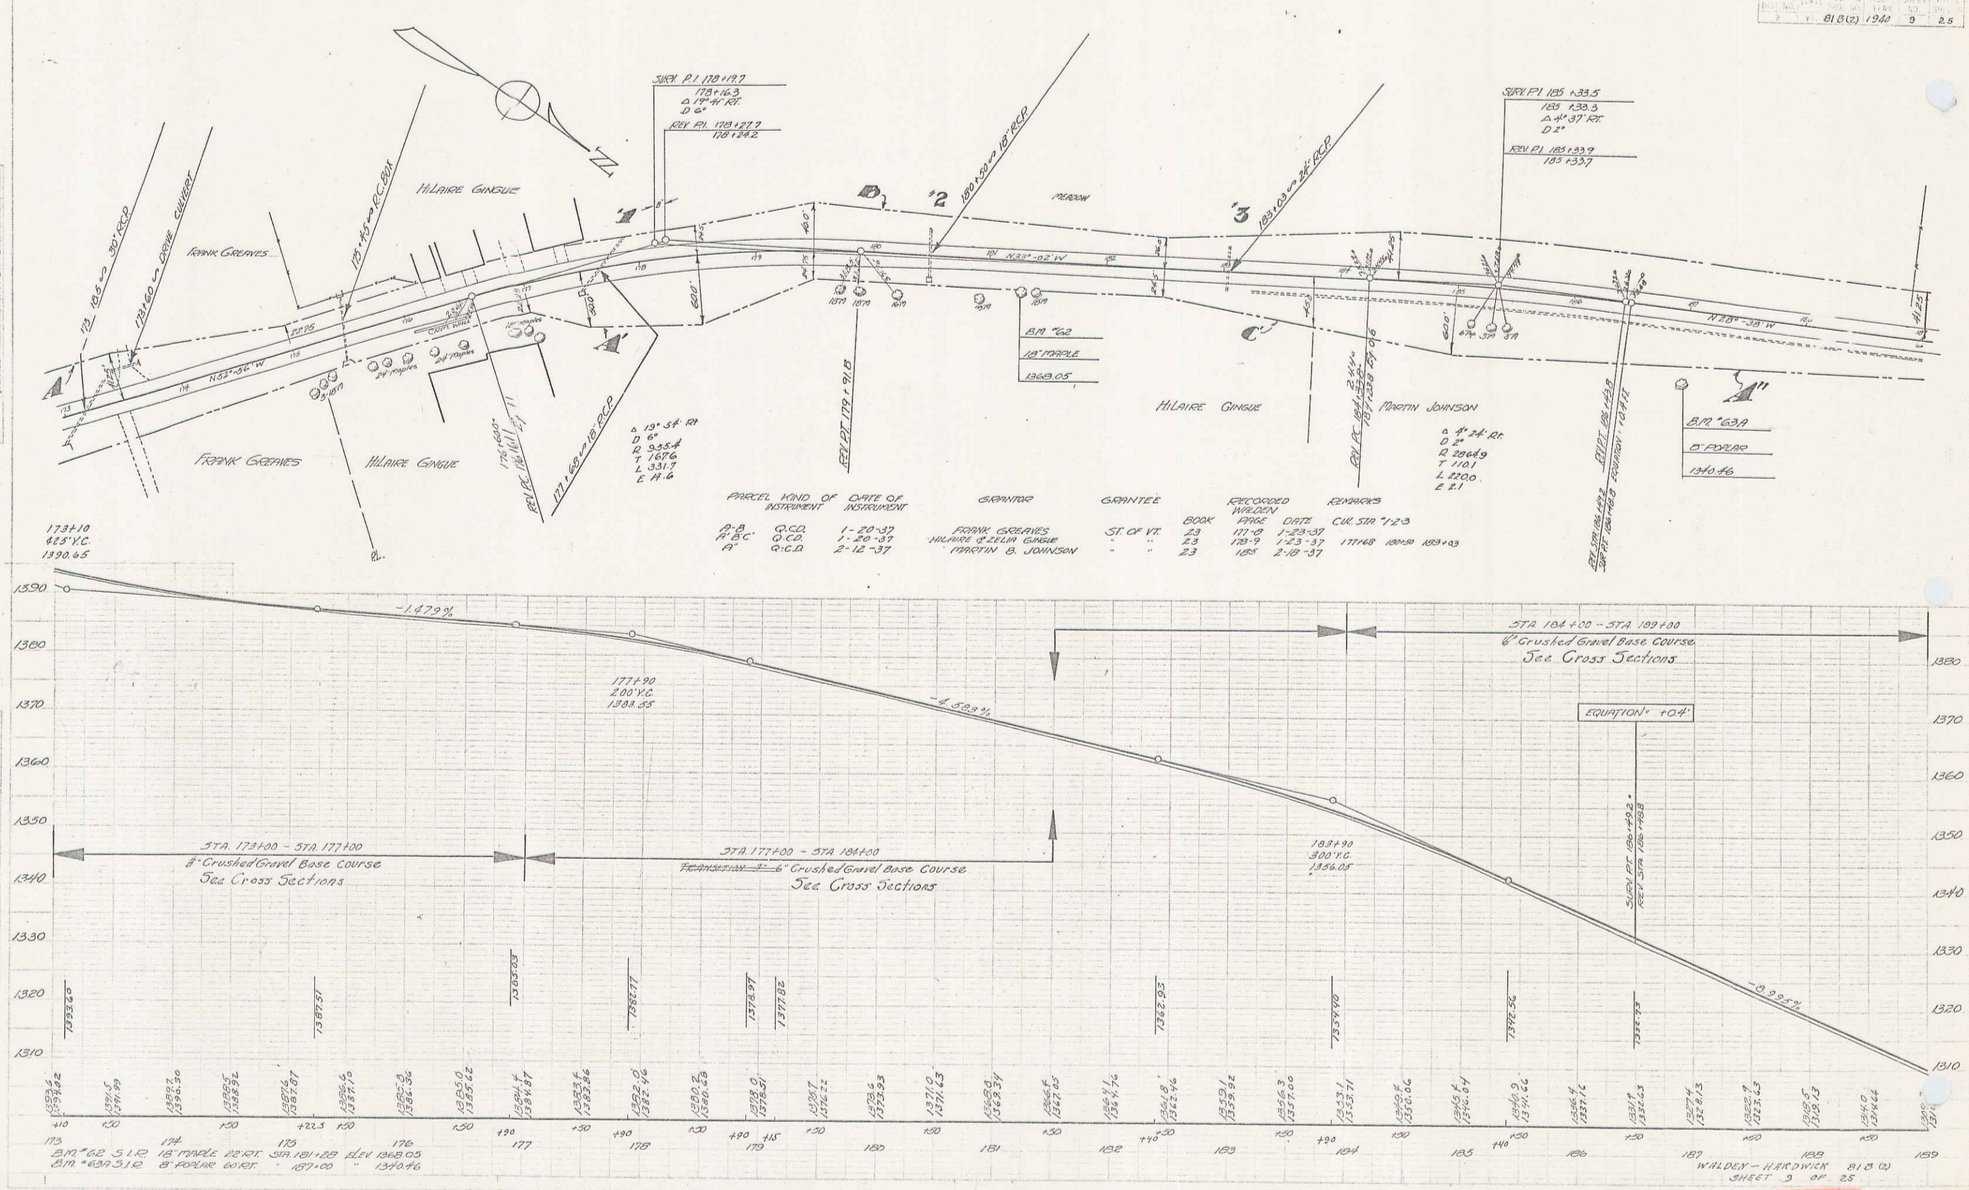

7