FED. ROAD DIST. NO.	STATE	FED. AID PROJ. NO.	FISCAL YEAR	SHEET NO.	TOTAL SHEETS
9	VT	BRO(2)	1940	19	25

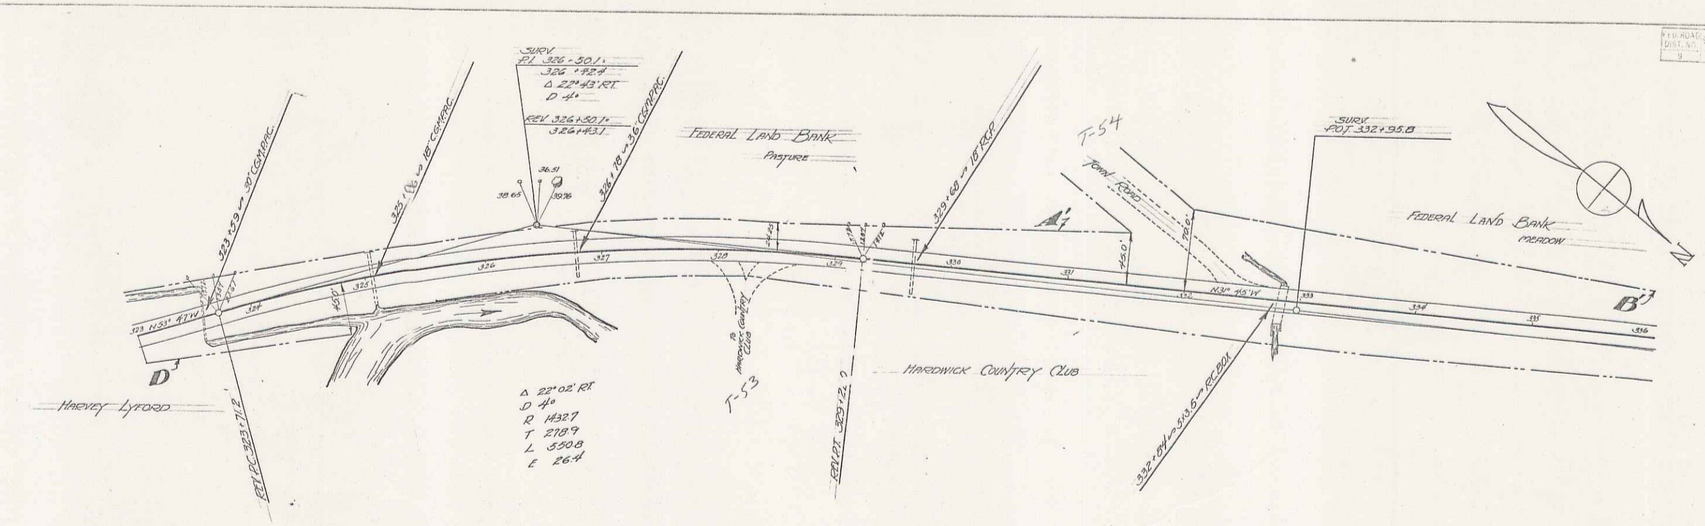

PARCEL	KIND OF INSTRUMENT	DATE OF INSTRUMENT	GRANTOR	GRANTEE	RECORDED HARDWICK BOOK	PAGE	DATE	REMARKS
ABCD	QCD	1-29-37	HARVEY & VIRAN LYFORD	ST. OF VT.	34	469-2	2-3-37	
A'B'	CONVMNT DEED	3-30-37	FED LAND BANK	"	36	617-8	4-17-37	

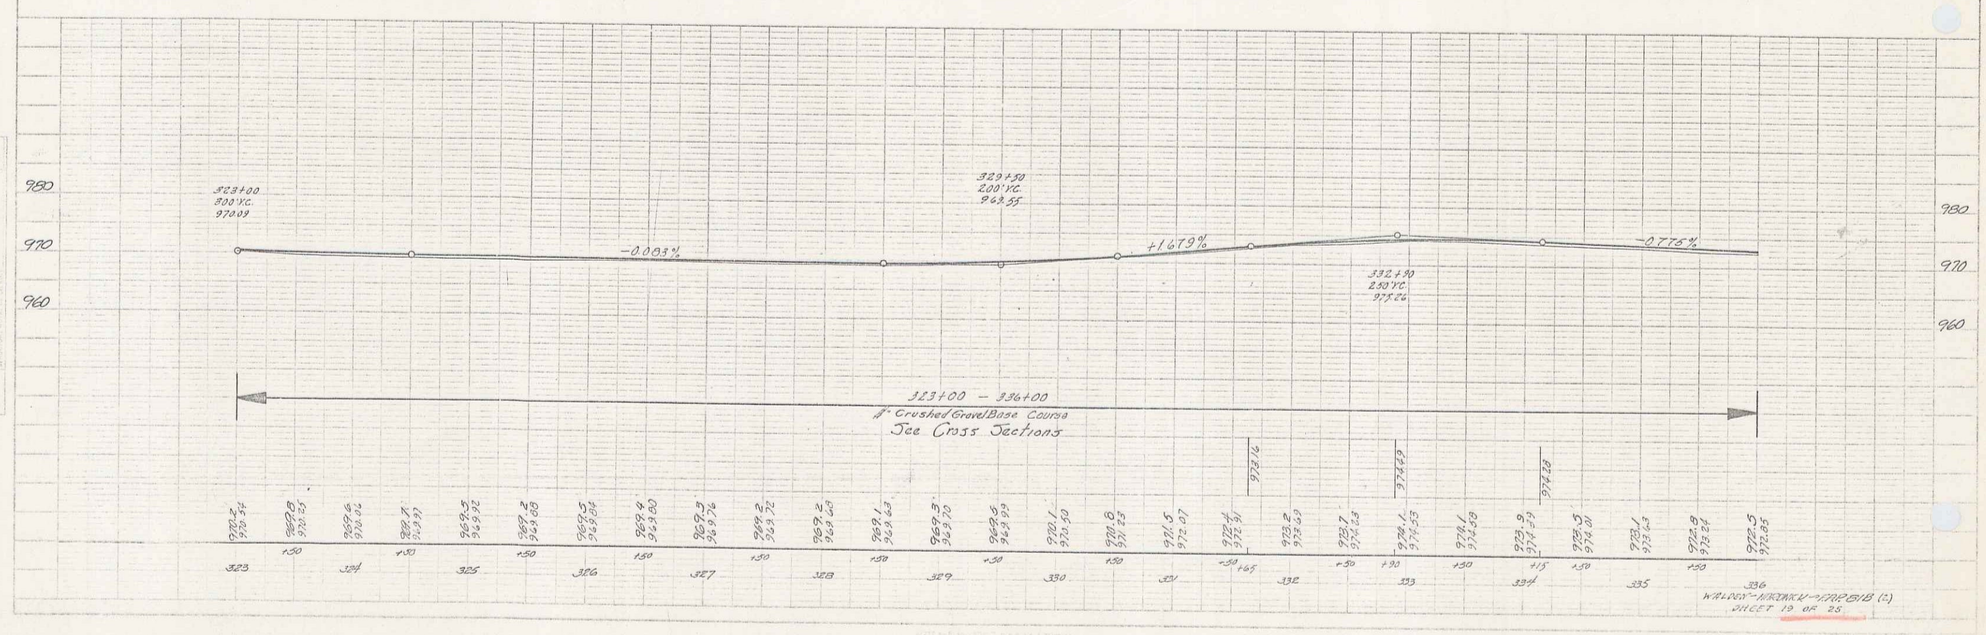

WALDEN-HARDWICK-STRP B18 (2)
SHEET 19 OF 25

17