




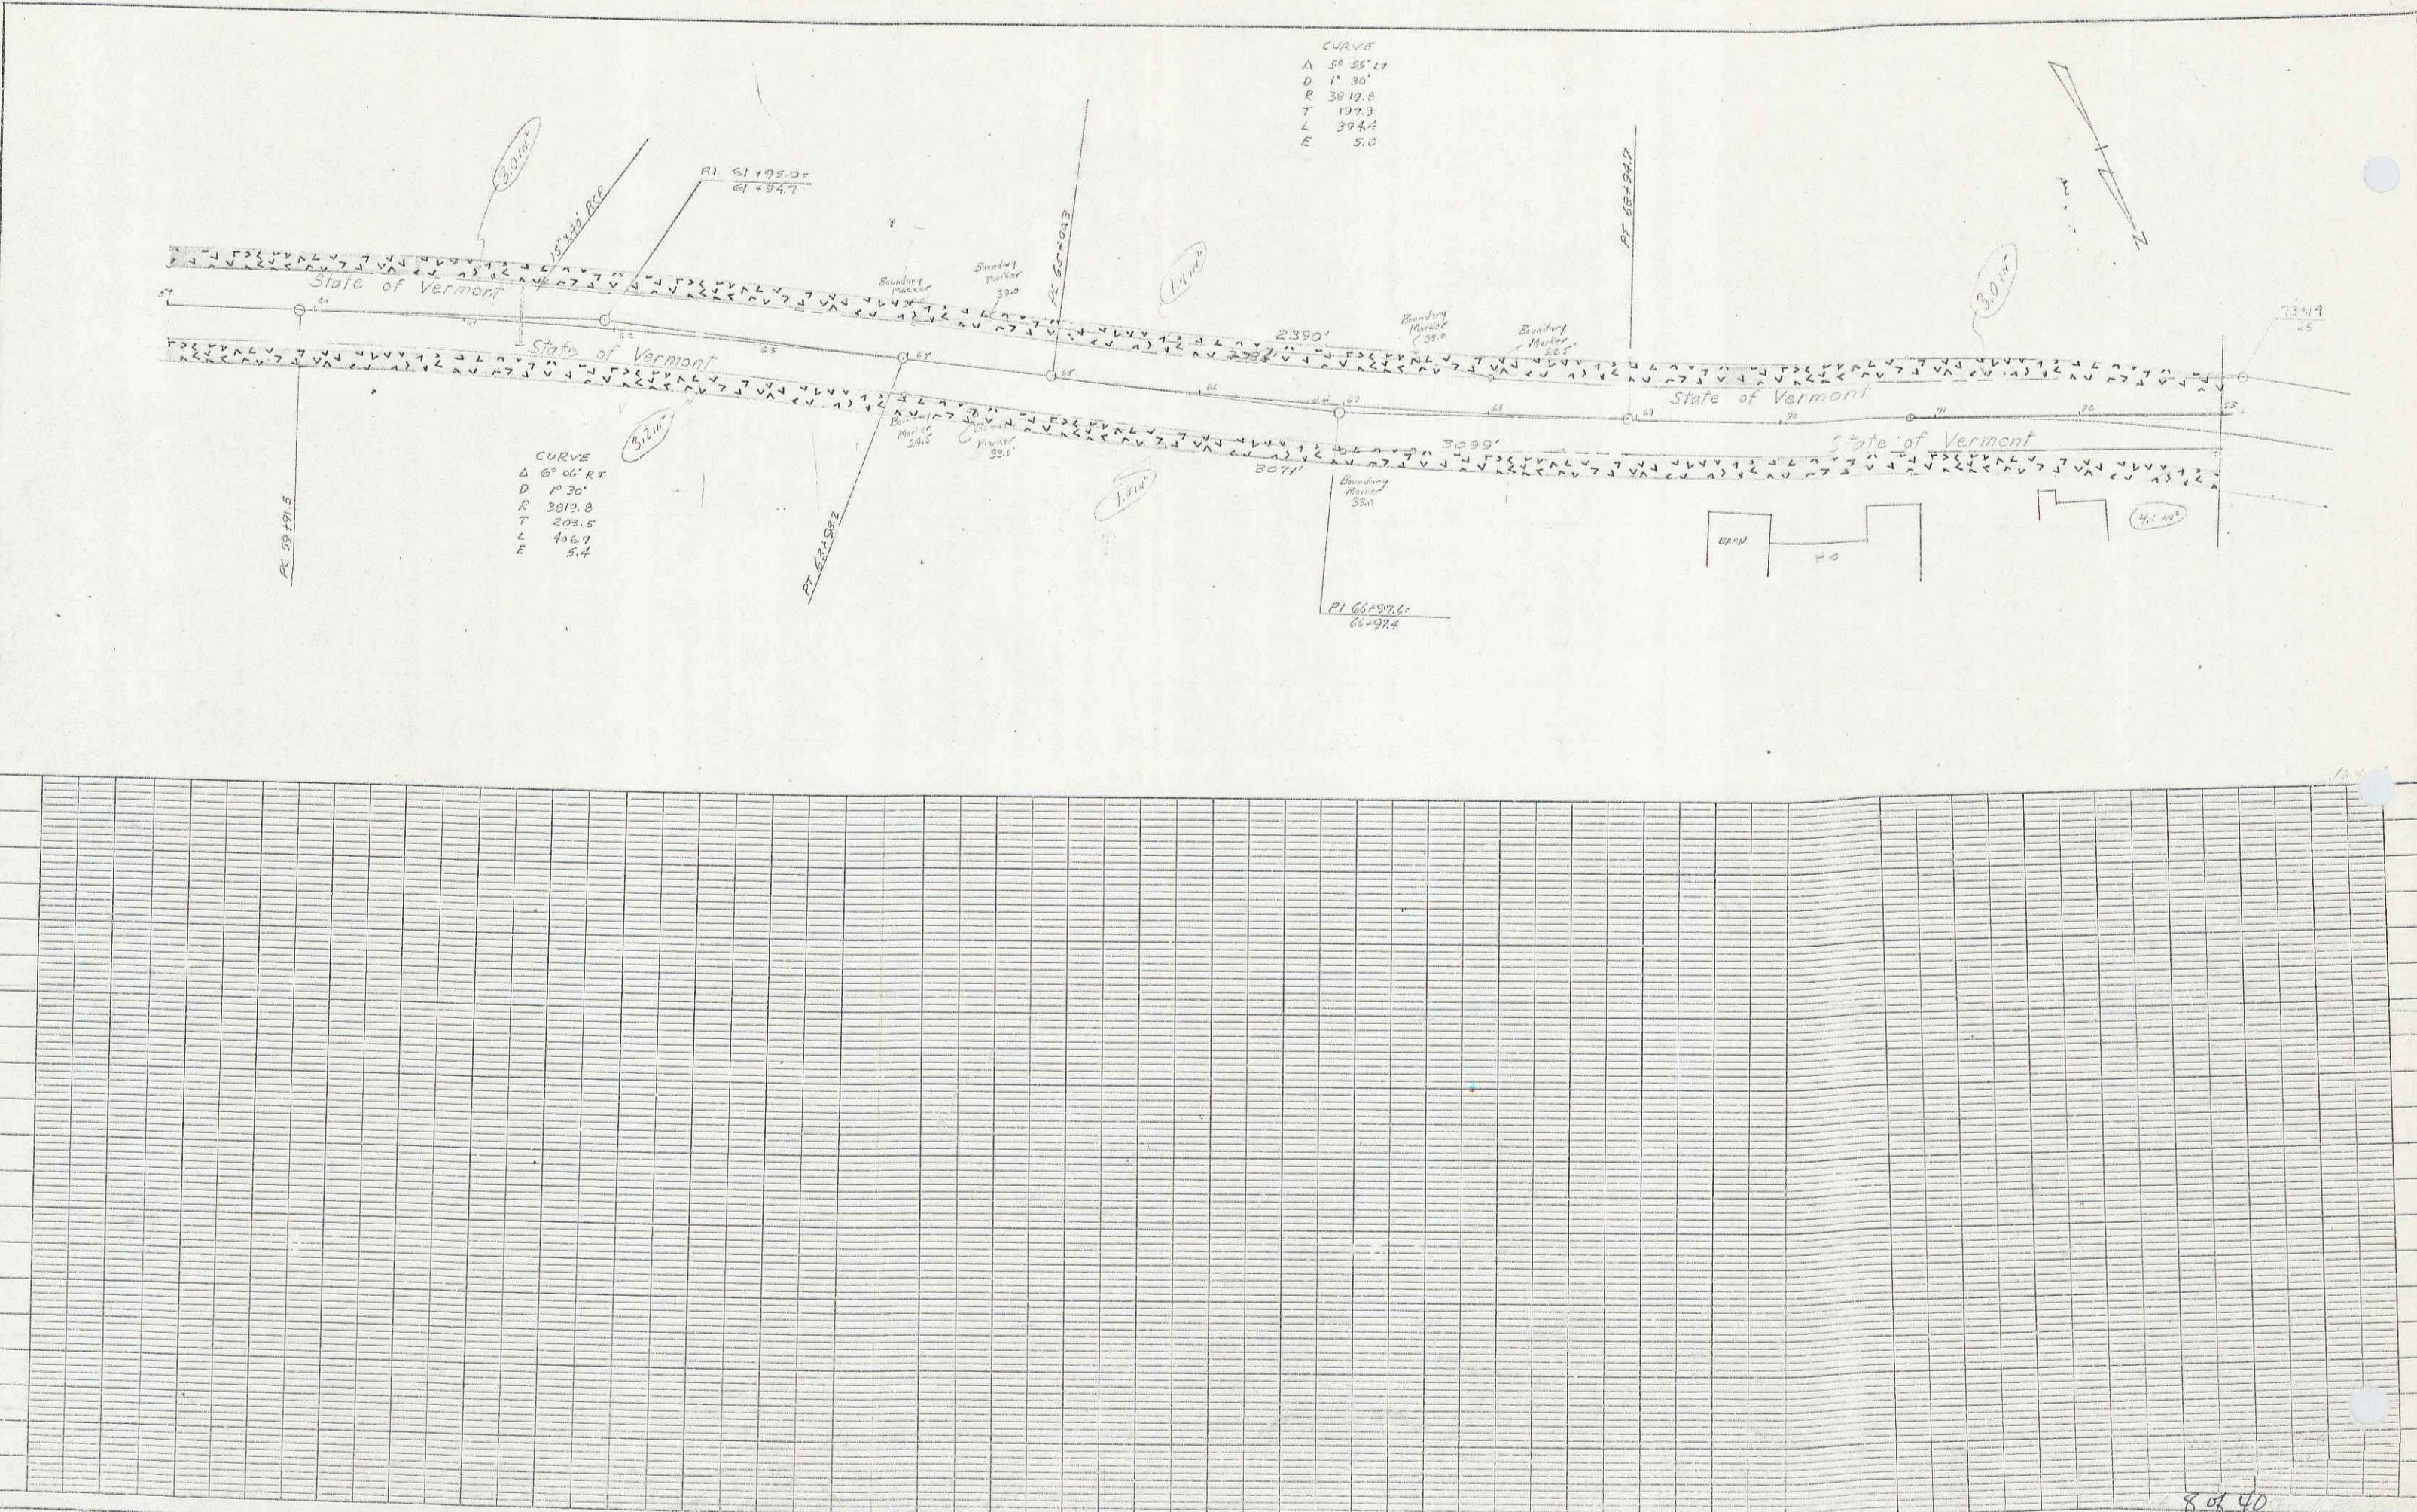

CURVE
 T 197.3
 L 394.4
 E 5.0

CURVE
 R 3819.8
 T 208.5
 L 406.7
 E 5.4

8 of 40

12