


Parcel	Kind of Instrument	Date of Instrument	Grantor	Grantee	Recorded	Remarks
A, B, C	O.C.D.	3-10-33	C.C. Farrington	State	33	621-A 3-17-33

 81.M | 1933

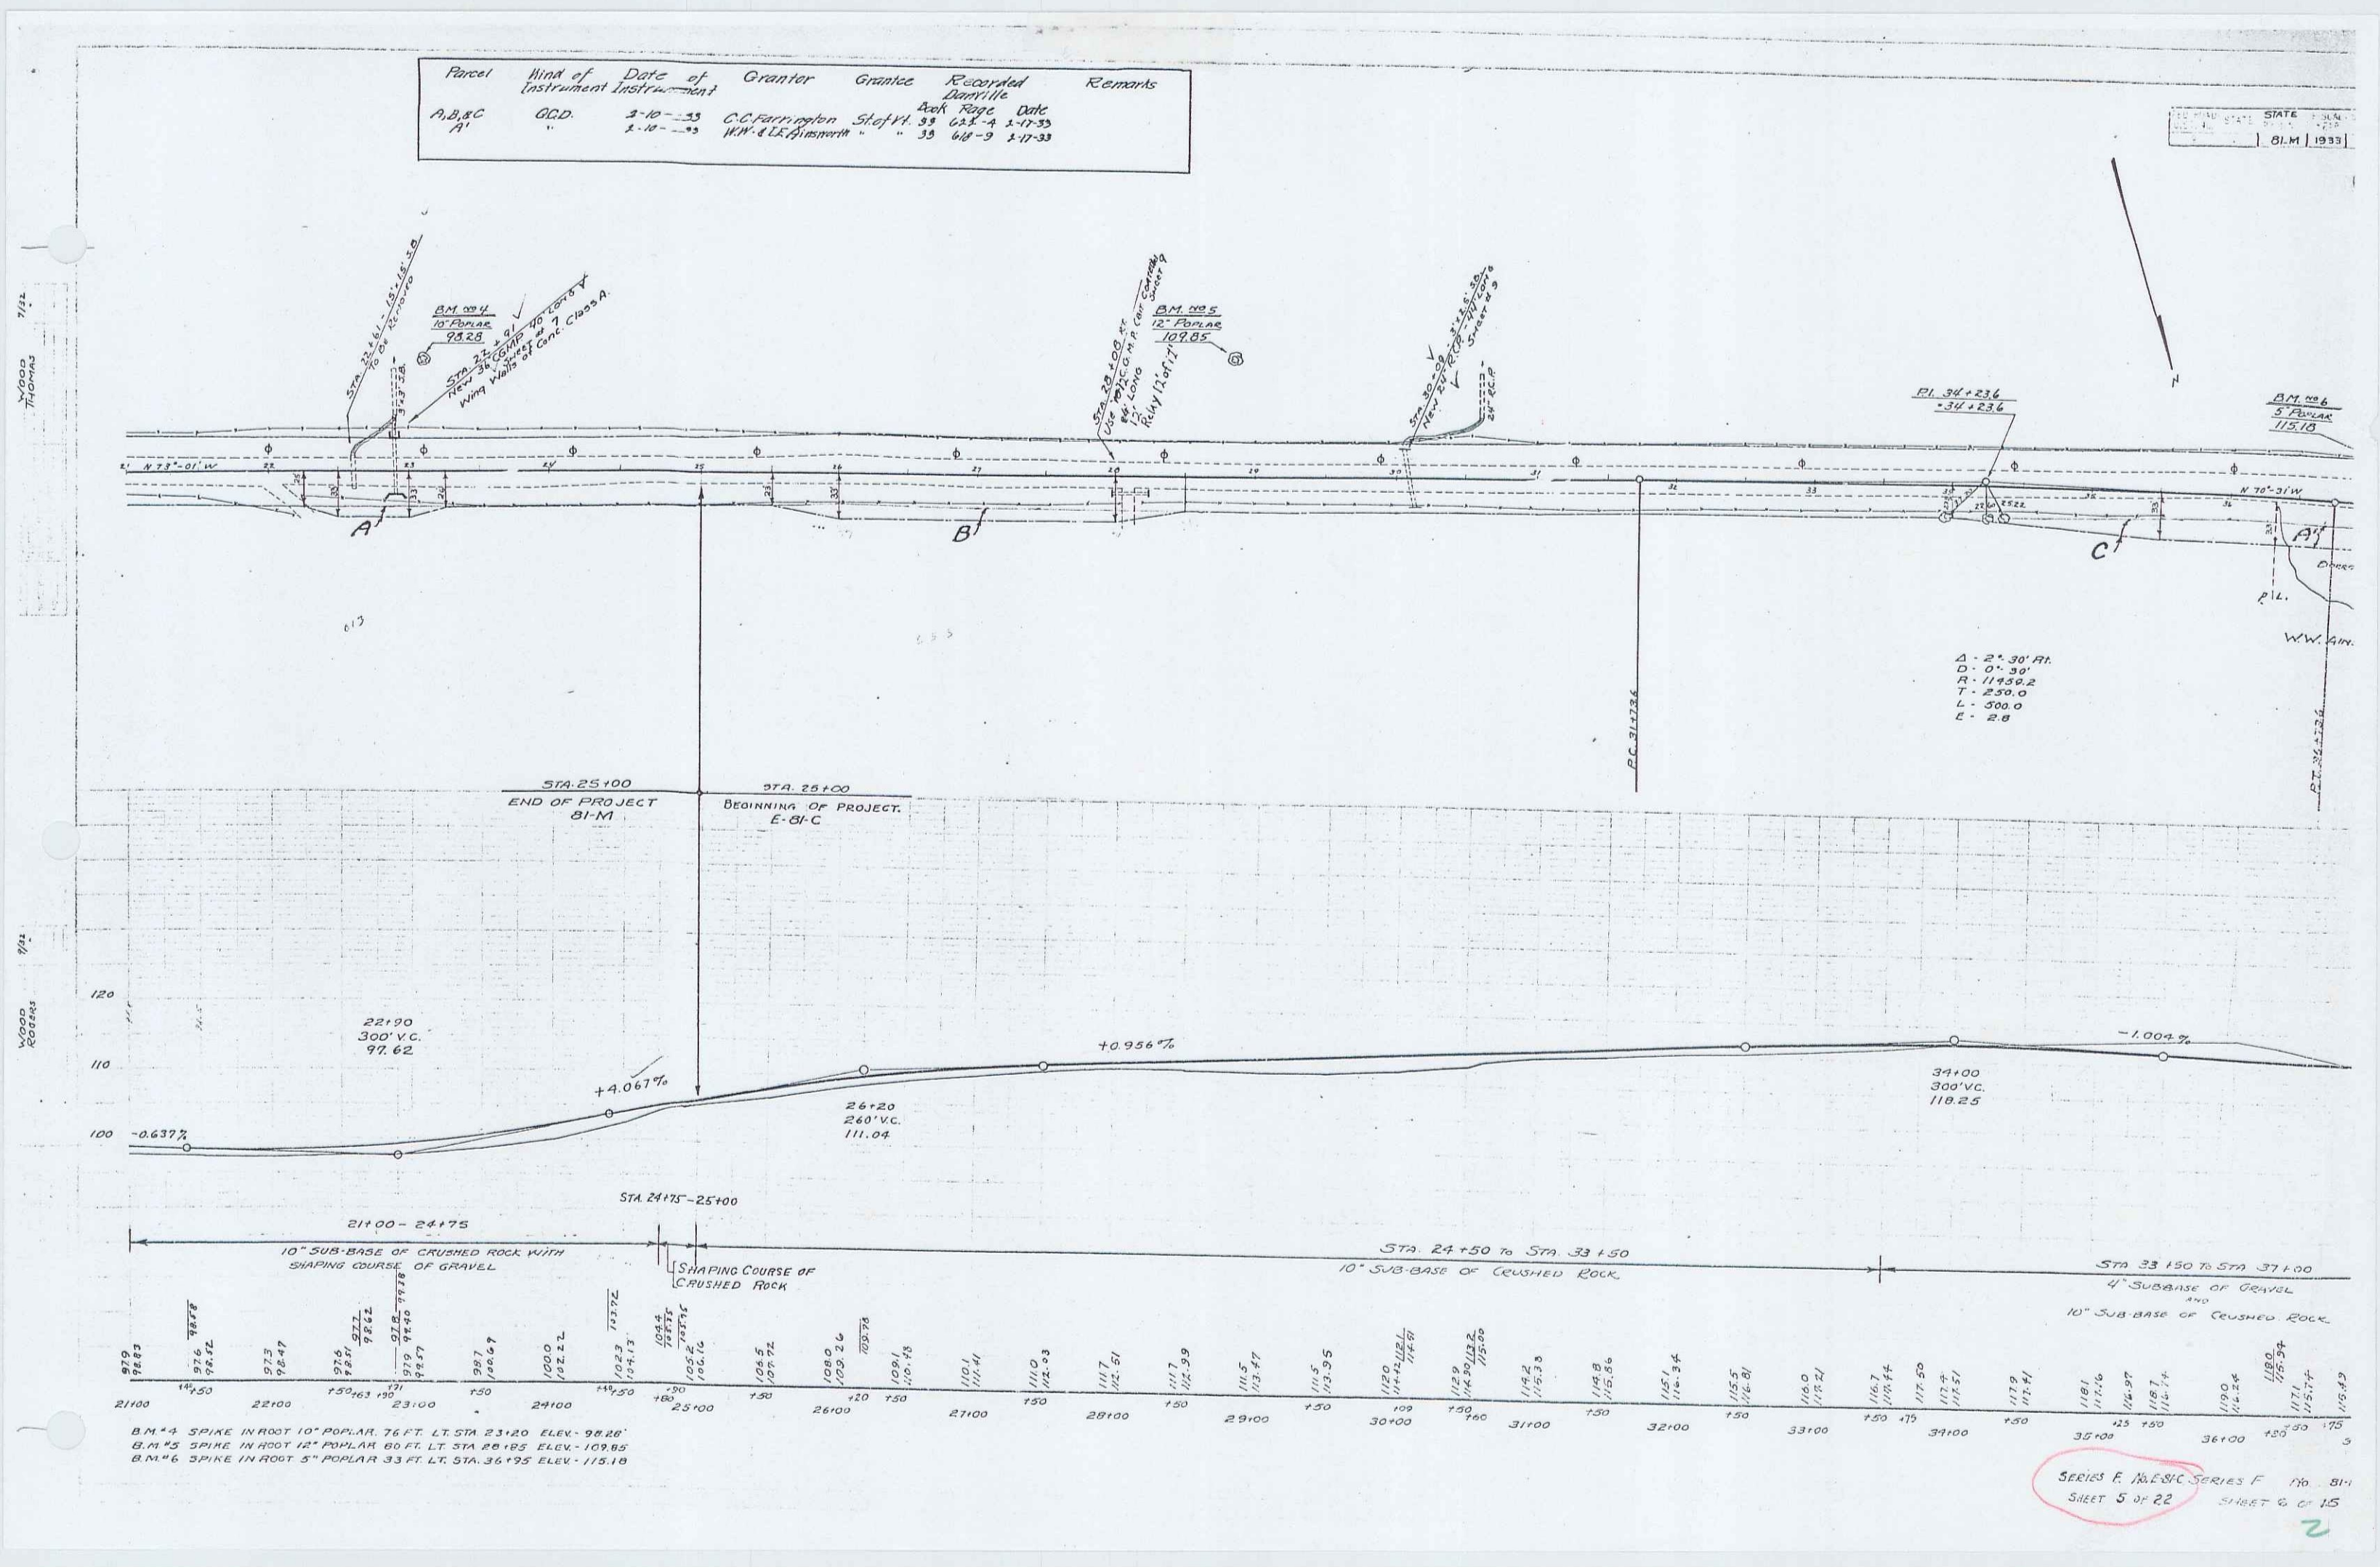

SERIES F. M.E.S.I.C. SERIES F. No. 811  
 SHEET 5 OF 22 SHEET 6 OF 15