Parcel	Kind of Instrument	Date of Instrument	Grantor	Grantee	Recorded Deed Book	Recorded Deed Page	Recorded Deed Date	Remarks
B, C&D.	QCD.	2-10-33	D.A. & M.J. Gates	State of Vt.	33	620-624	2-17-33	
A'	"	2-10-33	W.M. & M.J. Smith	" "	33	616-619	2-18-33	

FED. ROAD DIST. NO.	STATE	FEDERAL AID PROJ. NO.	FISCAL YEAR	SHEET NO.	TOTAL SHEETS
9	VT.	E-81-C	1932	7	22

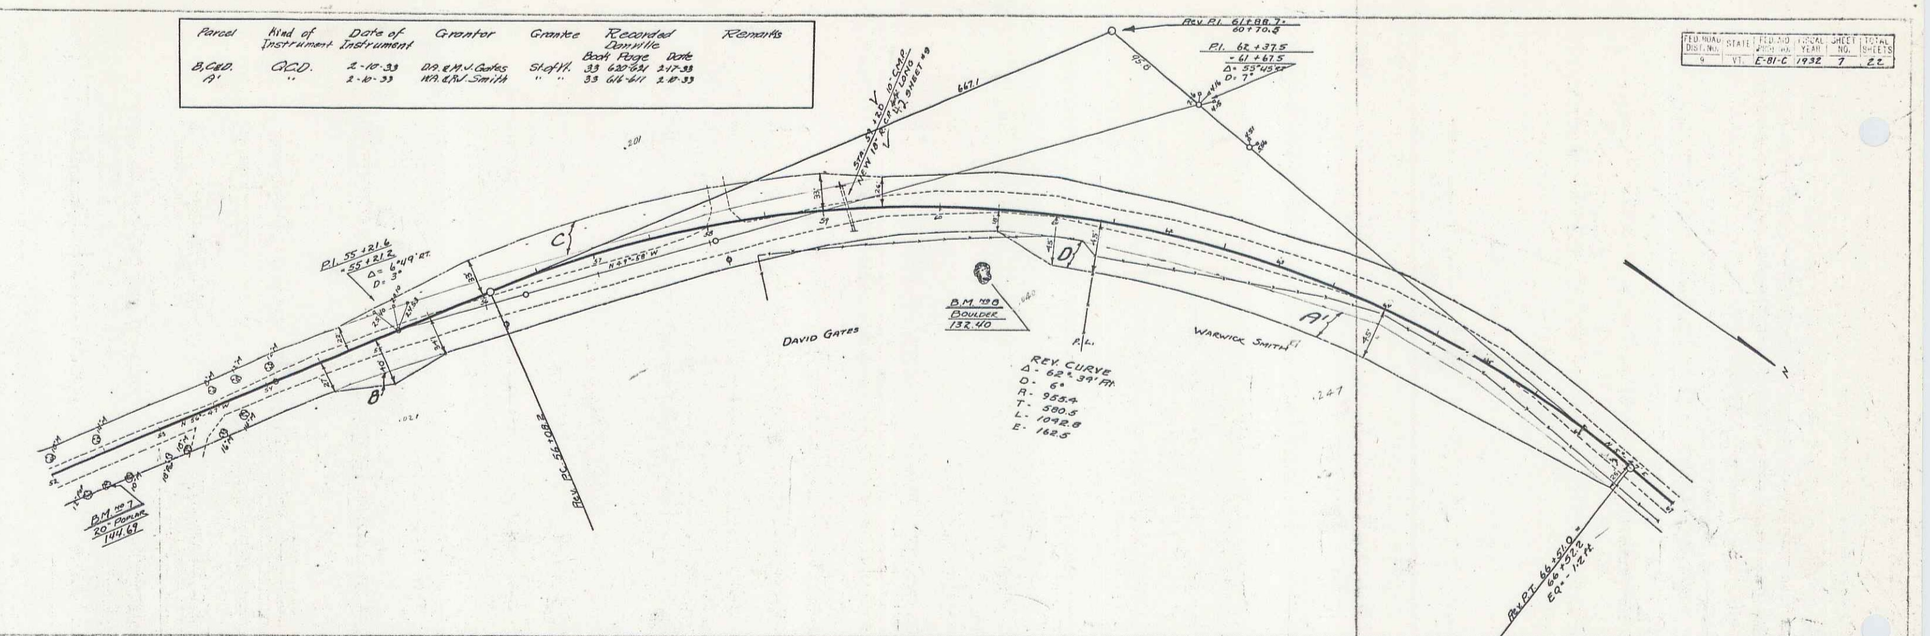

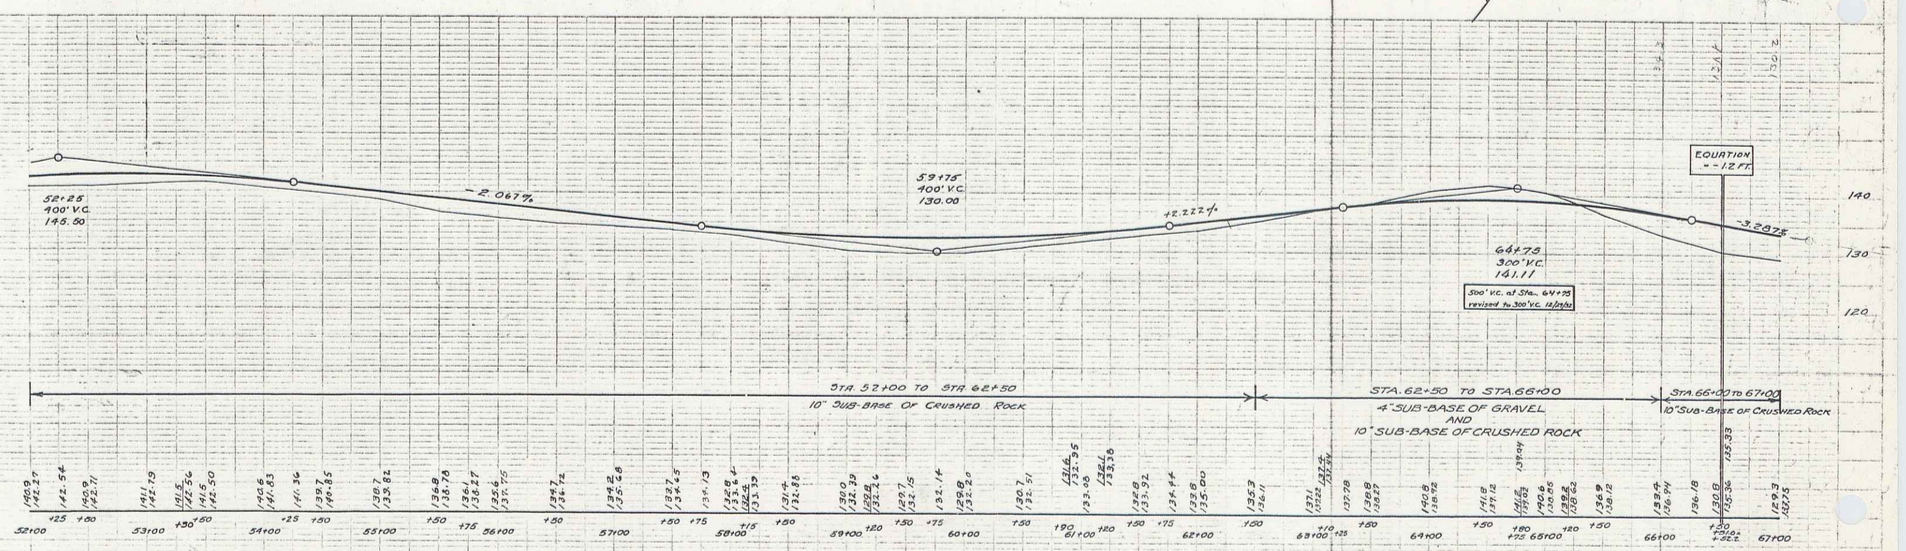

B.M. #7 SPIKE IN ROOT 20" POPLAR 24 FT. RT. OF STA. 52+39 ELEV.- 144.69

B.M. #8 PAINT SPOT ON BOULDER 36 FT. RT. OF STA. 60+38 ELEV.- 132.40

SERIES F No. E-81-C
SHEET 7 OF 22