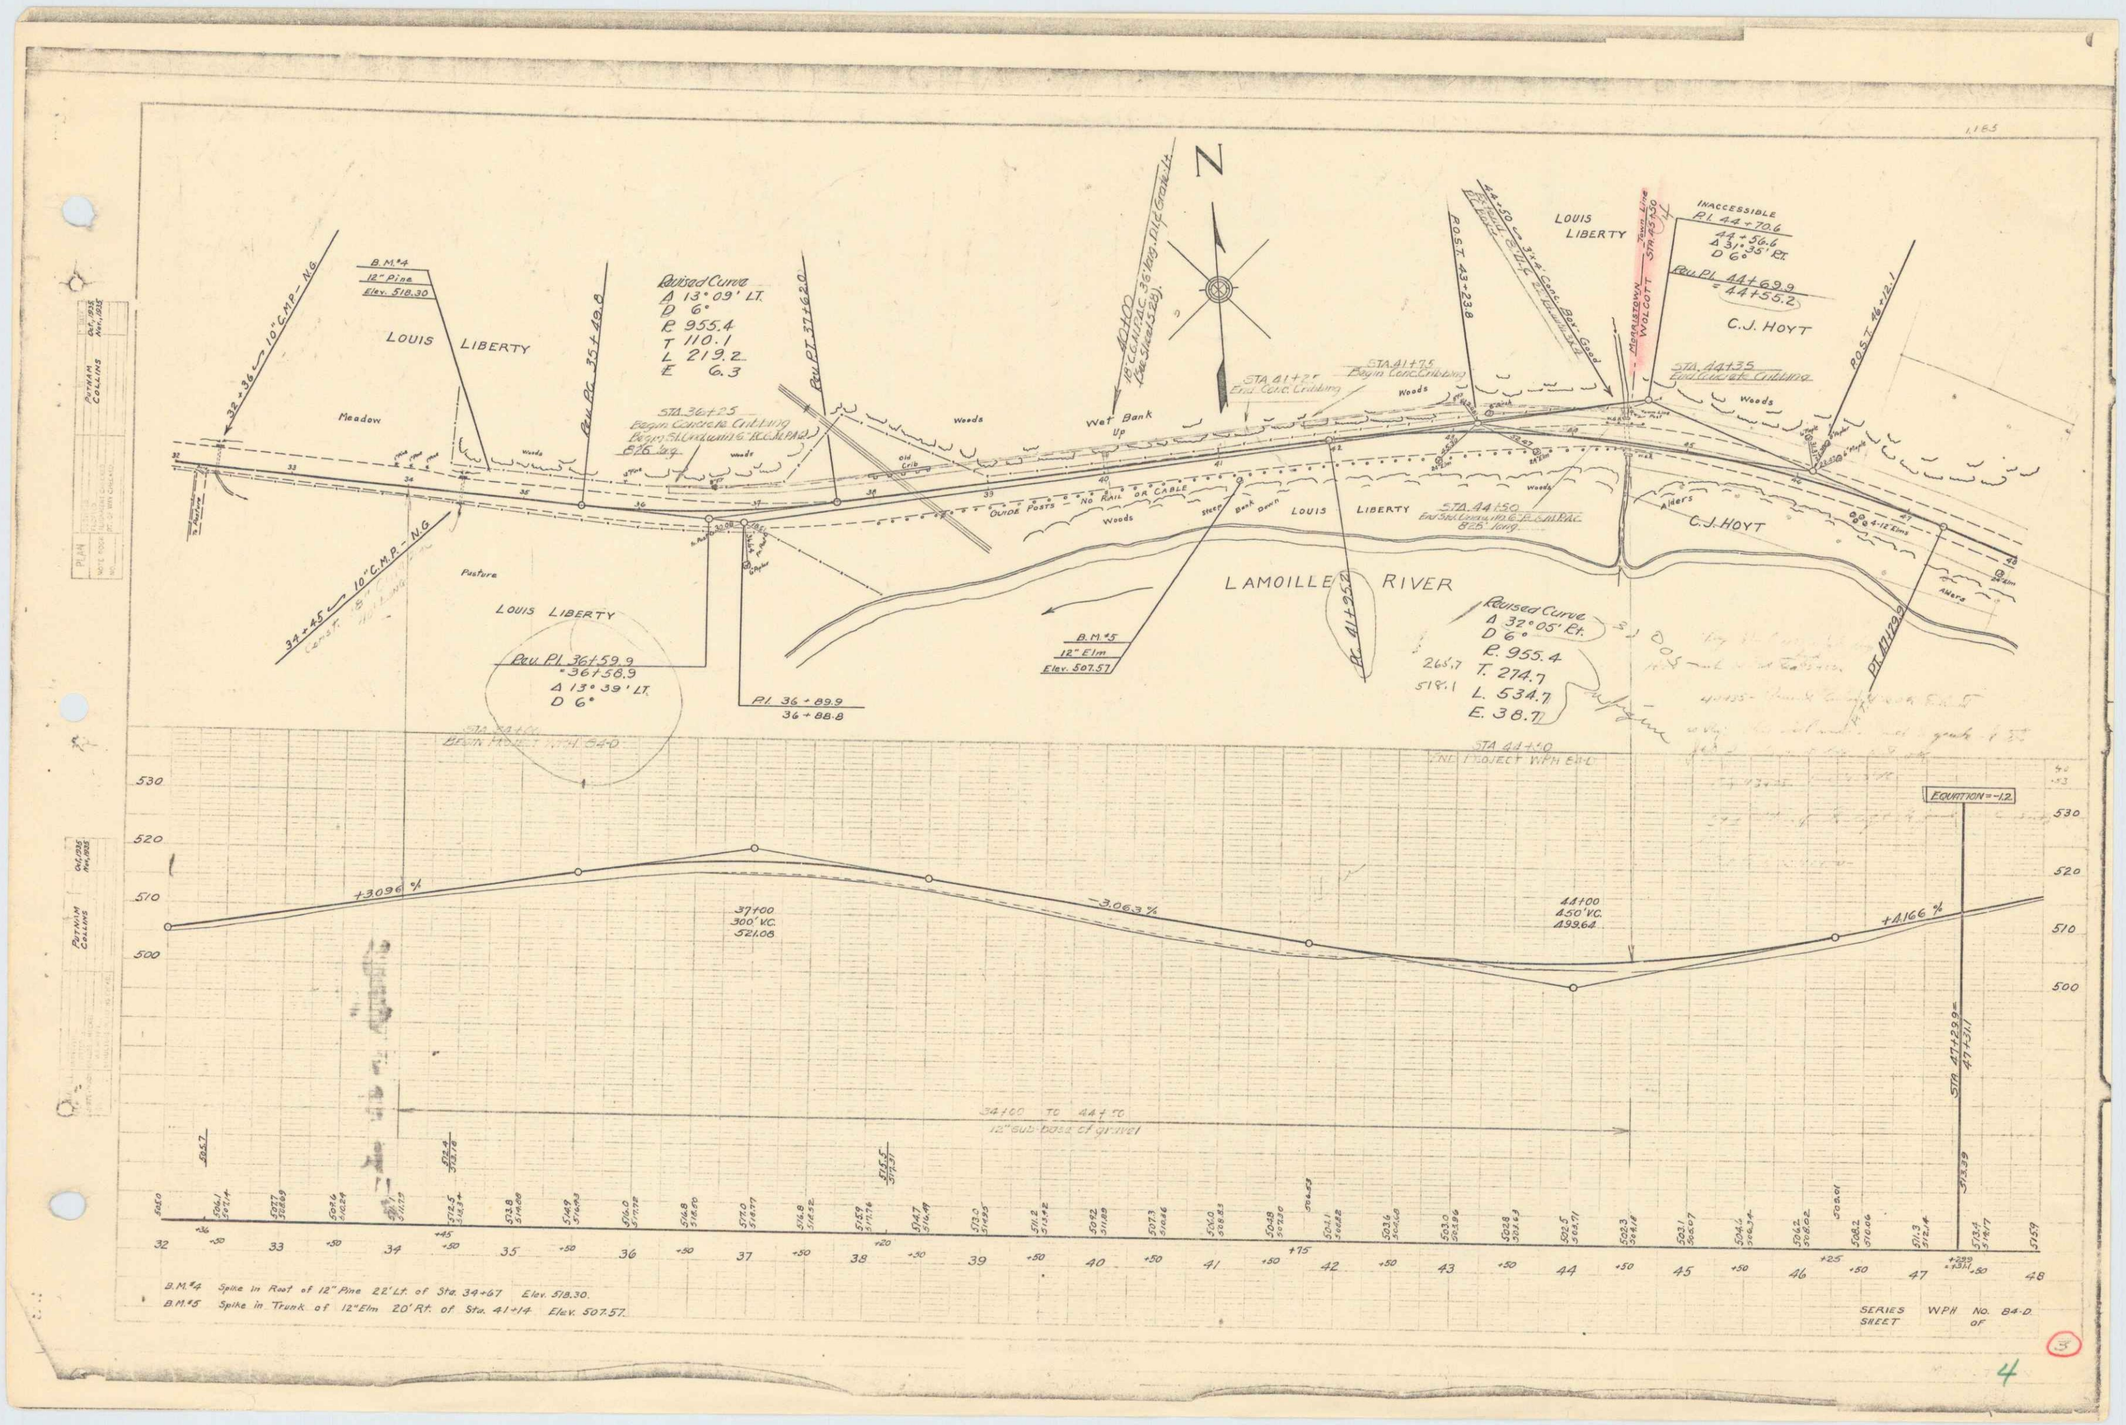
N
LOUIS LIBERTY
B.M.#4
12" Pine
Elev. 518.30
Revised Curve
Δ 13°09' LT.
D 6°
R 955.4
T 110.1
L 219.2
E 6.3
Rev. PI. 35+19.8
Rev. PT. 37+62.0
Meadow
Woods
Wet Bank Up
STA. 36+25 Begin Concrete Cribbing
STA. 41+75 Begin Conc. Cribbing
STA. 41+25 End Conc. Cribbing
POST 43-23.8
POST 46+16.1
C.J. HOYT
INACCESSIBLE
PI. 44+70.6
44+56.6
Δ 31°35' Rt.
D 6°
Rev. PI. 44+69.9
= 44+56.2
STA. 44+35 End Concrete Cribbing
GUIDE POSTS — NO RAIL OR CABLE
Steep Bank Down
STA. 44+50 End Stone Lining
Alders
LAMOILLE RIVER
Pasture
Rev. PI. 36+59.9
=36+58.9
Δ 13°39' LT.
D 6°
PI. 36+89.9
36+88.8
B.M.#5
12" Elm
Elev. 507.57
Rev. PI. 41+95.7
Revised Curve
Δ 32°05' Rt.
D 6°
R. 955.4
T. 274.7
L. 534.7
E. 38.7
265.7
518.1
STA 44+10 PROJECT W.P.H. END
EQUATION = -12
+3.096 %
-3.063 %
+4.166 %
37+00
300' V.C.
521.06
44+00
450' V.C.
499.64
34+00 TO 44+50
12" Sub-base of gravel
STA 47+22.9 = 47+31.1
B.M.#4 Spike in Root of 12" Pine 22' Lt. of Sta. 34+67 Elev. 518.30.
B.M.#5 Spike in Trunk of 12" Elm 20' Rt. of Sta. 41+14 Elev. 507.57.
SERIES W.P.H. No. 84-D.
SHEET of
4