FED. ROAD DIST. NO.	STATE	WPH PROJ. NO.	FISCAL YEAR	SHEET NO.	TOTAL SHEETS
5	VT.	84D	1936	4	14

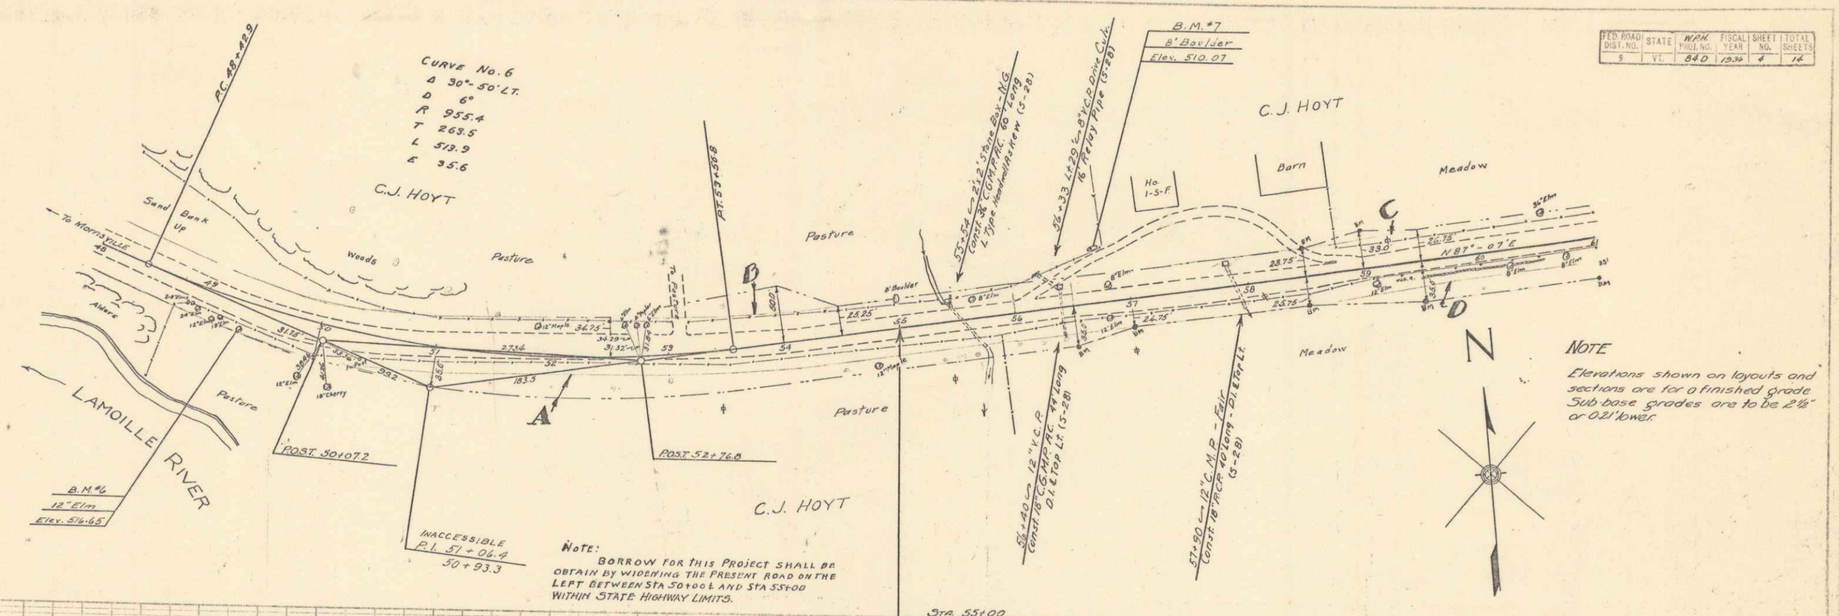

B.M. #6 Spike in Roof of 12" Elm 24' Rt. of Sta. 49+33 Elev. 516.65.
B.M. #7 Point Spot on 8' Boulder 47' Lt. of Sta. 56+73 Elev. 510.07

SERIES W.P.H. No. 84-D
SHEET 4 of 14

5