FED. ROAD DIST. NO.	STATE	PROJ. NO.	FISCAL YEAR	SHEET NO.	TOTAL SHEETS
1	VT.	WPH 84D	1936	5	14

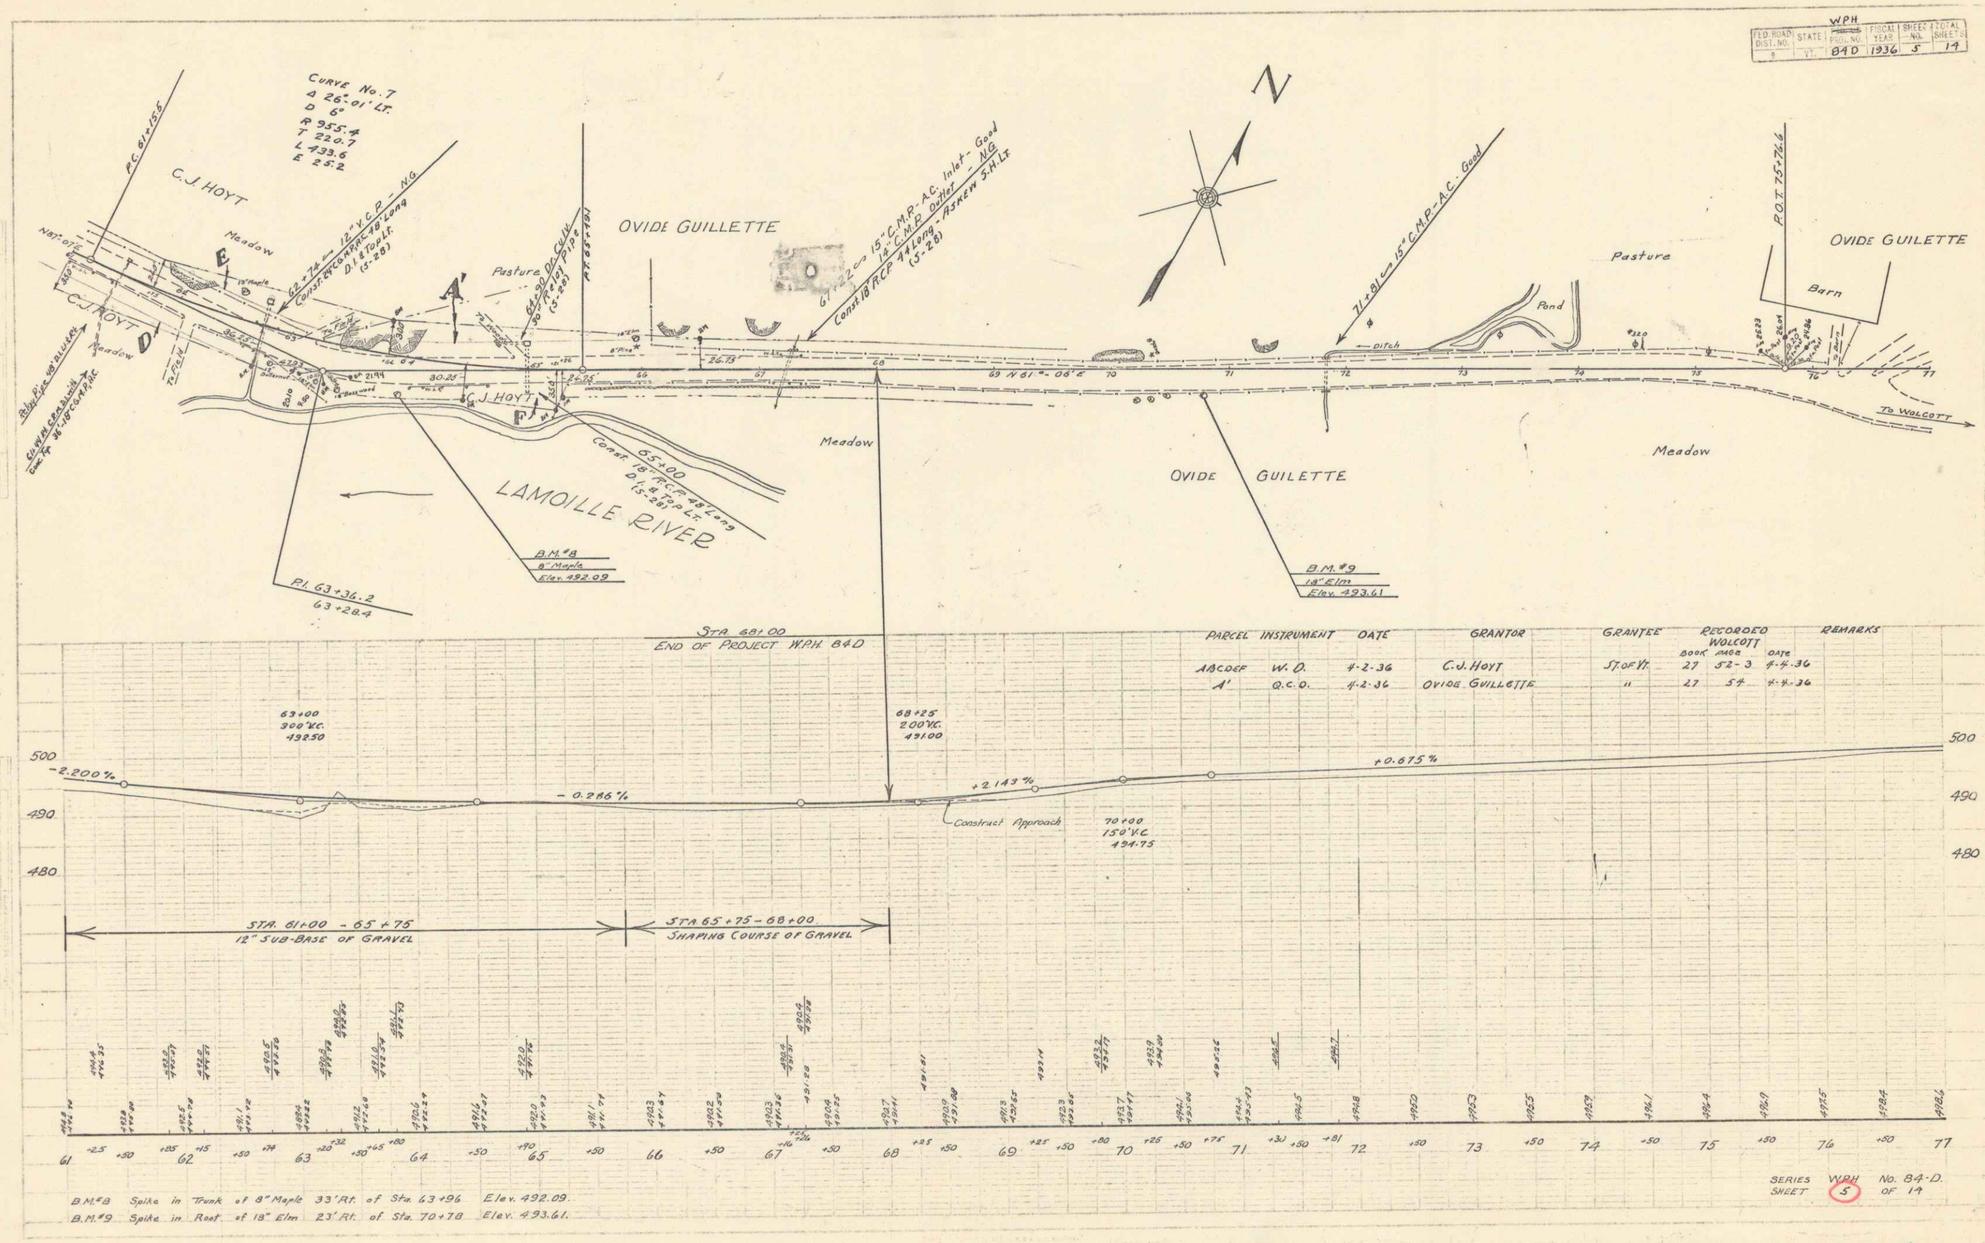

STA. 68+00
END OF PROJECT W.P.H. 84D

PARCEL	INSTRUMENT	DATE	GRANTOR	GRANTEE	RECORDED WOLCOTT BOOK	PAGE	DATE	REMARKS
ABCDEF	W.D.	4-2-36	C.J. HOYT	ST. OF VT.	27	52-3	4-4-36	
A'	Q.C.D.	4-2-36	OVIDE GUILLETTE	"	27	54	4-4-36	

B.M. #8 Spike in Trunk of 8" Maple 33' Rt. of Sta. 63+96 Elev. 492.09
B.M. #9 Spike in Root of 18" Elm 23' Rt. of Sta. 70+78 Elev. 493.61.

SERIES W.P.H. No. 84-D.
SHEET 5 OF 14

6