FED. ROAD DIST. NO.	STATE	FED. AID PROJ. NO.	FISCAL YEAR	SHEET NO.	TOTAL SHEETS
9	VT.	84-D(2)	1941	4	13

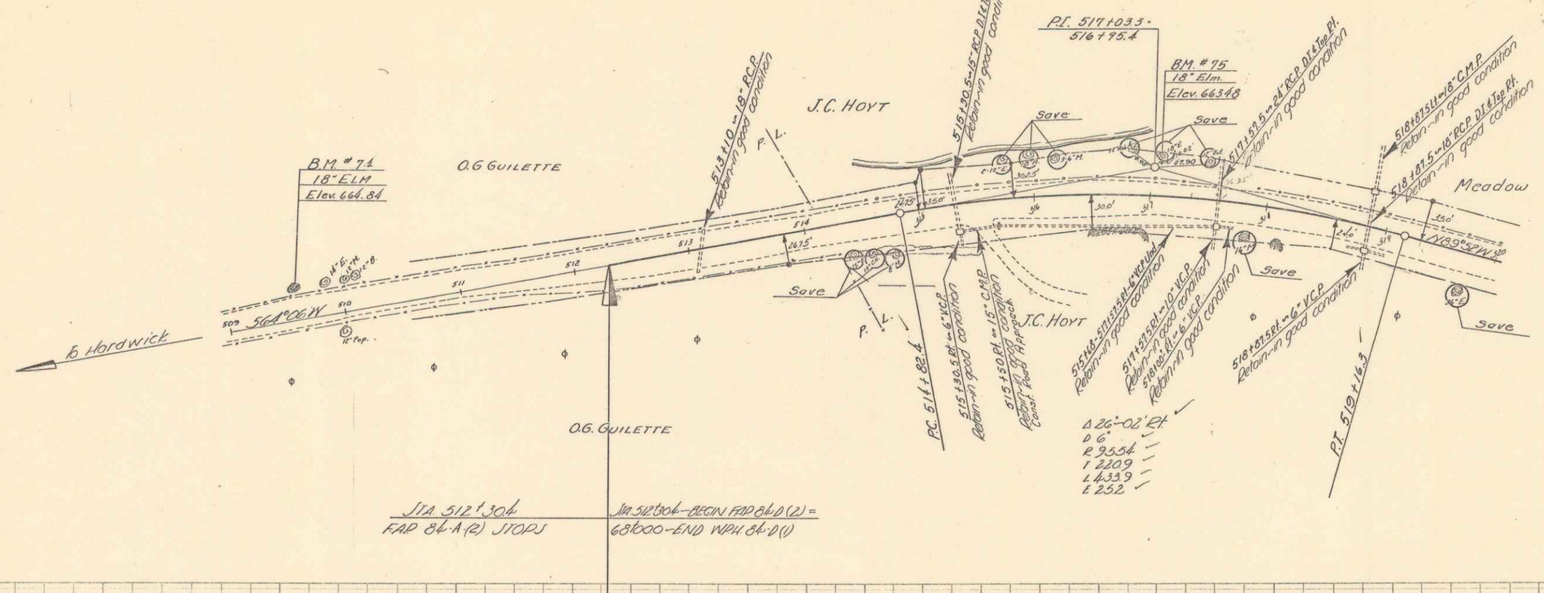

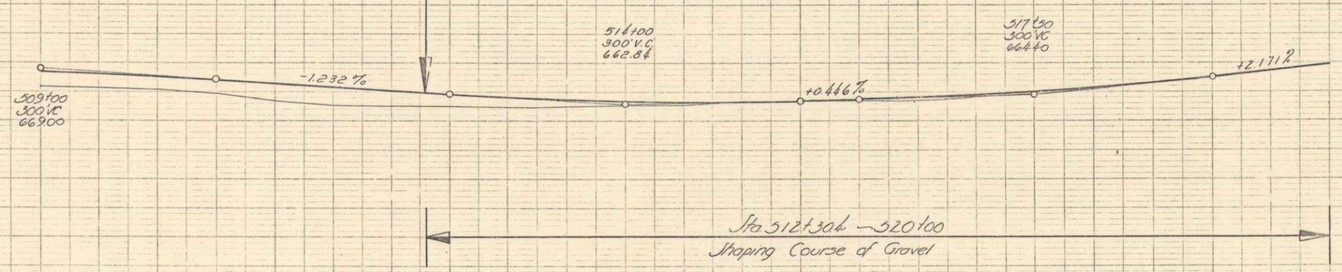

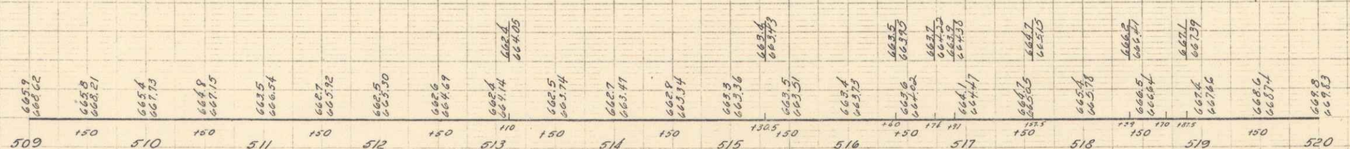

B.M. # 74 S.I.R. 18" Elm 23 ft. Rt. Sta. 509+58. Elev. 664.84
B.M. # 75 S.I.R. 18" Elm 34 ft. Lt Sta. 517+03 Elev. 663.48

WOLCOTT
SERIES FAP 84-D(2)
SHEET 4 OF 13 SHEETS

PLATE 1 - PLAN - PROFILE

2