


PARCEL INSTRUMENT	DATE	GRANTOR	GRANTEE	RECORDED
A-D	WDOE	4-7-41	W.C. & F.N. REED	WOLCOTT
B	COND	11-21-40	ST. J. & L.C. R.R.	BOOK 341-253
			ST. OF Vt.	PAGE 27
				DATE 11-22-40

BARRE, Vt. 14 169

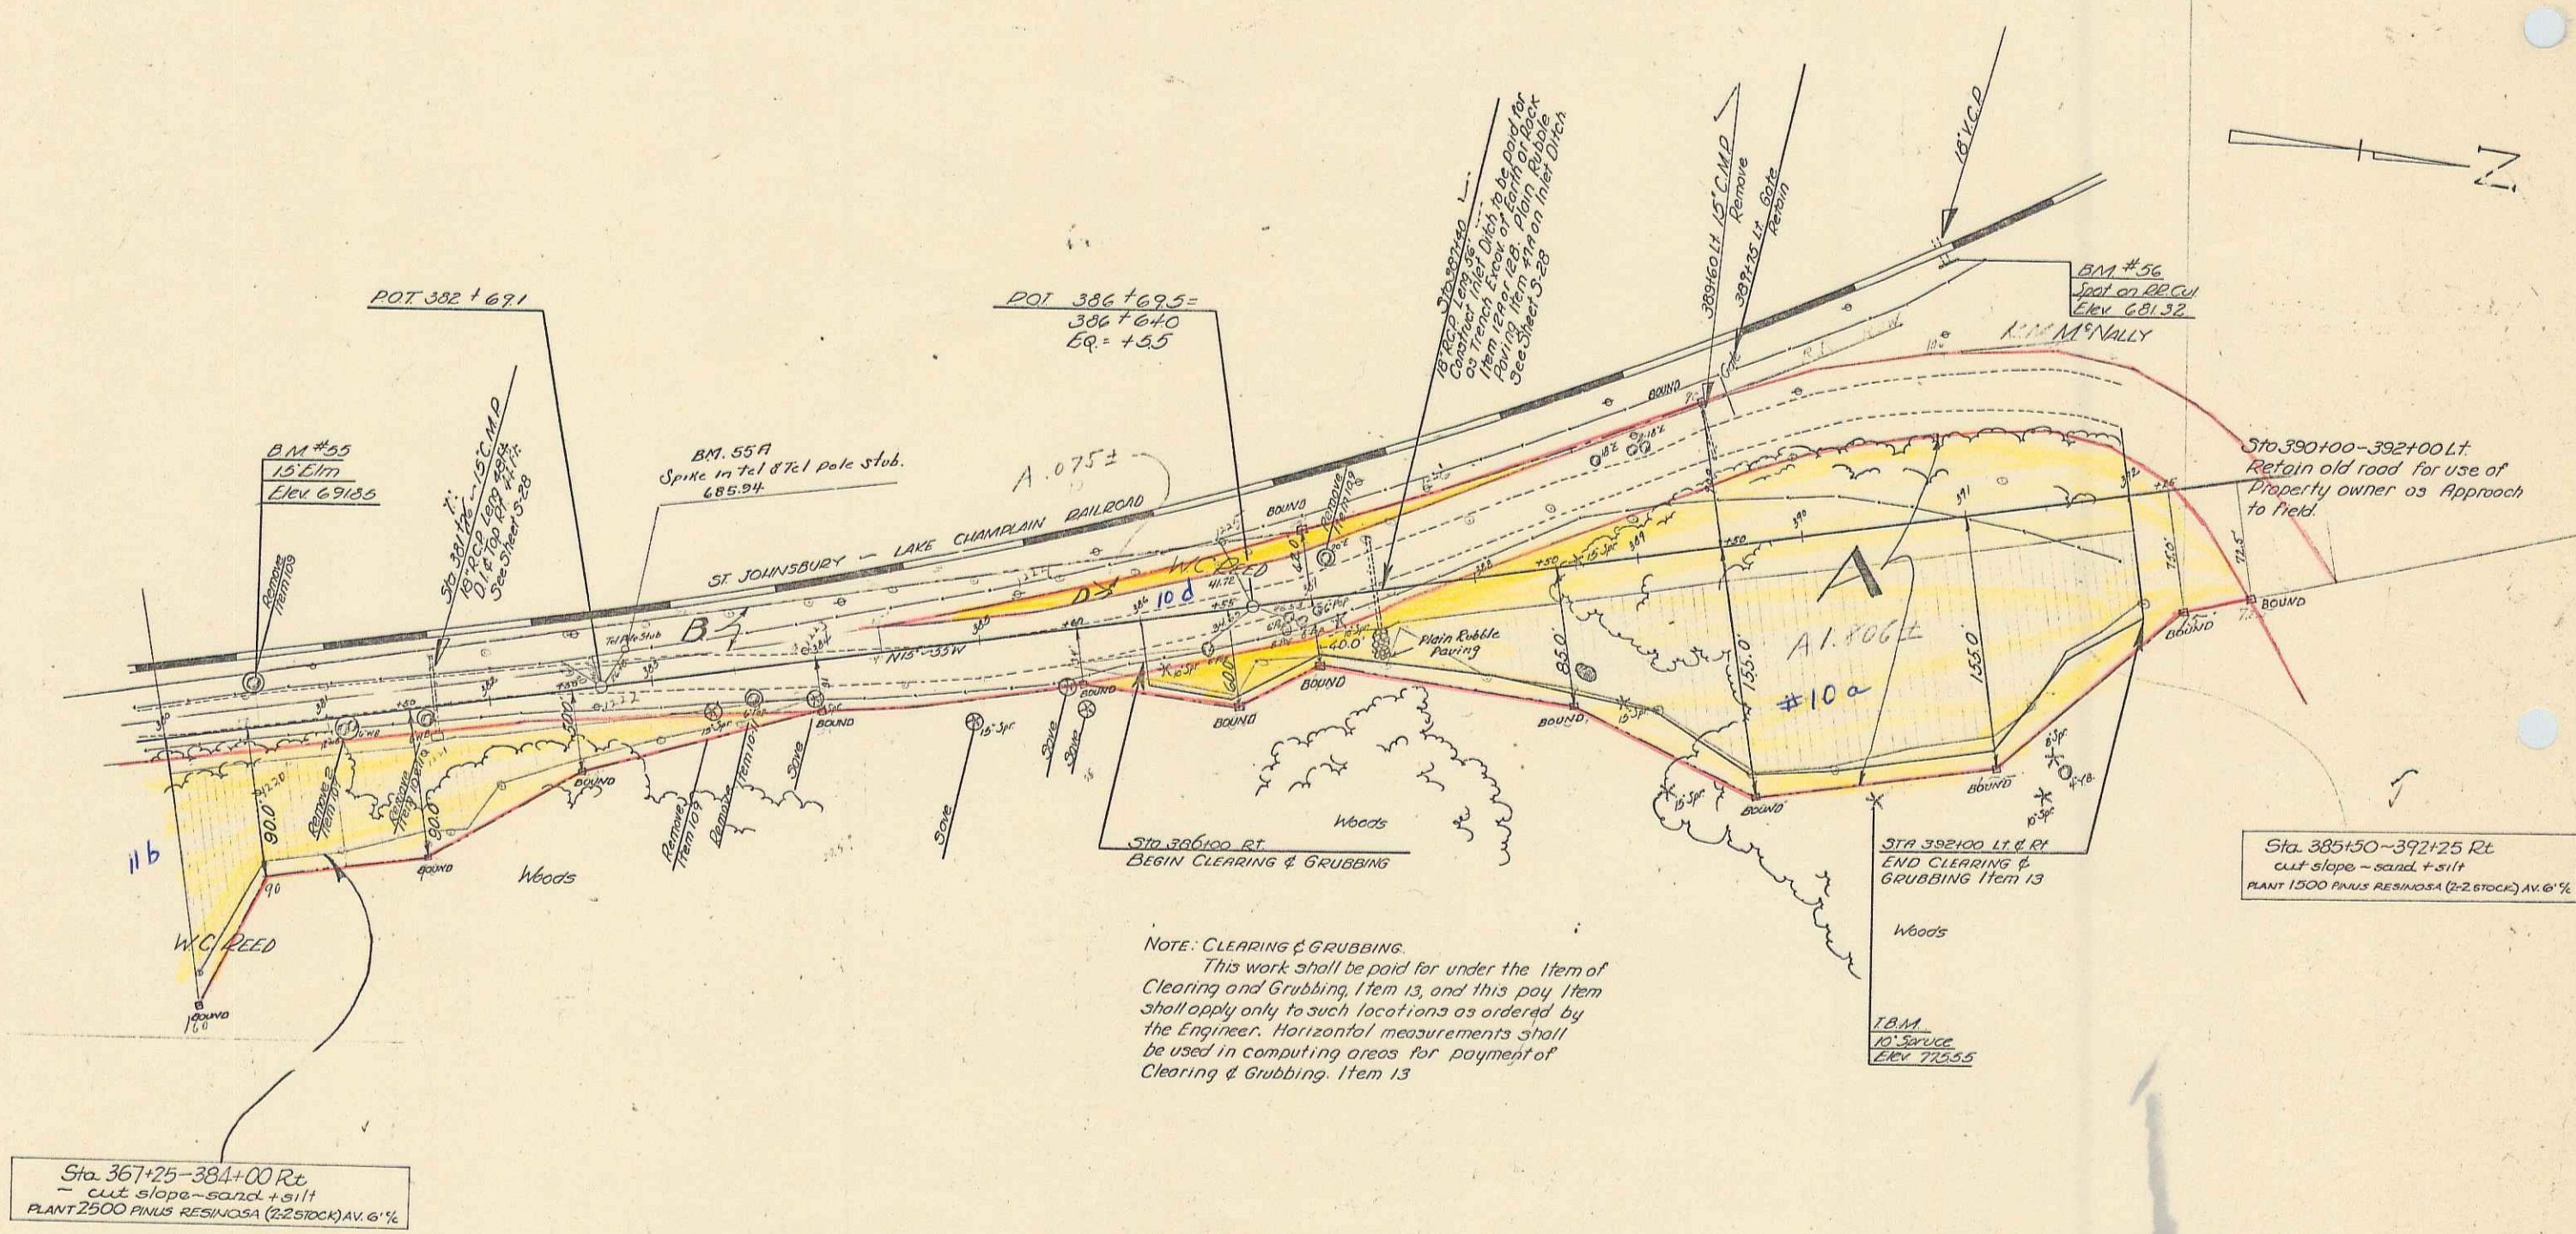

ESTIMATED QUANTITIES

--	--

Surveyed by Lane - Buley  
 Designed by AJ Runnals  
 Drawn by J. Poyor  
 Traced by LOVIN  
 Checked by  
 Series KAP No. 84(2) Filed  
 Sheet 14 of 169 Sheets