PARCEL	INSTRUMENT	DATE	GRANTOR	GRANTEE	RECORDED	REMARKS
C	C.D.O.E.	4-23-41	C.H.A. STAFFORD & SONS INC.	ST. OF VT.	WOLCOTT BOOK 29 PAGE 334-5-6	DATE 4-28-41

F.A. ROAD	STATE	FEDERAL AID PROJECT NO.	SHEET NO.	TOTAL
		BHRD 1941	18	169

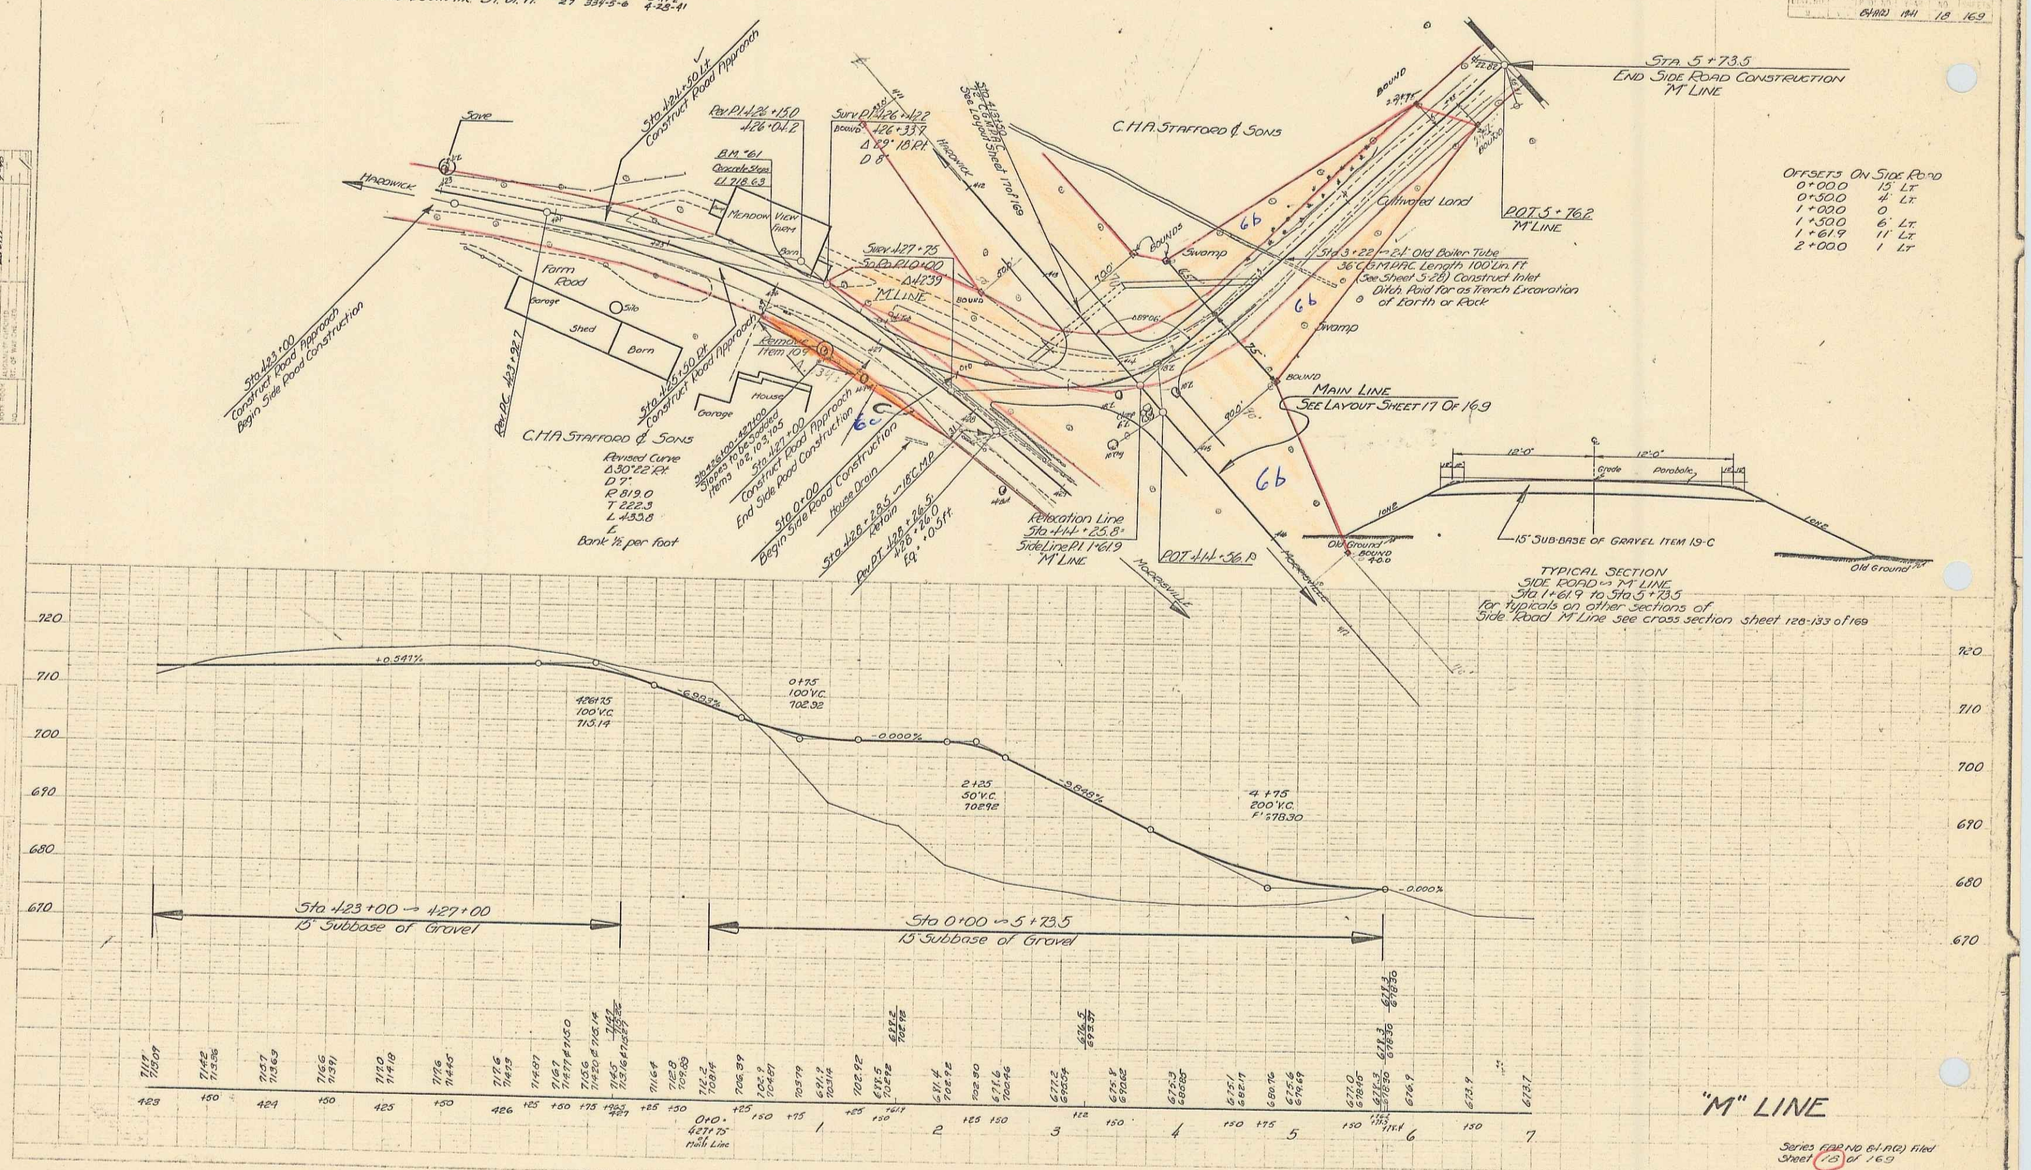

Series F.A.R. No. 61-A(2) filed
Sheet 18 of 169

14