PARCEL	INSTRUMENT	DATE	GRANTOR	GRANTEE	RECORDED	REMARKS
D.C.B	W.O.D.E.	2-27-41	C.M. & LINA ELDRIDGE	W. OLCOTT ST. OF VT.	BOOK 26 PAGE 64-70 DATE 3-12-41	

FED. ROAD DIST. NO.	STATE	FED. AID PROJ. NO.	FISCAL YEAR	SHEET NO.	TOTAL SHEETS
9	VT.	BR-R(13)	1941	20	169

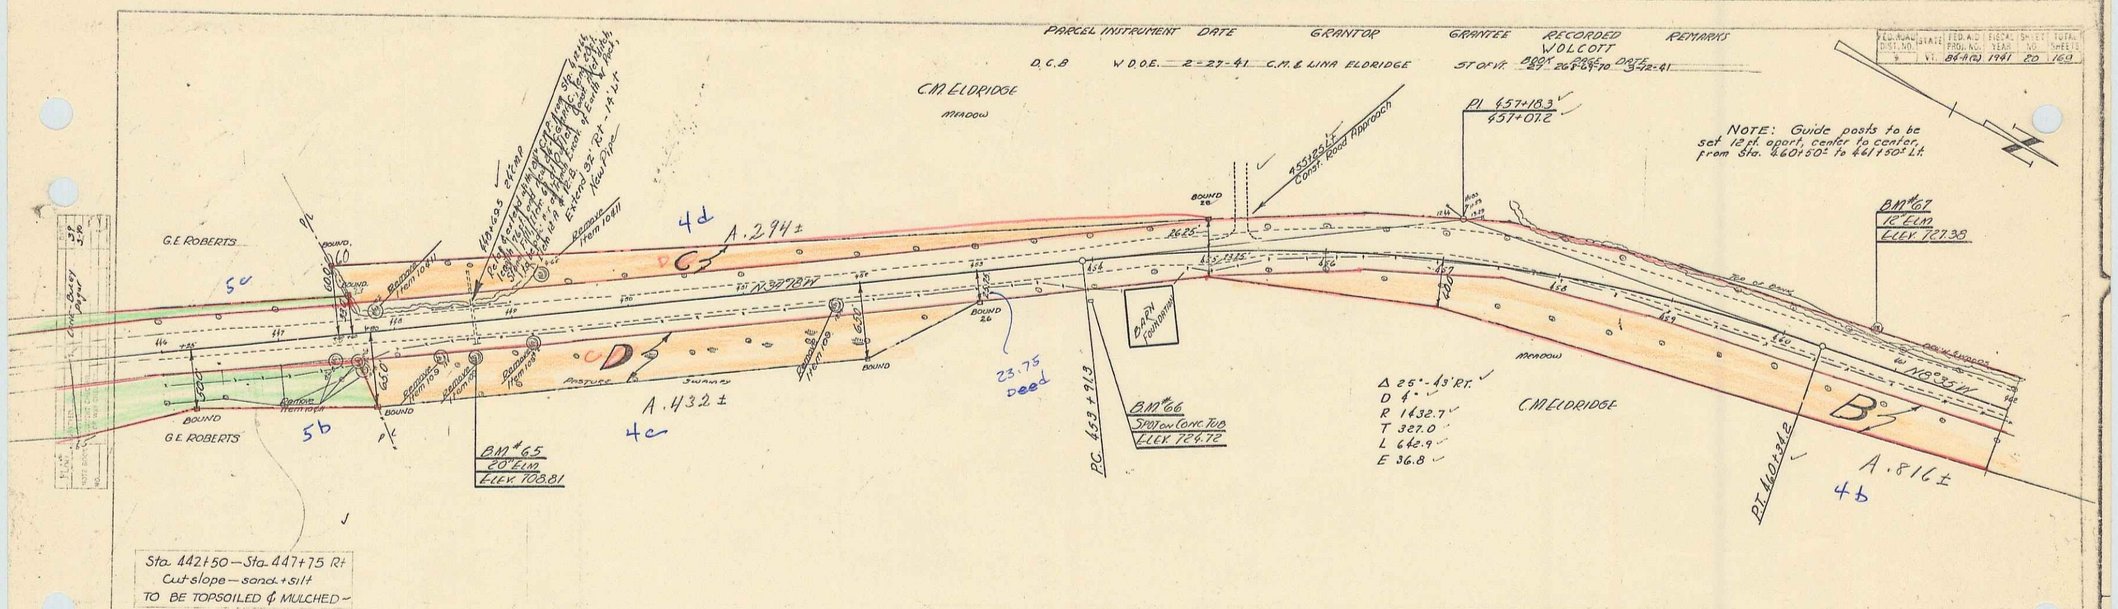

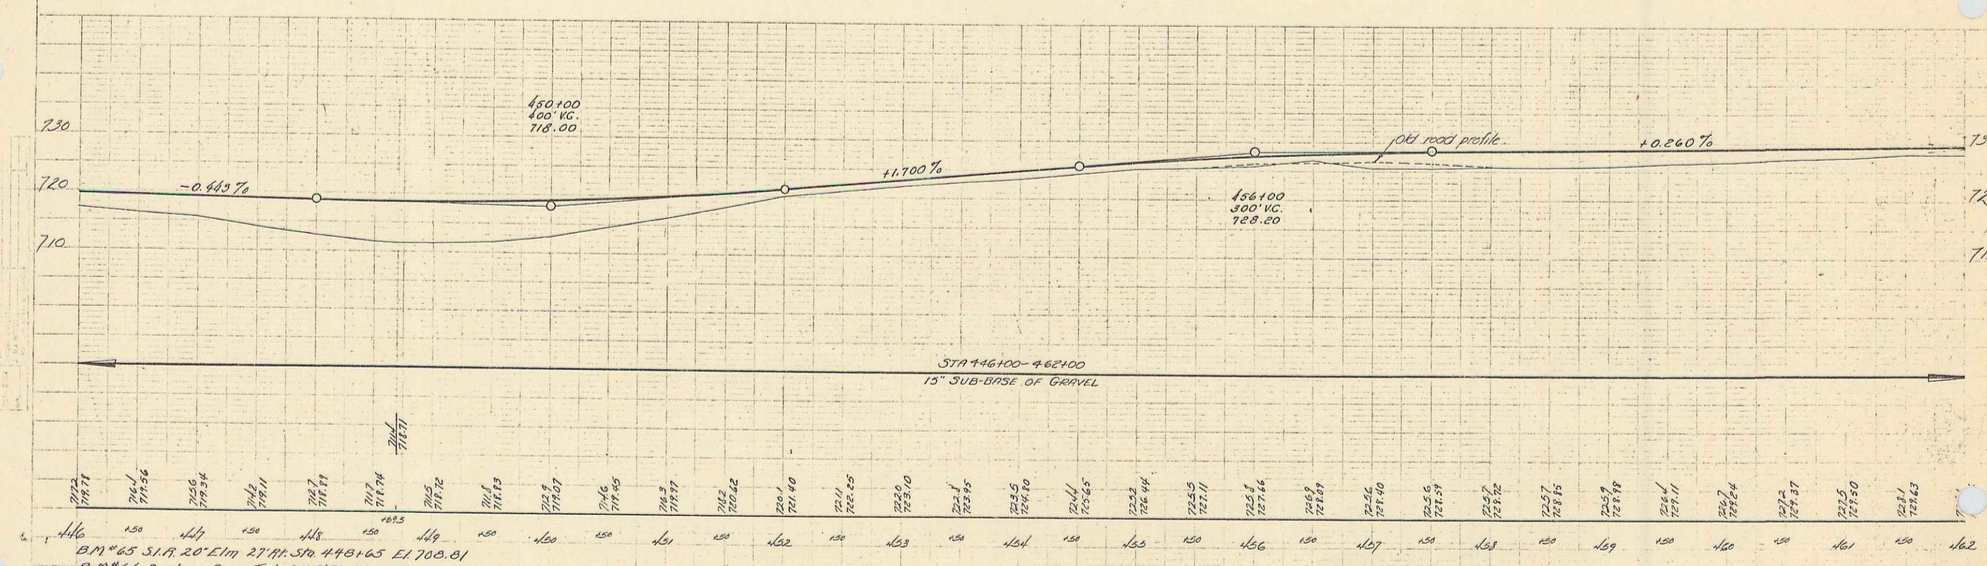

B.M. #65 S.I.R. 20" Elm 27' Rt. Sta. 448+65 El. 708.81
B.M. #66 Spot on Conc. Tub 24.5' Rt. Sta. 453+96 El. 724.72
B.M. #67 S.I.R. 12" Elm 25' Lt. Sta. 460+74 El. 727.38

SERIES FAR No. 84-R(13) FILED
SHEET 20 OF 169

16