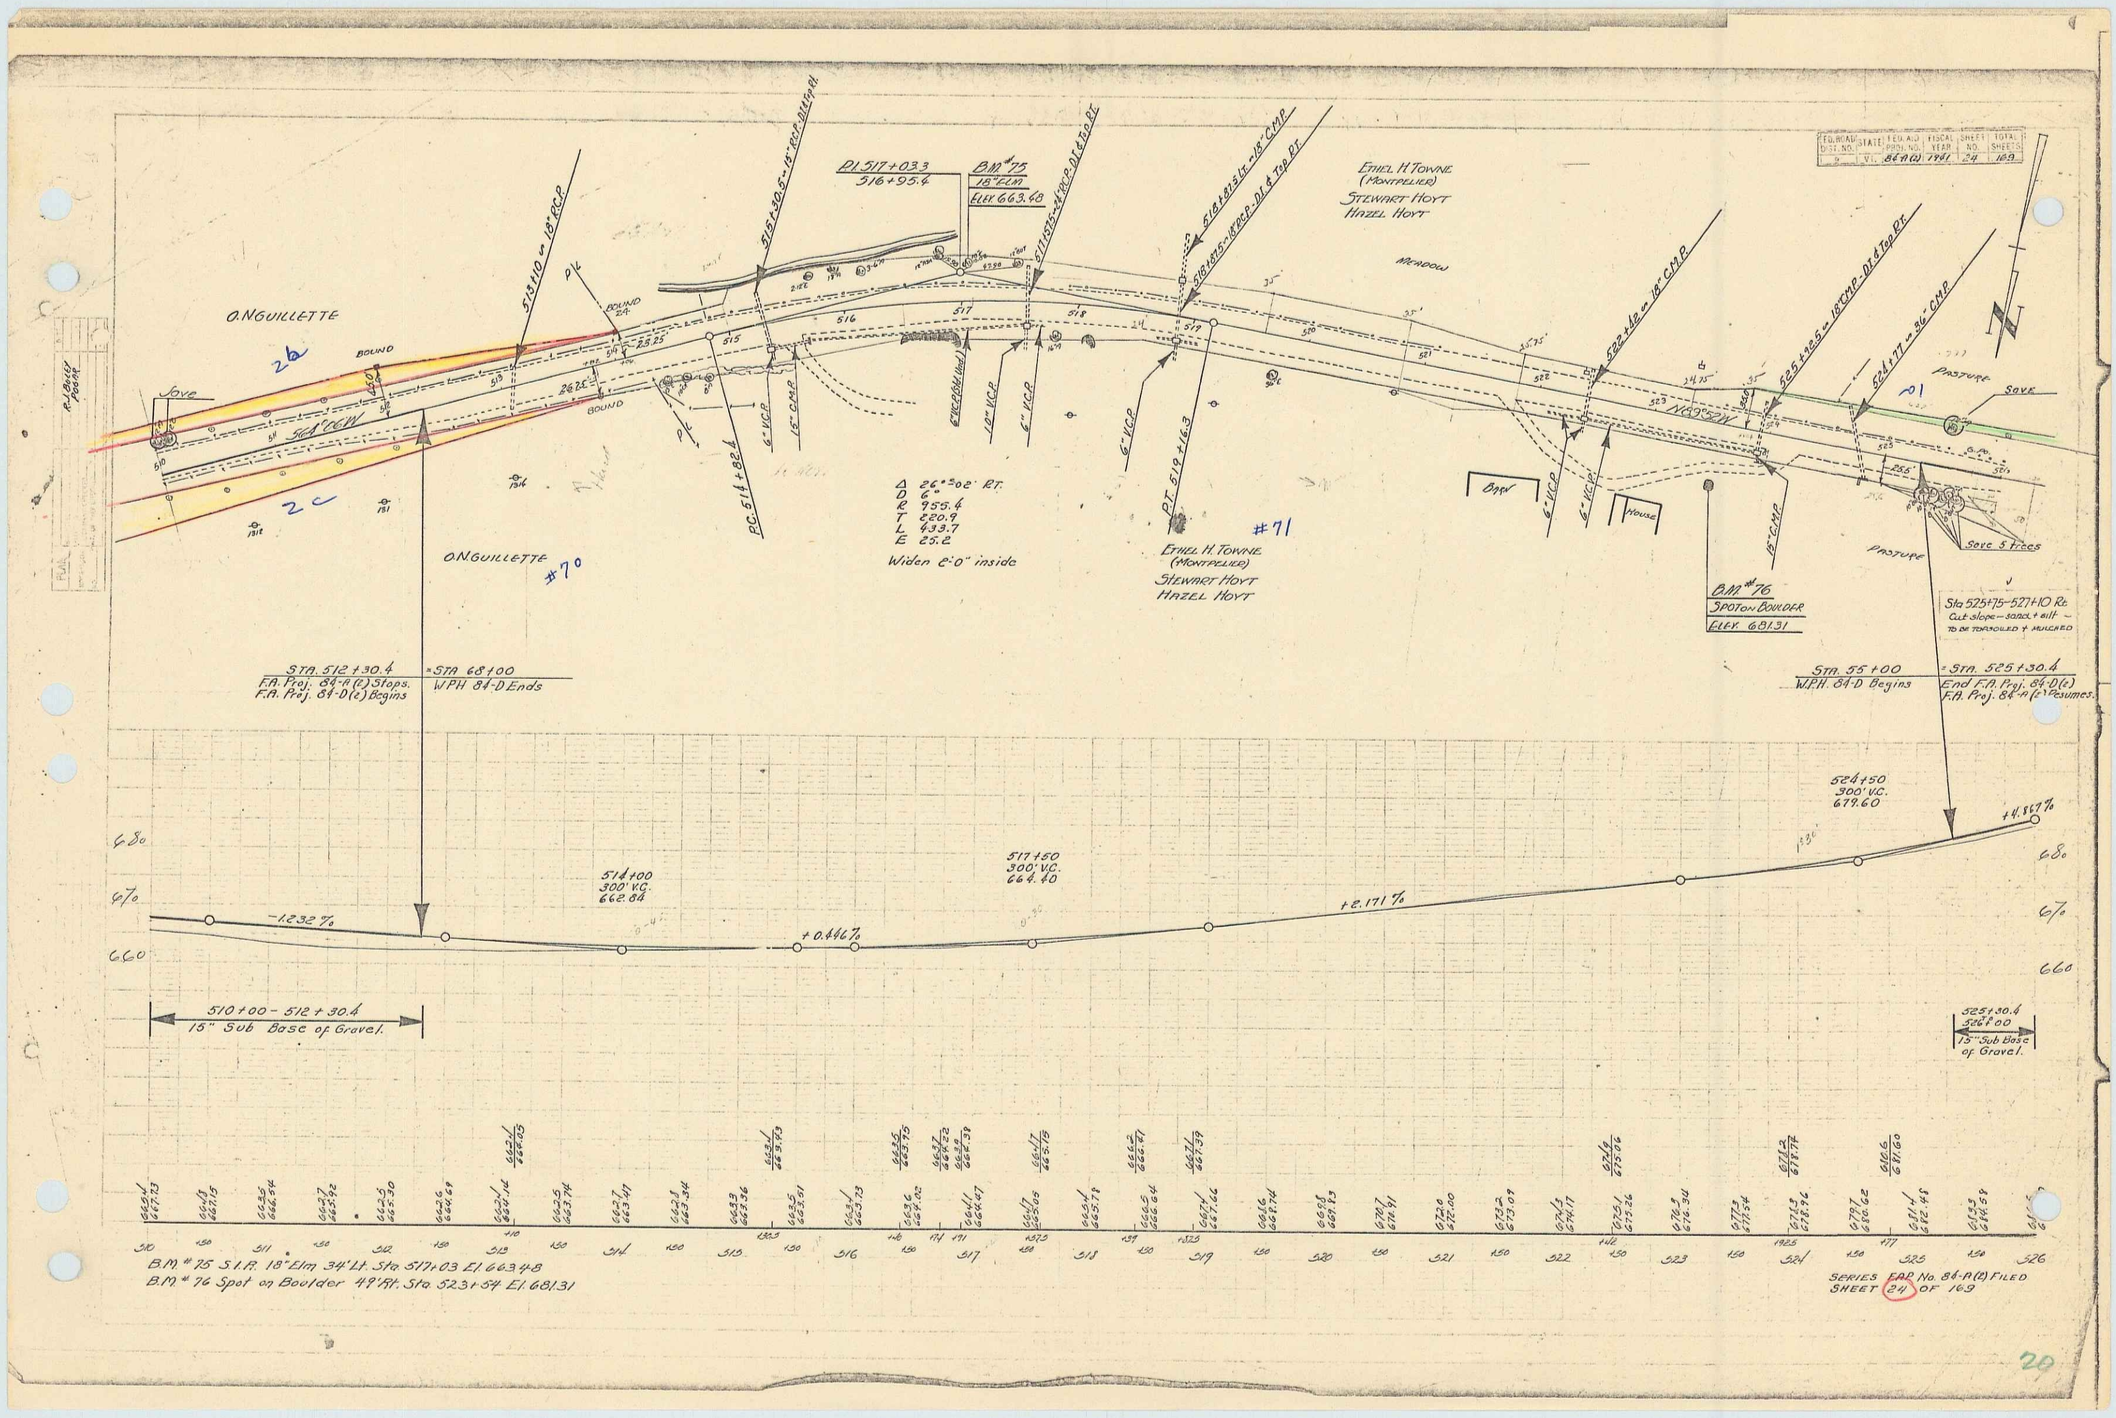
FED. ROAD DIST. NO. | STATE | FED. AID PROJ. NO. | FISCAL YEAR | SHEET NO. | TOTAL SHEETS
VT. | 84-D(2) | 1981 | 24 | 169
O.N. GUILLETTE
O.N. GUILLETTE #70
Pl 517+033
316+95.4
BM #75
18" CLM
ELEV 663.48
Δ 26°-50' RT.
D 6°
R 955.4
T 220.9
L 433.7
E 25.2
Widen 8'-0" inside
PC 514+82.4
PT 519+16.3
ETHEL H. TOWNE (MONTPELIER)
STEWART HOYT
HAZEL HOYT
#71
Meadow
Barn
House
BM #76
SPOT ON BOULDER
ELEV 681.31
Pasture
Save 5 Trees
Sta 525+75–527+10 Rt.
Cut slope – sand + silt –
TO BE TOPSOILED + MULCHED
Sta. 512+30.4
F.A. Proj. 84-A(2) Stops.
F.A. Proj. 84-D(2) Begins
Sta 68+00
WPH 84-D Ends
Sta. 55+00
W.P.H. 84-D Begins
Sta. 525+30.4
End F.A. Proj. 84-D(2)
F.A. Proj. 84-A(2) Resumes.
514+00
300' V.C.
662.84
517+50
300' V.C.
664.40
524+50
300' V.C.
679.60
-1.232%
+0.446%
+2.171%
+4.567%
510+00 – 512+30.4
15" Sub Base of Gravel.
525+30.4
526+00
15" Sub Base of Gravel.
B.M. #75 S.I.R. 18" Elm 34' Lt. Sta. 517+03 El. 663.48
B.M. #76 Spot on Boulder 49' Rt. Sta. 523+34 El. 681.31
SERIES FAP No. 84-A(2) FILED
SHEET 24 OF 169