INDEX OF SHEETS

SHEET NO. 1 TITLE PAGE
" " 2 TYPICAL CROSS-SECTION OF IMPROVEMENT — GRADING, DRAINAGE & BASE WITH GUARD RAIL & CONSTRUCTION COST OF REFINED TAR WITH PEA STONE SEAL. ITEM 29A
" " 3 PLAN AND PROFILE
" " 4 STANDARD STRUCTURE SHEET 3-30 GUARD RAIL
" " 5 " " " " 3-30A STD. UND. BOUNDARY MARKERS
" " 6 " " " " 3-40 BARRICADES SIGNS & LIGHTS
7-8 CROSS SECTION SHEETS

STANDARD STRUCTURE SHEETS APPROVED BY THE CHIEF ENGINEER
3-30 AUGUST 15, 1934

STATE OF VERMONT

STATE HIGHWAY DEPARTMENT

PLAN AND PROFILE OF PROPOSED STATE HIGHWAY

FEDERAL AID PROJECT

TOWN OF WOLCOTT

Pin # [redacted] Rte. VT15

HARDWICK — MORRISVILLE ROAD

BEGINNING AT A POINT ON ROUTE 15, 0.58 MI. NORTH-WESTERLY FROM THE ST. JOHNSBURY & LAKE CHAMPLAIN RAILROAD UNDERPASS AND EXTENDING NORTH-WESTERLY 0.056 MILES.
LENGTH OF PROJECT, 257.0 FT. = 0.048 MI.

FED. ROAD DIST. NO.	STATE	FED. AID PROJ. NO.	FISCAL YEAR	SHEET NO.	TOTAL SHEETS
9	VT.	84 C(2)	1941		8

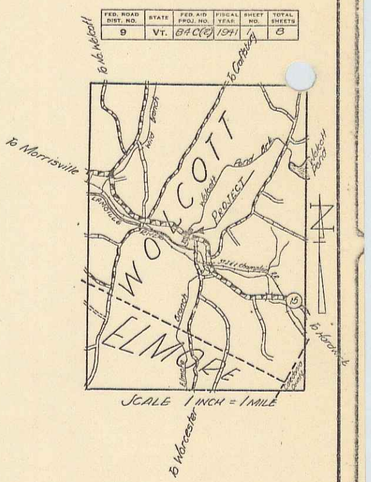

RECORD PLANS
By - G.A. Pierce

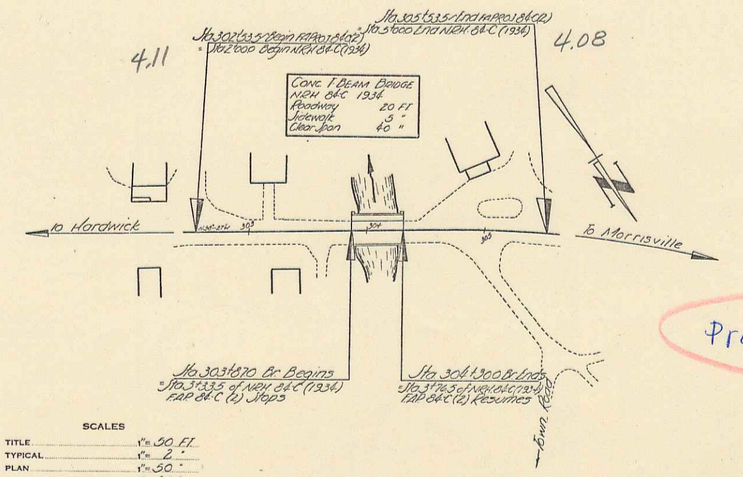

APPROVED: _____
COMMISSIONER OF HIGHWAYS

SUBMITTED BY ORDER OF THE STATE HIGHWAY BOARD

Project No. FAP 84-C(2)

RECOMMENDED FOR APPROVAL

DISTRICT ENGINEER
PUBLIC ROADS ADMINISTRATION
FEDERAL WORKS AGENCY

APPROVED

COMMISSIONER
PUBLIC ROADS ADMINISTRATION
FEDERAL WORKS AGENCY

THESE PLANS ARE SUBJECT TO SUCH REVISIONS AS MAY BE REQUIRED BY THE PUBLIC ROADS ADMINISTRATION OR THE COMMISSIONER OF HIGHWAYS.

CONSTRUCTION IS TO BE CARRIED ON IN ACCORDANCE WITH THE PLANS AND THE STANDARD ROAD AND BRIDGE SPECIFICATIONS OF 1936, AS APPROVED DECEMBER 29TH, 1936 BY THE PUBLIC ROADS ADMINISTRATION, INCLUDING ALL SUBSEQUENT APPROVED REVISIONS AND SUCH REVISED SPECIFICATIONS AND SPECIAL PROVISIONS AS ARE SUBMITTED WITH THE PLANS.

COUNTY LINE
TOWN LINE
FENCE LINE
STONE WALL
UNFENCED PROPERTY
GUARD RAIL
TRAVELED WAY
RAILROAD
RETAINING WALL
CENTER LINE
SURVEY LINE
CULVERT
DROP INLET
TROLLEY POLE
POWER POLE
TELEPHONE POLE
TREES
HEDGE

GROUND ELEVATION ..... DATUM ..... TRAV. LINE
GRADE ELEVATION ..... DATUM ..... PROF. LINE

CURVE DATA

DEFLECTION ANGLE ..... Δ
DEGREE OF CURVE ..... D.
RADIUS OF CURVE ..... R.
TANGENT DISTANCE ..... T.
LENGTH OF CURVE ..... L.
EXTERNAL DISTANCE ..... E.
POINT OF INTERSECTION ..... P. I.
POINT OF CURVE ..... P. C.
POINT OF TANGENT ..... P. T.
POINT ON TANGENT ..... P. O. T.

SCALES

TITLE	1" = 50 FT.
TYPICAL	1" = 2 "
PLAN	1" = 50 "
PROFILE HORIZONTAL	1" = 50 "
PROFILE VERTICAL	1" = 10 "
CROSS SECTIONS	1" = 5 "

RECORD PLANS
Wolcott - St. - FAP 84 C(2)
Contractor - Lambert & George
1941

APPROVED Nov 25 1940 G. W. Simonds ROAD ENGINEER	APPROVED Nov 21 1940 H. L. Parsons DISTRICT HIGHWAY COMMISSIONER	SERIES FAP No. 84 C(2) FILED SHEET 1 OF 8

MAP 4.12
RIGHT-OF-WAY DIVISION
TOWN FILE
PERPETUAL
Item of VT-15
(To Be Returned To R.O.W. Division)